

GRAFTON COUNTY ECONOMIC DEVELOPMENT COUNCIL

EDA GRANT #01-01-14168

ENTERPRISE CENTER at PLYMOUTH

149 MAIN STREET
PLYMOUTH, NEW HAMPSHIRE 03264



GENERAL NOTES

BUILDING CODE
1. ALL WORK PERFORMED BY THE CONTRACTOR AND ALL SUB-CRONTACTORS OF THIS PROJECT SHALL CONFORM TO THE REQUIREMENTS OF THE STATE OF NEW HAMPSHIRE BUILDING CODES (AND ANY AMENDMENTS), THE STATE OF NEW HAMPSHIRE LIFE SAFETY CODE (AND ANY AMENDMENTS), THE TOWN OF PLYMOUTH ZONING REGULATIONS, AND ALL OTHER REGULATIONS AND CODES.
2. ALL WORK TO COMPLY WITH ADA, ADASG, LOCAL, STATE & FEDERAL HANDICAPPED ACCESSIBILITY REQUIREMENTS.
CONTRACT & CONTRACT DRAWINGS
3. THE CONTRACT LIMIT HAS BEEN INDICATED ON THE DRAWINGS. IF NO LIMIT HAS BEEN INDICATED THEN THE OWNER, ARCHITECT & GENERAL CONTRACTOR SHOULD REVIEW ON-SITE PRIOR TO CONSTRUCTION.
4. THE CONTRACTOR SHALL FAMILIARIZE HIMSELF WITH THE CONTRACT DRAWINGS. ANY DISCREPANCIES SHALL BE BROUGHT TO THE ATTENTION OF THE ARCHITECT BEFORE PROCEEDING. THE CONTRACTOR SHALL BE SOLELY RESPONSIBLE FOR ANY AND ALL CONSTRUCTION MEANS, METHODS, TECHNIQUES, SEQUENCES, PROCEDURES, SHOPPING & SHORING PROGRAMS REQUIRED TO COMPLETE THE WORK OF THIS CONTRACT. PROVIDE ALL TEMPORARY BRACING & SHORING NECESSARY TO SAFELY MAINTAIN THE STRUCTURAL INTEGRITY OF NEW AND EXISTING CONSTRUCTION UNTIL ALL STRUCTURAL COMPONENTS AND SYSTEMS ARE INSTALLED & APPROVED BY THE OWNER OR ARCHITECT.
5. COORDINATION: THE STRUCTURAL, MECHANICAL, AND ELECTRICAL DRAWINGS ARE SUPPLEMENTARY TO THE ARCHITECTURAL DRAWINGS. IT SHALL BE THE RESPONSIBILITY OF THE CONTRACTOR TO CHECK AND COORDINATE ALL THE DRAWINGS BEFORE FABRICATION AND/OR INSTALLATION OF ANY WORK. CONTRACTOR SHALL IMMEDIATELY NOTIFY THE ARCHITECT OF ANY DISCREPANCIES OR ERRORS.
6. ALL STRUCTURAL DRAWINGS SHALL BE USED IN CONJUNCTION WITH THE SITE, ARCHITECTURAL, MECHANICAL, PLUMBING, AND ELECTRICAL DRAWINGS AND SPECIFICATIONS. VERIFY LOCATION AND DIMENSIONS OF CHASES, INSERTS, OPENINGS, SLEEVES, WASHES, DRIPS, REVEALS, DEPRESSIONS, AND OTHER PROJECT REQUIREMENTS NOT SHOWN ON THE STRUCTURAL DRAWINGS. VERIFY AND COORDINATE ALL DIMENSIONS RELATED TO THIS PROJECT.
7. SHOP DRAWINGS FOR REINFORCING STEEL (INCLUDING ALL ACCESSORIES), STRUCTURAL STEEL, CUSTOM STEEL CONNECTION ASSEMBLIES, AND BEAM AND JOIST HANGERS SHALL BE SUBMITTED TO THE ARCHITECT FOR REVIEW. A STAMPED APPROVAL SHALL BE RECEIVED BEFORE FABRICATION CAN PROCEED. SHOP DRAWINGS WHICH HAVE NOT BEEN REVIEWED AND APPROVED BY THE CONTRACTOR WILL BE RETURNED UNCHECKED TO THE CONTRACTOR FOR THEIR REVIEW AND APPROVAL. FAILURE TO SUBMIT SHOP DRAWINGS FOR THE REQUIRED MATERIALS SHALL RELIEVE THE SER OF RESPONSIBILITY AND LIABILITY FOR THOSE PARTS OF THE STRUCTURE AND ANY OTHER AFFECTED PART.
8. UNLESS OTHERWISE INDICATED, DETAILS SHOWN ARE TO BE CONSIDERED TYPICAL FOR SIMILAR CONDITIONS.
10. IF THERE EXISTS CONFLICTS BETWEEN THE WORK INDICATED IN ANY OF THE DRAWINGS; AND/OR ANY CONFLICTS WITHIN THE SPECIFICATIONS; AND/OR CONFLICTS BETWEEN THE DRAWINGS AND SPECIFICATIONS THE MORE COSTLY OF THE CONFLICTING ALTERNATIVES SHALL BE INCLUDED IN THE BID OR PROPOSAL.
11. THESE DRAWINGS HAVE BEEN COMPILED FROM THE BEST AVAILABLE INFORMATION AND ARE NOT INTENDED TO LIMIT THE SCOPE OF THE WORK. THE CONTRACTOR MAY ENCOUNTER HIDDEN OR UNDISCOVERED CONDITIONS NOT SHOWN ON THESE DRAWINGS, REQUIRING ADDITIONAL WORK FOR THE COMPLETION OF THIS CONTRACT. IT WILL BE ASSUMED THAT THE CONTRACTOR HAS INSPECTED THE SITE PRIOR TO BIDDING AND VERIFIED THE INFORMATION HEREIN SUPPLIED.
12. REFER TO THE SPECIFICATIONS IN THE PROJECT MANUAL FOR ADDITIONAL INFORMATION AND INSTRUCTIONS.
FIELD CONDITIONS
13. THE CONTRACTOR SHALL AT ALL TIMES PROTECT ALL WORK AND MATERIALS FROM DAMAGE DUE TO THE WEATHER. ALL WORK DAMAGED BY FAILURE TO PROVIDE PROPER PROTECTION SHALL BE REMOVED AND REPLACED AT THE CONTRACTOR'S EXPENSE.
14. FIELD VERIFICATION: PRIOR TO SCHEDULING OF WORK AND COMMENCING CONSTRUCTION, CONTRACTOR SHALL VERIFY ALL DIMENSIONS AND CONDITIONS SHOWN. CONTRACTOR SHALL NOTIFY THE ARCHITECT OF ANY OMISSIONS OF EQUIPMENT OR MATERIALS ON DRAWINGS.
15. PRIOR TO COMMENCEMENT OF THE WORK, THE CONTRACTOR SHALL RETAIN A LICENSED SURVEYOR TO STAKE OUT THE BUILDING LINES AND WORK REQUIRED UNDER THIS CONTRACT.
16. ALL EROSION AND SEDIMENTATION CONTROLS AS INDICATED IN THE CONTRACT DOCUMENTS MUST BE IN PLACE PRIOR TO THE START OF ANY EXTERIOR WORK. IF NO EROSION AND SEDIMENTATION CONTROLS ARE INDICATED THE CONTRACTOR IS TO INSTALL AND MAINTAIN E&S MEASURES AS PER LOCAL, STATE AND FEDERAL REQUIREMENTS. IF LOCAL, STATE, AND FEDERAL REQUIREMENTS ARE MORE STRINGENT THAN THE CONTROLS THOSE INDICATED IN THE CONTRACT DOCUMENTS THEN THE MORE STRINGENT PROCEDURES SHALL APPLY.
LEGEND & PRECEDENCE
17. LEGEND: ALL SYMBOLS AND ABBREVIATIONS USED ON THE DRAWINGS ARE CONSIDERED CONSTRUCTION STANDARDS. IF THE CONTRACTOR HAS ANY QUESTIONS REGARDING THE SAME OR THEIR EXACT MEANING, THE ARCHITECT SHALL BE NOTIFIED FOR CLARIFICATION.
18. PRECEDENCE: DIMENSIONS SHALL HAVE PRECEDENCE OVER SCALE. LARGER SCALE DRAWINGS HAVE PRECEDENCE OVER SMALLER SCALE DRAWINGS. SPECIFICATIONS AND GENERAL NOTES TAKE PRECEDENCE OVER DRAWINGS.
ADDITIONAL MISC. NOTES
19. DRAWING: CONTRACTOR SHALL PROVIDE ALL REQUIRED BLOCKING, BRACING, FRAMING, HANGERS, OR OTHER SUPPORT AS NECESSARY FOR ALL FIXTURES, EQUIPMENT, CABINETS, FURNISHINGS, AND ALL OTHER ITEMS REQUIRING THE SAME. IT IS THE CONTRACTOR'S RESPONSIBILITY TO COORDINATE WITH THE FIXTURES, EQUIPMENT, CABINETS, FURNISHINGS, AND ALL OTHER ITEMS. MEGR, AND INSTALLER AND REVIEW SHOP DRAWINGS FOR BRACING, UTILITIES CONNECTION, ETC.
20. ACCESS PANELS: ALL EQUIPMENT SWITCHES, AND VALVES THAT ARE CONCEALED MUST BE PROVIDED WITH ACCESS PANELS REGARDLESS WHETHER OR NOT THEY ARE INDICATED IN THE DRAWINGS.
21. GLASS: ALL GLASS AND GLASS INSTALLATIONS TO CONFORM TO CONSUMER SAFETY COMMISSION, PRODUCT SAFETY ACT AND ALL CODE REQUIREMENTS
22. NO NEW FACILITIES OR EQUIPMENT INTENDED FOR THE PERMANENT INSTALLATION MAY BE USED FOR TEMPORARY PURPOSES UNLESS THE CONTRACT DOCUMENTS SPECIFICALLY SPECIFIES THAT USE.
23. GYPSUM BOARD: CO-ORDINATE ALL GYPSUM BOARD WITH WALL SECTIONS. INSTALL MOISTURE RESISTANT GP, BO, BEHIND SINKS, IN TOILET, JANITOR, MECHANICAL ROOMS, AND OTHER POTENTIALLY DAMP LOCATIONS.
24. ALL PARTITIONS ARE DIMENSIONED FROM FACE OF PARTITION FINISH (OR FACE OF MASONRY) TO FACE OF PARTITION FINISH UNLESS NOTED OTHERWISE.
25. ALL ROUGH OPENINGS SHALL BE FIELD VERIFIED PRIOR TO MANUFACTURING OR ORDERING OF ALL DOOR, WINDOW, EQUIPMENT OR OTHER BUILDING PRODUCTS.
26. INSTALL RECESSED FIRE EXTINGUISHERS AT LOCATIONS DESIGNATED BY THE AGENCY HAVING JURISDICTION.

ABBREVIATIONS

Table with 2 columns: Abbreviation and Full Name. Includes entries like A/C ALT ALUM APPROX, BO BTU, CFM CLG CL, CMU CONC CO-ORD, DIA DIM DN D/W DWG, ELEC ELEV EQ EXIST EXT, FDN FF FFE FLASH FLR FT FTG, GALV GLZ GWP, HORIZ HZ, ID INSL INT, MAX MECH MFR MIN MSC, N/A NT, OC OP OPP, PERIM PLBG PLV PFD PT PVC, QTY, R REF RECP RE-REF REGR, SDRP SECT SIM SPEC SQ ST SPS SIL STOR, TEMP T&G TO, TYP, UNO, VENT VERT, W/ WC W/O WT.

CODE SUMMARY

NFPA 101-2012
Chapter 6-Classification of Occupancy
6.1.1.1 Business Occupancy: An occupancy used for the transaction of business other than mercantile.
Occupancy: Business: 9770/100sf (a) =98 people, Assembly: 595sf/15sf (a) =40 people = 138 people
Chapter 7-Means of Egress
7.1.3 Separation of means of egress
Exit access corridors do not require 1 hour separation in accordance with 7.1.3.6.(3) when fully sprinklered.
Exits (including stairs) shall be protected with 1 hour separation in accordance with 7.1.3.2.(1) (1) three or fewer stories.
7.1.4 Interior finish in exit enclosures
Wall and ceiling class A or B
Floor finish not less than class II
Headroom-ceiling 7' 6", stairs 6' 8"
7.1.5 Walking Surface in egress
Walking surfaces shall be uniformly slip resistant under foreseeable condition.
7.1.6 Doors: Minimum width to be 32"
Provided width calculated at level of discharge 158/2*2= 14" minimum.
Door swing can be against direction of travel, in all areas except on floor with intended assembly space, in accordance with 7.2.1.4.2, occupant load under 50.
7.2.2 Stairs: Minimum width 44; calculated width= 70*.3= 21" for stairs
Stair width provided= 56" (48" clear width) in accordance with area of refuge requirements, 7.2.1.2.3.
Walls within 10' of each stair unprotected openings to be 1hr construction, in accordance with 7.2.2.5.2.1.
Stair signage in accordance with 7.2.2.5.4.
Elevator landings to have two-way communication system for communication with central control point, in accordance with 7.2.1.2.1.2, with instructions posted adjacent to system
Table 7.3.1.2 Business: 100ftsq/person; Assembly: 15ftsq/person
Gross floor area / floor=9770(.has) / 100sf + 595f/15sf=138 occupants
Occupants/ floor=35 w/ o assembly; 68 w/ assembly
Minimum required egress= 70*.3= 21" for stairs, 158*.2=28 for all other components
7.4 Number of Means of Egress
Number of means of egress shall not be less than two, as per 7.4.1.1
7.5 Arrangement of Means of Egress
Corridors that are not required to be fire resistance rated shall be permitted to discharge into open floor plan areas, as per 7.5.1.2.2
Separation distance between exits must be 1/3 building diagonal, 27', in accordance with 7.5.1.3.3.
Two accessible means of egress will be provided in accordance with 7.5.4.1.
7.7.5 Exit/ Egress signage in accordance with 7.2.2.5.4
7.8 Exit/ Egress illumination in accordance with 7.8.1-7.8.2
7.9 Emergency lighting in accordance with 7.9.
7.10 Exit/ Egress marking in accordance with 7.10.
Chapter 8 Features of Fire Protection
8.1-8.7 Fire walls, barriers, penetrations and openings all in accordance with 8.1-8.7
8.7.1.1 Protection from any area having a degree of hazard greater than that normal to the occupancy to be protected by one of the following: (1) automatic extinguishing system
8.7.1.2 New construction with automatic extinguishing system without fire resistive separation to be enclosed with smoke partition in accordance with 8.4
Chapter 9 Building Services and Fire Protection Equipment
9.1-9.6 Fire protection, alarms and notification systems in accordance with 9.1-9.6
9.7 Building fully sprinklered with automatic system in accordance with
Ch85 New Business Occupancy
8.1.6 Minimum construction type-no minimum construction type
Construction type determined to be V-000, fully sprinklered (IBC equivalent V-0)
8.2.4.3 A single means of exit is permitted for occ. load under 100, and travel distance is less than 100'.
8.2.5 Common path of travel 100'; maximum dead end 50'
8.2.6 Maximum travel distance (with sprinkler) 500'
8.3.2.1 Hazardous areas including, but not limited to, areas used for boiler or furnace to be protected in accordance with 8.7
8.3.2.3 Travel distance to exit in sprinklered business class not to exceed 500'.
8.3.3.2.1 Class 'A' or 'B' interior wall finishes in exits and exit access corridors
8.3.3.2.2 Class 'A', 'B' or 'C' in all other areas
8.3.3.3.2 Interior exit enclosure floor finish to be Class I or II
8.3.3.6 (3) Exit access corridor shall not be separated from other areas where building is fully sprinklered.

CODE SUMMARY continued

IBC 2009
Chapter 5 USE AND OCCUPANCY
504.1 Business Group B
Chapter 5 GENERAL BUILDING HEIGHTS AND AREAS
Table 503 NH Modification
Business Building Type Five-B (VB) three story (with sprinkler increase) and 7200sf/ floor
Chapter 6 TYPES OF CONSTRUCTION
Table 601 Fire resistance rating for building element: VB= Chrs for primary structure, load bearing walls, non-load bearing interior walls, floor and secondary members, and roof and secondary members.
Table 602 Fire resistance exterior walls, 'B' occupancy; less than 50' separation requires one hour.
Chapter 7 FIRE AND SMOKE SEPERATION FEATURES
705.5 Fire resistance ratings: fire resistance rating of exterior walls with separation greater than 10' shall be rated for exposure to fire from the inside (only).
Table 705.8 Maximum area of exterior wall opening
North elevation: One hour separation, 10' to less than 15', unprotected/ sprinklered= 45% Actual= 98/ 2356= 4.1%
West elevation: One hour separation, no limit to unprotected openings
South elevation: no separation required
East elevation: One hour separation, no limit to unprotected openings
708.4 Elevator shaft enclosures requires two hour rating, as per 708.4, for shafts four or more stories.
Enclosed elevator lobbies are not required where building is protected throughout with automatic sprinkler system.
Table 715.4 Fire doors for shafts, exit enclosure and exit passageway of 1hr requires 1hr door.
Chapter 10 Means of Egress-superseded by NFPA 7and 98.
Chapter 11 Accessibility
1109.1(2) Sixty percent of entrances shall be accessible except loading and service entrances that are not the only entrance.


SHEET LIST

Table with 6 columns: Number, Sheet Name, Status, Issue Date, Revision 1 Issue, Revision 2 Issue. Lists sheets A.0.1 through A.9.1 and SK sheets.

Cobb Hill Construction, Inc
206 North State Street--Concord, NH 03301
603-224-8573tel 603-224-0375
Jerru Kinawill, President;
Claude Dupuis, Project Manager;
Charles Savage, Site Supervisor

FOR AS-BUILT PURPOSES ONLY
-DRAWINGS ARE ISSUED FOR CREATION OF AS-BUILT DRAWINGS ONLY
-DRAWINGS ISSUED WITHOUT 'RED-LINE' REVISION NOTATION MAY NOT BE CURRENT


PROJECT NAME & ADDRESS:
PLYMOUTH ENTERPRISE CENTER
Grafton County Economic Development Council
Plymouth, New Hampshire
COVER SHEET
A.O.I.

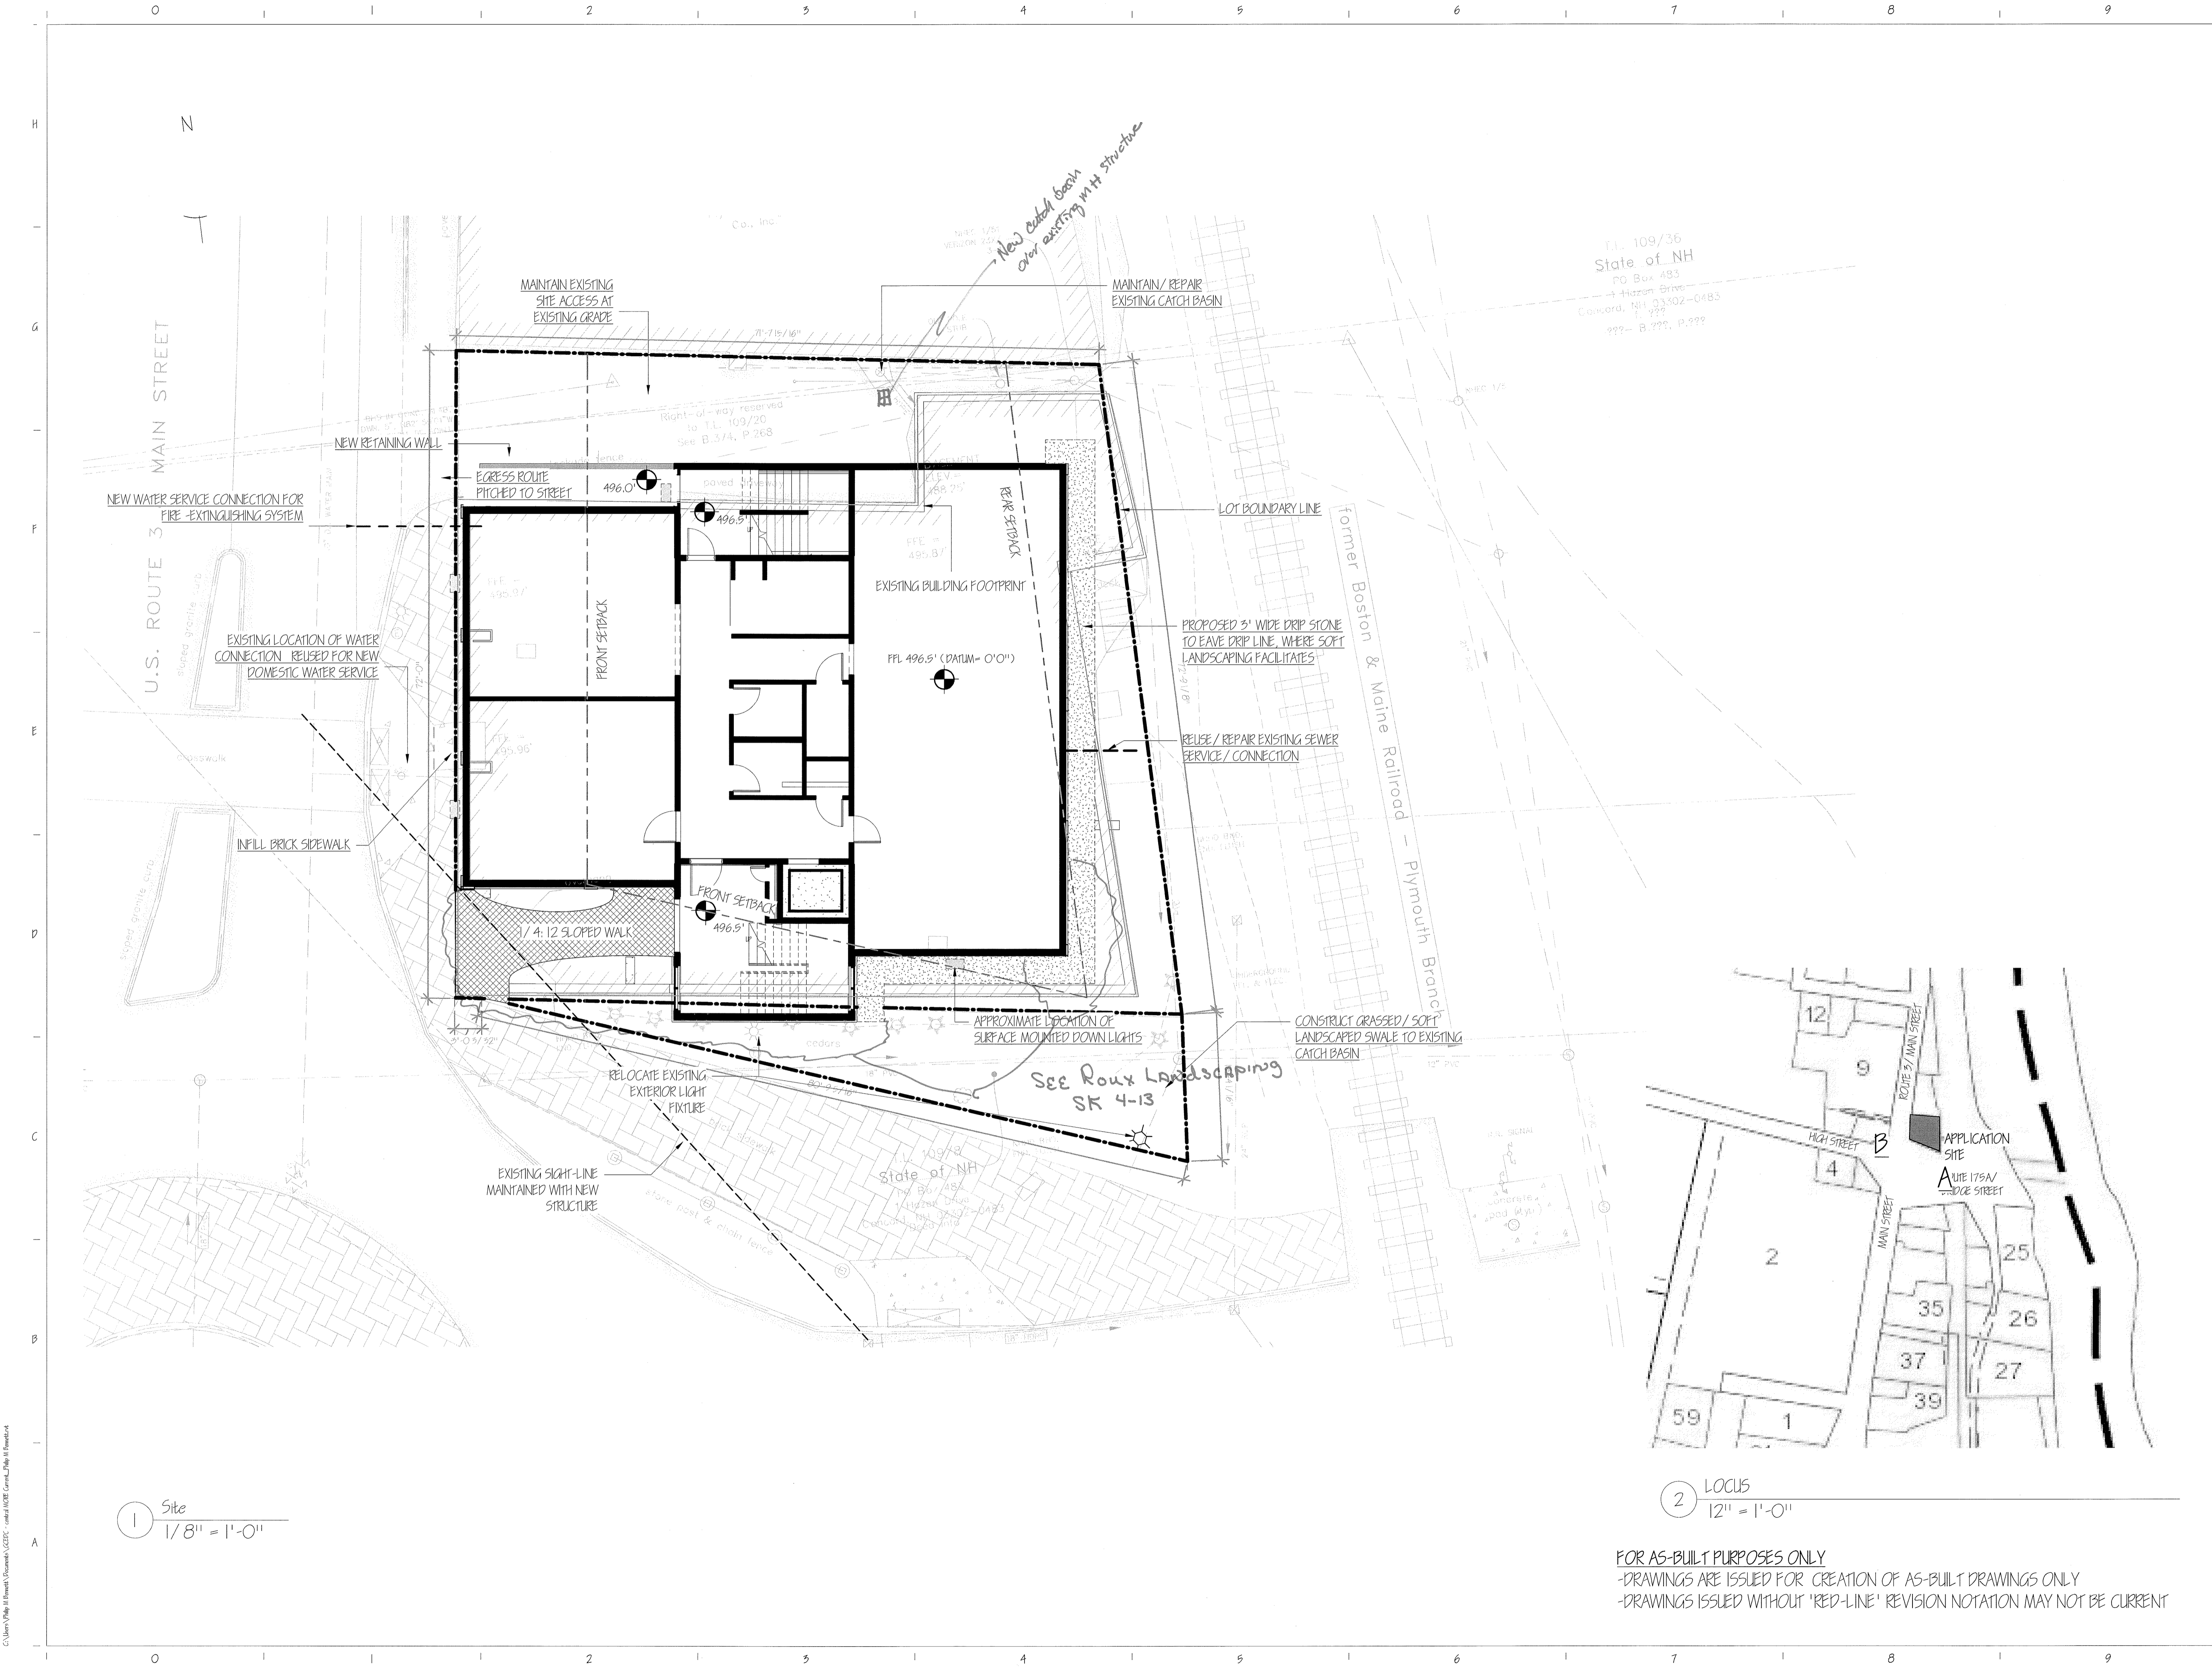

1 Site
1/8" = 1'-0"

2 LOCUS
12" = 1'-0"

FOR AS-BUILT PURPOSES ONLY
-DRAWINGS ARE ISSUED FOR CREATION OF AS-BUILT DRAWINGS ONLY
-DRAWINGS ISSUED WITHOUT 'RED-LINE' REVISION NOTATION MAY NOT BE CURRENT

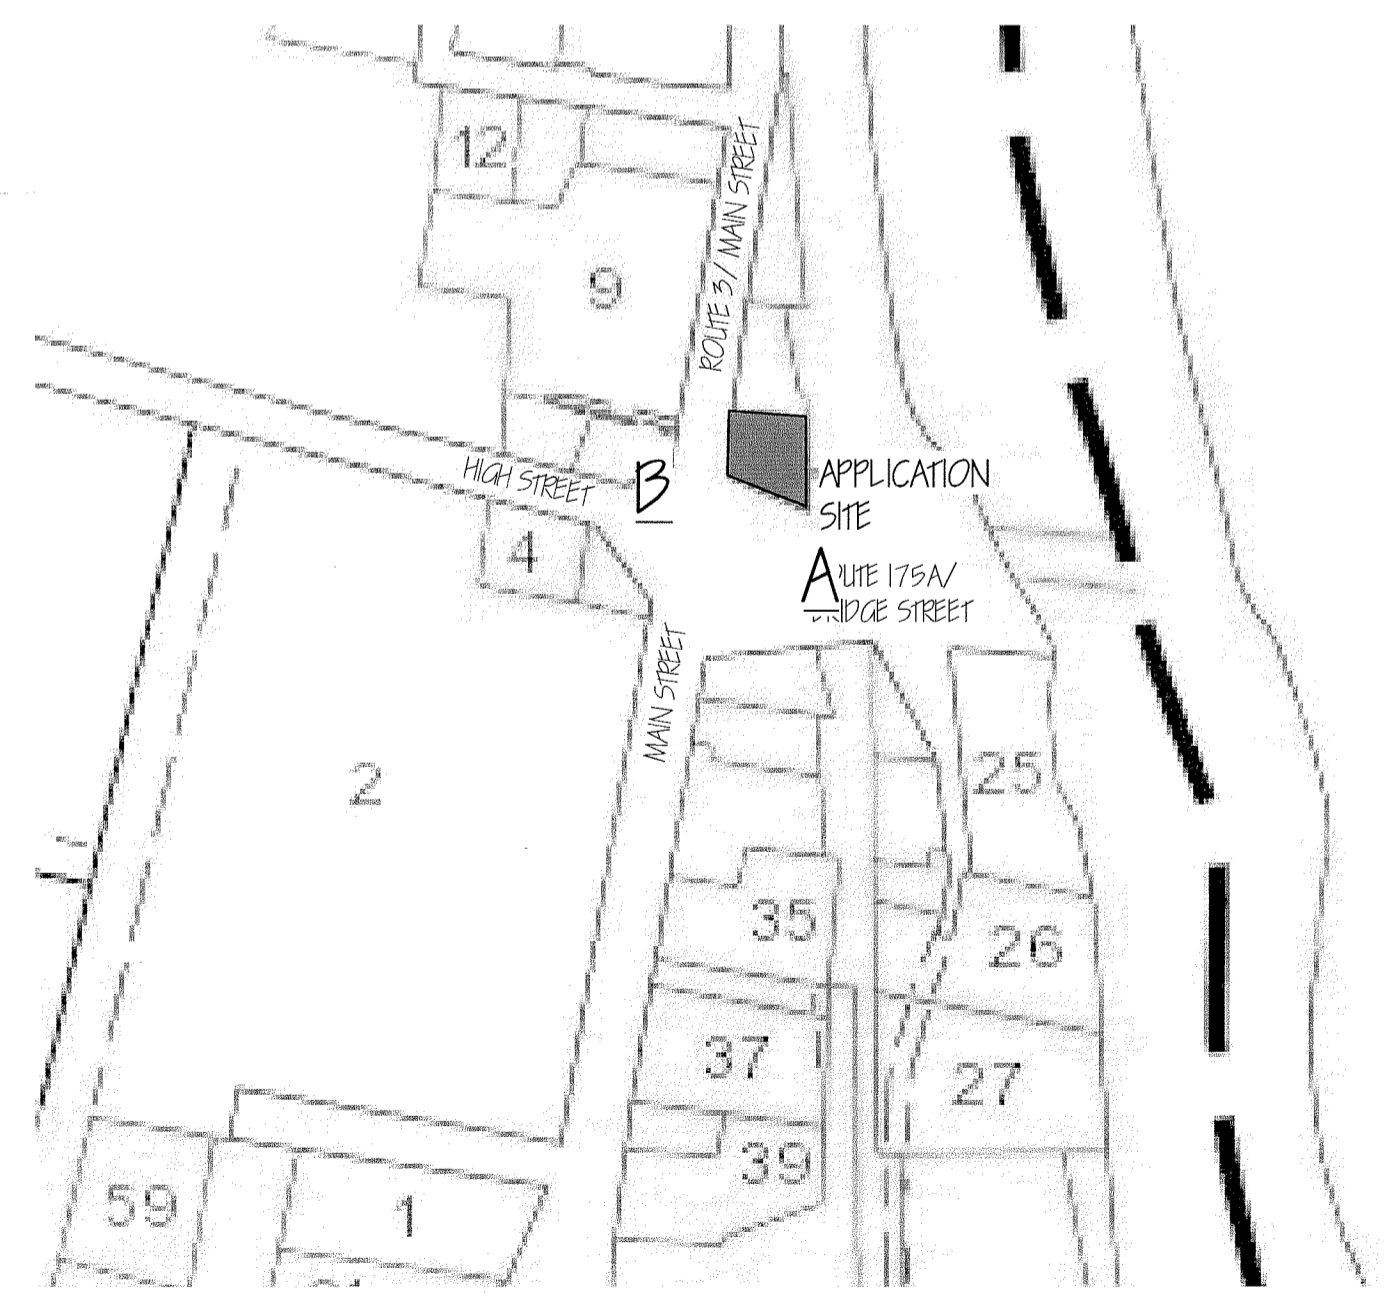

OWNER / APPLICANT
GRAFTON COUNTY ECONOMIC DEVELOPMENT CORPORATION
PO BOX 178
PLYMOUTH, NH 03264

OWNER REP.
STEVE WHELOCK
GRAFTON COUNTY ECONOMIC DEVELOPMENT CORPORATION
PO BOX 178
PLYMOUTH, NH 03264

GEN. CONTRACTOR / CONSULTANTS
CORB-HILL CONSTRUCTION INC.
206 N. STATE STREET,
CONCORD, NH 03301

ALBA ARCHITECTS LLP
197 MAIN STREET
NORTH WOODSTOCK, NH 03262

HEB (STRUCTURAL) ENGINEERS
2605 WHITE MOUNTAIN HIGHWAY
PO Box 440
NORTH CONWAY, NH 03860


HEB (CIVIL) ENGINEERS
2605 WHITE MOUNTAIN HIGHWAY
PO Box 440
NORTH CONWAY, NH 03860

HEB (SURVEY) ENGINEERS
2605 WHITE MOUNTAIN HIGHWAY
PO Box 440
NORTH CONWAY, NH 03860

PROJECT NAME & ADDRESS:
PLYMOUTH ENTERPRISE CENTER
Grafton County Economic Development Council
Plymouth, New Hampshire

A03

SITE PLAN

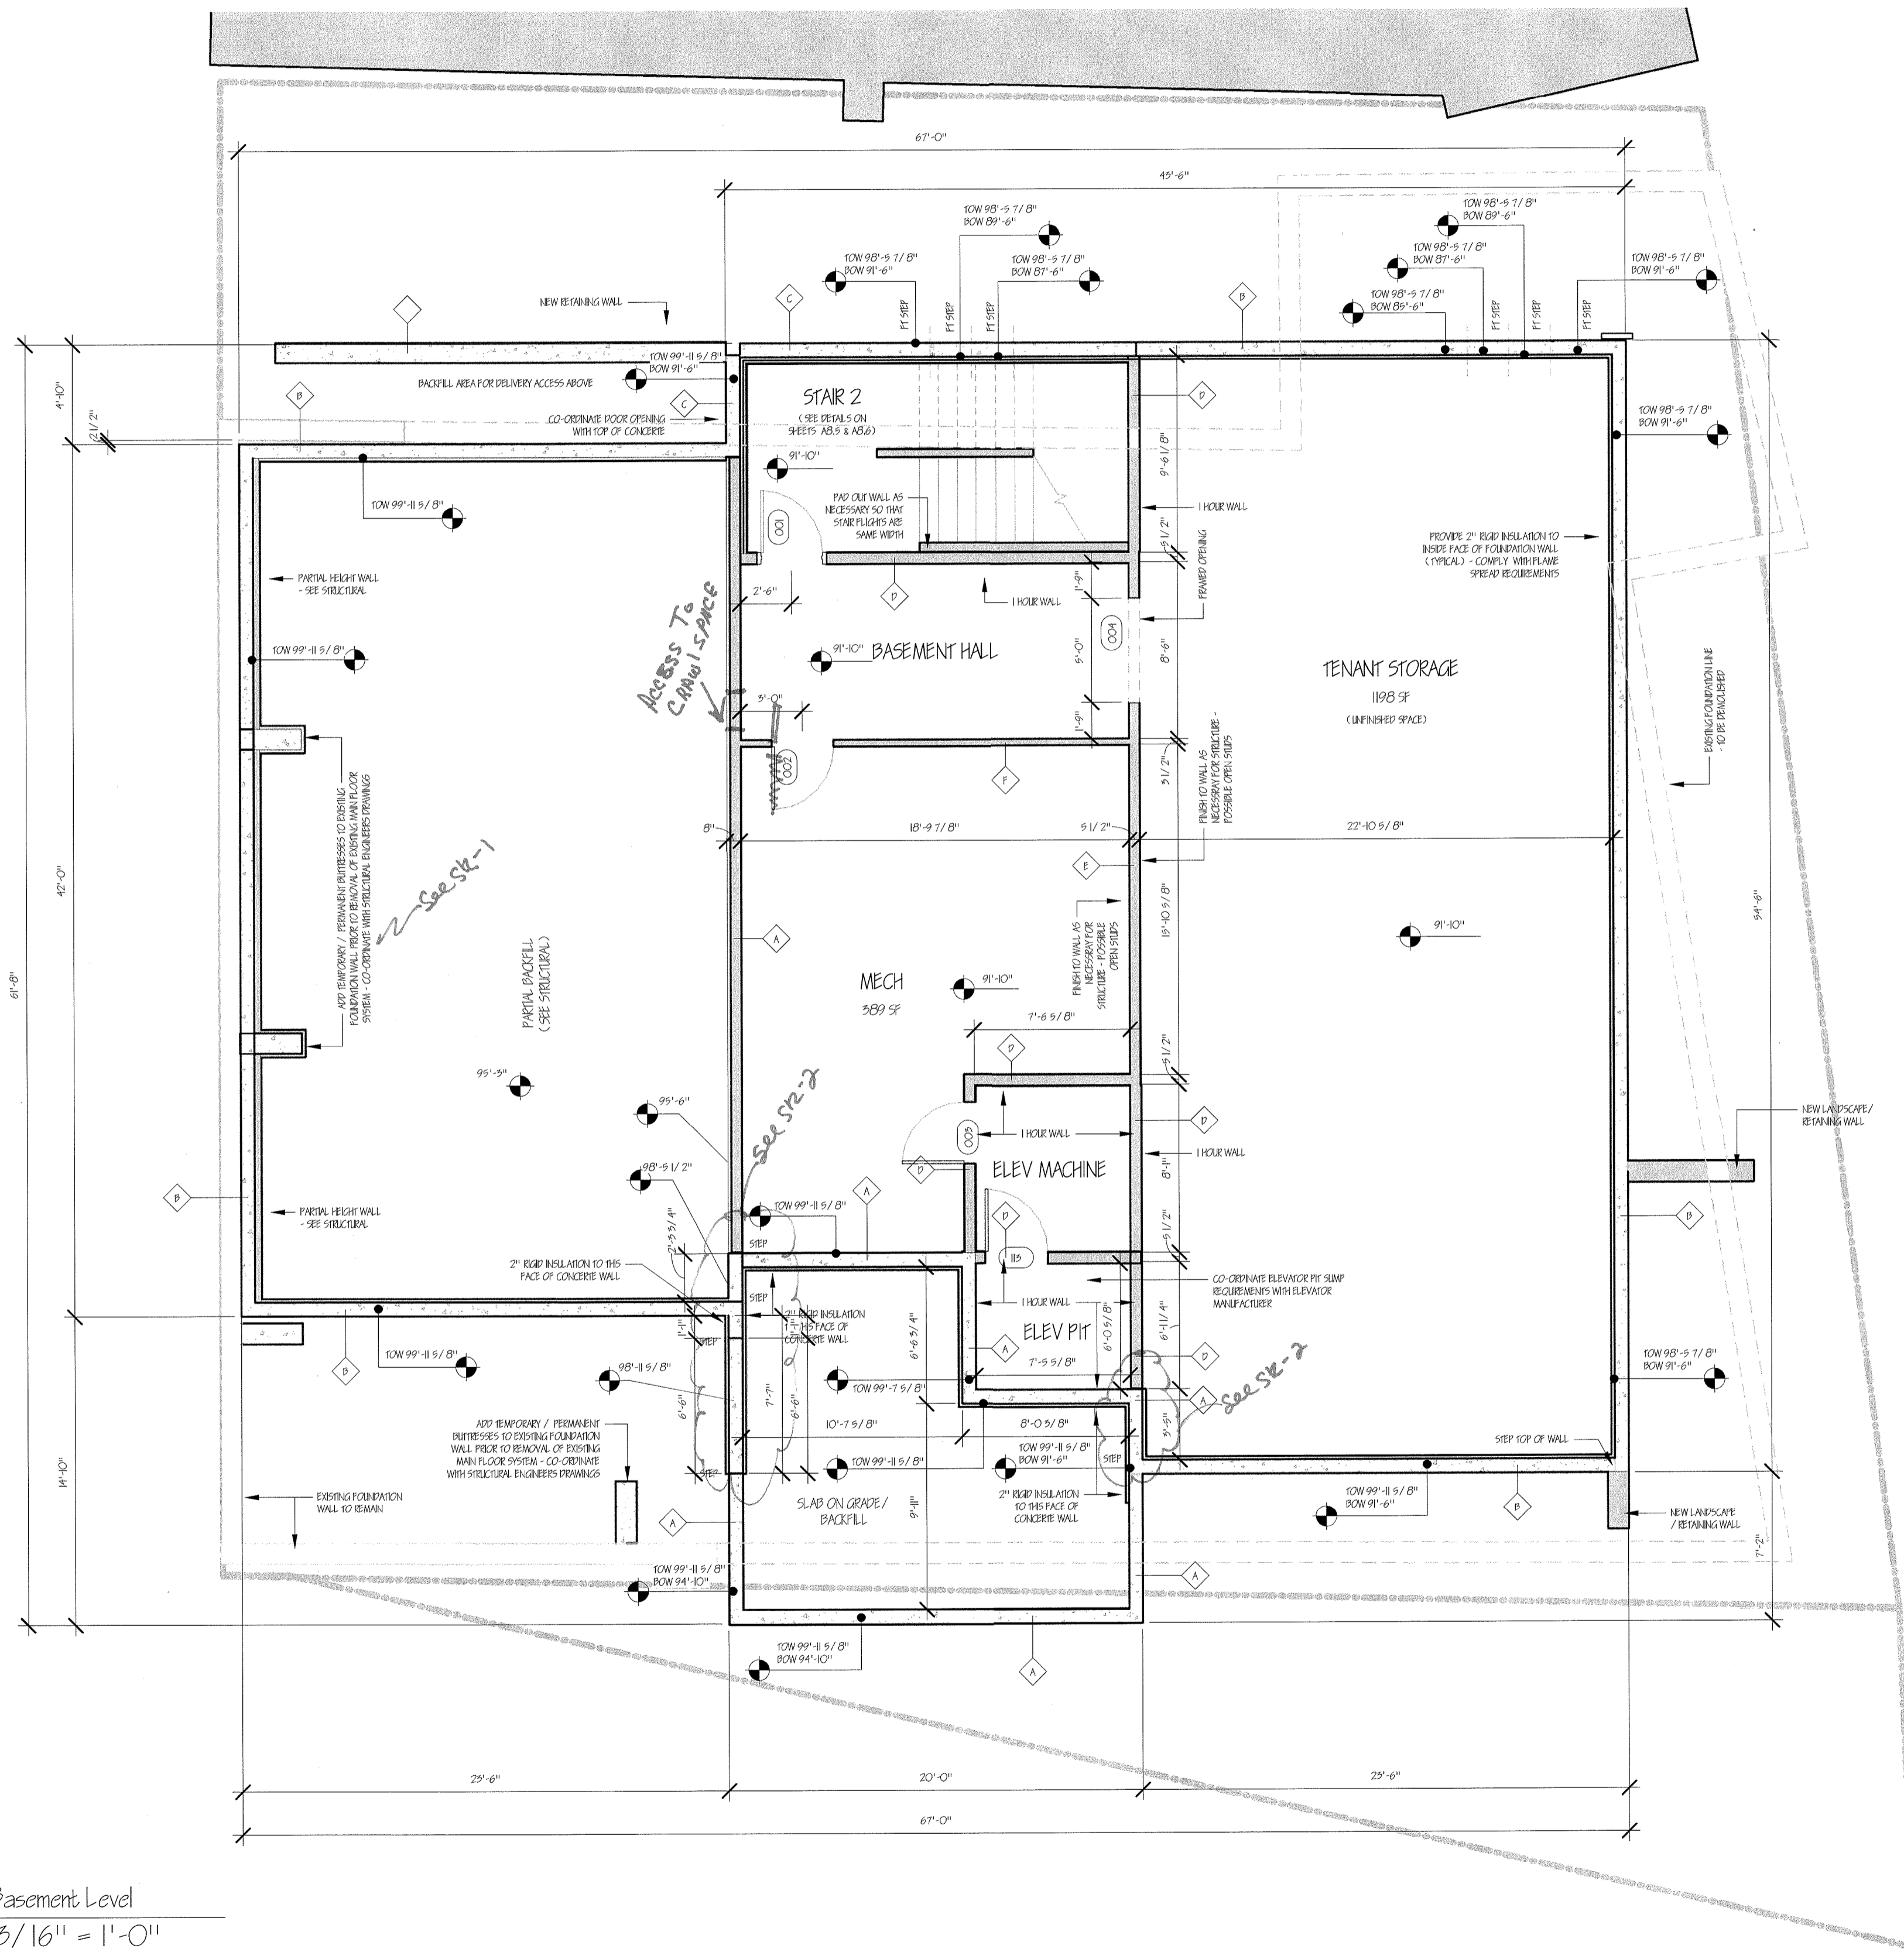

1 Basement Level
 3/16" = 1'-0"


FOR AS-BUILT PURPOSES ONLY
 -DRAWINGS ARE ISSUED FOR CREATION OF AS-BUILT DRAWINGS ONLY
 -DRAWINGS ISSUED WITHOUT 'RED-LINE' REVISION NOTATION MAY NOT BE CURRENT

- GENERAL NOTES:**
- BUILDING CODE:**
1. ALL WORK PERFORMED BY THE CONTRACTOR AND ALL SUB-CONTRACTORS OF THIS PROJECT SHALL CONFORM TO THE REQUIREMENTS OF THE STATE OF NEW HAMPSHIRE BUILDING CODES (AND ANY AMENDMENTS), THE STATE OF NEW HAMPSHIRE LIFE SAFETY CODE (AND ANY AMENDMENTS), THE TOWN OF WOODSTOCK ZONING REGULATIONS, AND ALL OTHER REGULATIONS AND CODES.
 2. ALL WORK TO CONFORM WITH ADA, ADAG, LOCAL, STATE & FEDERAL HANDICAPPED ACCESSIBILITY REQUIREMENTS.
- CONTRACT & CONTRACT DRAWINGS:**
3. THE CONTRACT LIMIT HAS BEEN INDICATED ON THE DRAWINGS. IF NOT LIMITED BY THE CONTRACT, THE OWNER, ARCHITECT & GENERAL CONTRACTOR SHALL REVIEW ON-SITE PRIOR TO CONSTRUCTION.
 4. THE CONTRACTOR SHALL FAMILIARIZE HIMSELF WITH THE CONTRACT DRAWINGS AND SPECIFICATIONS. HE SHALL BE RESPONSIBLE TO THE ARCHITECT BEFORE PROCEEDING. THE CONTRACTOR SHALL BE SOLELY RESPONSIBLE FOR ANY AND ALL CONSTRUCTION MEANS, METHODS, TECHNIQUES, SEQUENCES, PROCEDURES, SCHEDULING & SAFETY PROGRAMS REQUIRED TO COMPLETE THE WORK OF THIS CONTRACT. PROVIDE ALL TEMPORARY BRACING & SHORING NECESSARY TO SAFELY MAINTAIN THE STRUCTURAL INTEGRITY OF NEW AND EXISTING CONSTRUCTION. ALL STRUCTURAL COMPONENTS AND SYSTEMS ARE INSTALLED & APPROVED BY THE OWNER OR ARCHITECT.
 5. COORDINATION OF THE STRUCTURAL, MECHANICAL, AND ELECTRICAL DRAWINGS ARE SUPPLEMENTARY TO THE ARCHITECTURAL DRAWINGS. IT SHALL BE THE RESPONSIBILITY OF THE CONTRACTOR TO CHECK FOR CONFLICTS. ALL THE DRAWINGS BEFORE PARTICULAR AND/OR INSTALLATION OF ANY WORK. CONTRACTOR SHALL IMMEDIATELY NOTIFY THE ARCHITECT OF ANY CONFLICTS OR ERRORS.
 6. ALL STRUCTURAL DRAWINGS SHALL BE USED IN CONJUNCTION WITH THE ARCHITECTURAL, MECHANICAL, PLUMBING, AND ELECTRICAL DRAWINGS AND SPECIFICATIONS. THE CONTRACTOR SHALL VERIFY LOCATION AND DIMENSIONS OF CHASES, INSERTS, SLEEVES, WELDS, FITS, DETAILS, PENETRATIONS, AND OTHER PROJECT REQUIREMENTS NOT SHOWN ON THE STRUCTURAL DRAWINGS. VERIFY AND COORDINATE ALL DIMENSIONS RELATED TO THIS PROJECT.
 7. UNLESS OTHERWISE INDICATED, DETAILS SHOWN ARE TO BE CONSIDERED TYPICAL FOR SIMILAR CONDITIONS.
 8. IF THERE ARE CONFLICTS BETWEEN THE WORK INDICATED IN ANY OF THE DRAWINGS AND/OR ANY CONFLICTS WITHIN THE SPECIFICATIONS, MEET OR CONFLICTS WITHIN THE DRAWINGS AND SPECIFICATIONS, THE MORE CORRECT OF THE CONFLICTING ALTERNATIVES SHALL BE INCLUDED IN THE BID OR PROPOSAL.
 9. REFER TO THE SPECIFICATIONS IN THE PROJECT MANUAL FOR ADDITIONAL INFORMATION AND INSTRUCTIONS.
- LEGEND & PRECEDENCE:**
10. LEGEND: ALL SYMBOLS AND ABBREVIATIONS DEEP ON THE DRAWINGS ARE CONSIDERED CONTRACT DOCUMENTS. IF THE CONTRACTOR HAS ANY QUESTIONS REGARDING THE SAME OR THEIR EXACT MEANING, THE ARCHITECT SHALL BE NOTIFIED FOR CLARIFICATION.
 11. PRECEDENCE: DIMENSIONS SHALL HAVE PRECEDENCE OVER SCALE. LARGER SCALE DRAWINGS HAVE PRECEDENCE OVER SMALLER SCALE DRAWINGS. SPECIFICATIONS AND GENERAL NOTES HAVE PRECEDENCE OVER DRAWINGS.
- ADDITIONAL MISC. NOTES:**
12. ACCESS PANELS: ALL EQUIPMENT SWITCHES AND VALVES THAT ARE CONCEALED MUST BE PROVIDED WITH ACCESS PANELS UNLESS OTHERWISE NOTED OR NOT INDICATED IN THE DRAWINGS.
 13. GLASS: ALL GLASS AND GLASS INSTALLATIONS TO CONFORM TO CONSUMER SAFETY COMMERCIAL PRODUCT SAFETY ACT AND ALL CODE REQUIREMENTS.
 14. NO NEW FACILITIES OR EQUIPMENT INTENDED FOR THE PERMANENT INSTALLATION MAY BE USED FOR TEMPORARY PURPOSES UNLESS THE CONTRACT DOCUMENTS SPECIFICALLY PERMITS THAT USE.
 15. ALL REPAIRS SHALL BE FIELD VERIFIED PRIOR TO MANUFACTURING OR ORDERING OF ALL FLOOR, WINDOW, EQUIPMENT OR OTHER BUILDING PRODUCTS.
 16. FIRE EXTINGUISHERS SHALL BE INSTALLED IN ACCORDANCE WITH NFPA 10, STANDARD FOR PORTABLE FIRE EXTINGUISHERS.
 17. EMERGENCY LIGHTING TO BE PROVIDED IN ACCORDANCE WITH NFPA.
 18. EMBE BUILDING TO BE SPANNLED IN ACCORDANCE WITH NFPA 10, STANDARD FOR PORTABLE FIRE EXTINGUISHERS.

PROJECT NAME & ADDRESS:
 PLYMOUTH ENTERPRISE CENTER
 Greater County Economic Development Council
 Plymouth, New Hampshire

A.I.O.

BASEMENT FLOOR PLAN

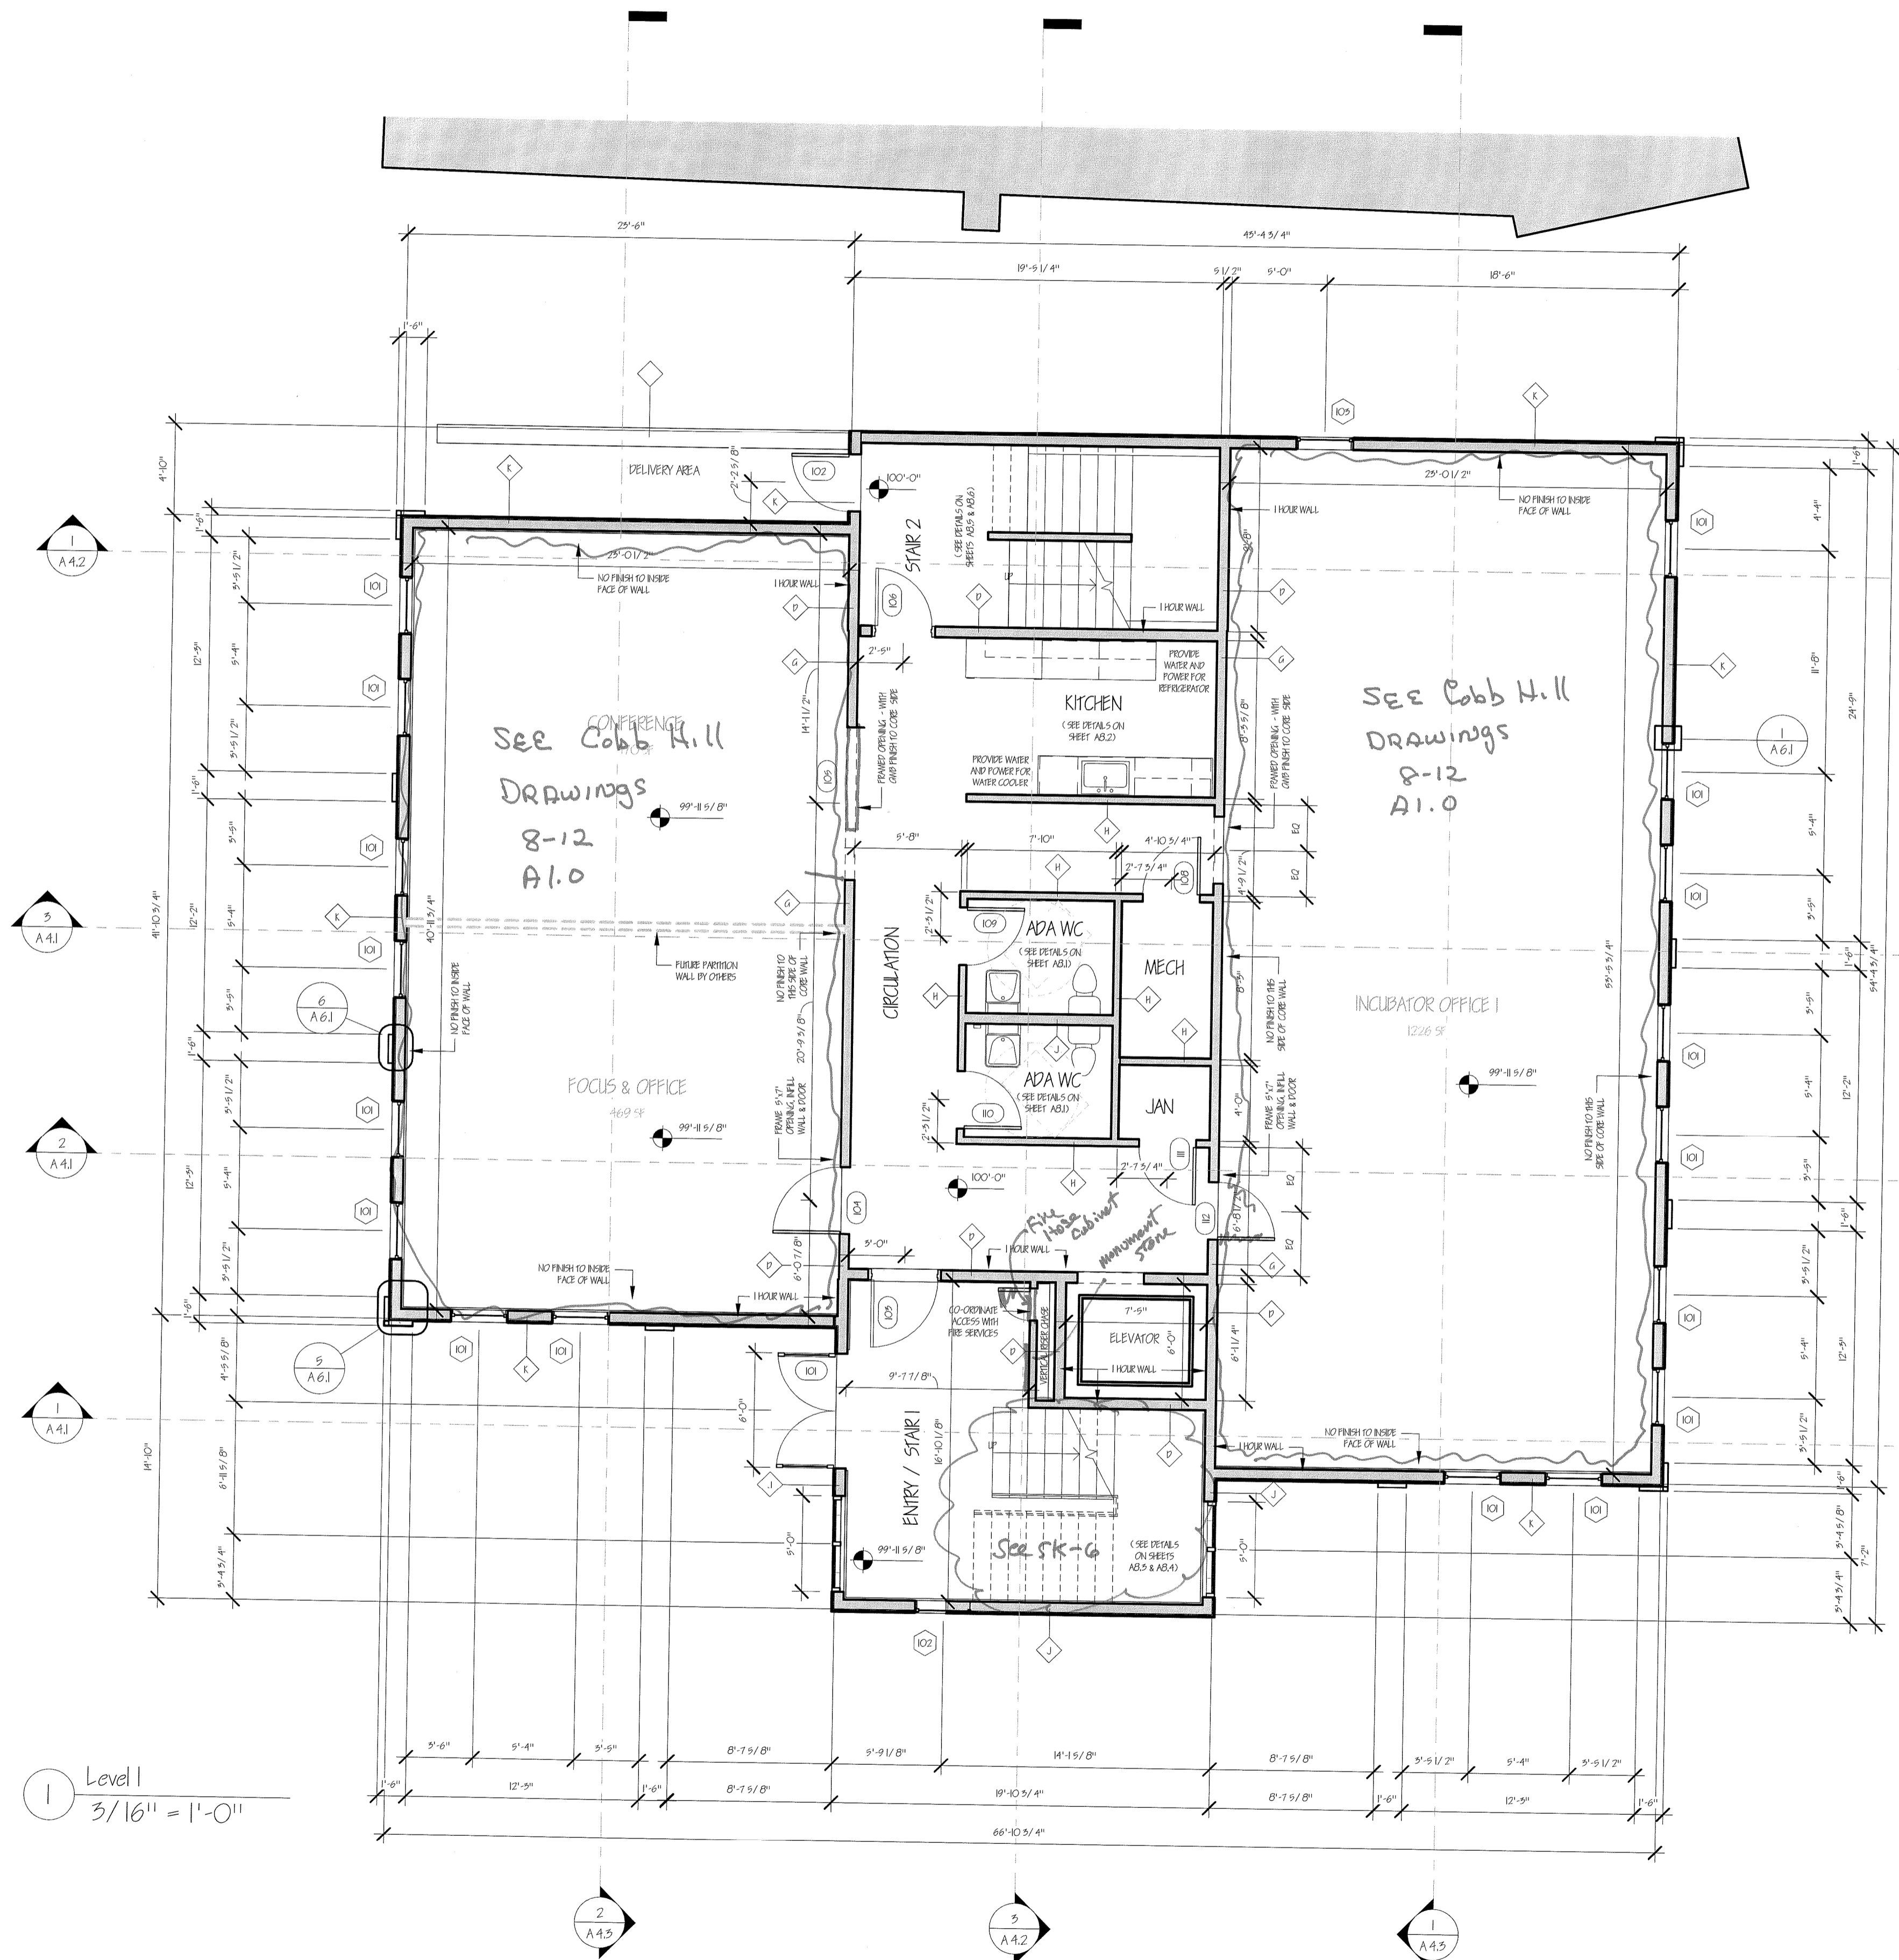

1 Level
 3/16" = 1'-0"

FOR AS-BUILT PURPOSES ONLY
 -DRAWINGS ARE ISSUED FOR CREATION OF AS-BUILT DRAWINGS ONLY
 -DRAWINGS ISSUED WITHOUT 'RED-LINE' REVISION NOTATION MAY NOT BE CURRENT


GENERAL NOTES:

- BUILDING CODE**
1. ALL WORK PERFORMED BY THE CONTRACTOR AND ALL SUB-CONTRACTORS OF THE PROJECT SHALL CONFORM TO THE REQUIREMENTS OF THE STATE OF NEW HAMPSHIRE BUILDING CODES AND ANY AMENDMENTS, THE STATE OF NEW HAMPSHIRE LIFE SAFETY CODE (AND ANY AMENDMENTS), THE TOWN OF WOODSTOCK ZONING REGULATIONS, AND ALL OTHER REGULATIONS AND CODES.
 2. ALL WORK TO COMPLY WITH NFA, ANNA, LOCAL, STATE & FEDERAL HANDICAPPED ACCESSIBILITY REQUIREMENTS.
- CONTRACT & CONTRACT DRAWINGS**
3. THE CONTRACTOR HAS BEEN ADVISED ON THE DRAWINGS, IF NOT ALREADY INDICATED BY THE OWNER, ARCHITECT & GENERAL CONTRACTOR SHOULD REVIEW ON-SITE PRIOR TO CONSTRUCTION.
 4. THE CONTRACTOR SHALL FAMILIARIZE HIMSELF WITH THE CONTRACT DRAWINGS AND SPECIFICATIONS SHALL BE PROVIDED TO THE ARCHITECT PRIOR TO PROCEEDING. THE CONTRACTOR SHALL BE SOLELY RESPONSIBLE FOR ANY AND ALL CONSTRUCTION METHODS, MEANS, PROCEDURES, SEQUENCES, PROCEDURES, SCHEDULING & SAFETY PROGRAMS REQUIRED TO COMPLETE THE WORK OF THE CONTRACT. PROVIDE ALL TEMPORARY BRACING & SHORING NECESSARY TO SAFELY MAINTAIN THE STRUCTURAL INTEGRITY OF NEW AND EXISTING CONSTRUCTION UNTIL ALL STRUCTURAL COMPONENTS AND SYSTEMS ARE INSTALLED & APPROVED BY THE OWNER OR ARCHITECT.
 5. COORDINATION: THE STRUCTURAL, MECHANICAL, AND ELECTRICAL DRAWINGS ARE SUPPLEMENTARY TO THE ARCHITECTURAL DRAWINGS. IT SHALL BE THE RESPONSIBILITY OF THE CONTRACTOR TO CHECK AND COORDINATE ALL THE DRAWINGS BEFORE FABRICATING OR INSTALLATION OF ANY WORK. CONTRACTOR SHALL IMMEDIATELY NOTIFY THE ARCHITECT OF ANY DISCREPANCIES OR CONFLICTS.
 6. ALL STRUCTURAL DRAWINGS SHALL BE USED IN CONJUNCTION WITH THE ARCHITECTURAL, MECHANICAL, PLUMBING AND ELECTRICAL DRAWINGS AND SPECIFICATIONS. VERIFY LOCATION AND DIMENSIONS OF CHIMNEYS, HATCHES, OPENINGS, SLEEVES, AND PENETRATIONS, REPAIRS, REVISIONS, AND OTHER PROJECT REQUIREMENTS NOT SHOWN ON THE STRUCTURAL DRAWINGS. VERIFY AND COORDINATE ALL DIMENSIONS RELATING TO THIS PROJECT.
 7. UNLESS OTHERWISE INDICATED, DETAILS SHOWN ARE TO BE CONSIDERED TYPICAL FOR SIMILAR CONDITIONS.
 8. IF THERE ARE CONFLICTS BETWEEN THE WORK INDICATED IN ANY OF THE DRAWINGS AND/OR ANY CONFLICTS BETWEEN THE SPECIFICATIONS AND/OR CONFLICTS BETWEEN THE DRAWINGS AND SPECIFICATIONS, THE MORE DETAILED OF THE CONFLICTING CONDITIONS SHALL BE FOLLOWED IN THE FIELD OF CONSTRUCTION.
 9. REFER TO THE SPECIFICATIONS IN THE PROJECT MANUAL FOR ADDITIONAL INFORMATION AND INSTRUCTIONS.
- LEGEND & PREFERENCE**
10. LEGEND: ALL SYMBOLS AND ABBREVIATIONS USED ON THE DRAWINGS ARE GOVERNED BY CONSTRUCTION STANDARDS. IF THE CONTRACTOR HAS ANY QUESTIONS REGARDING THE SAME OR THEIR EXACT MEANING, THE ARCHITECT SHALL BE NOTIFIED FOR CLARIFICATION.
 11. PREFERENCE: DIMENSIONS SHALL HAVE PRECEDENCE OVER SCALE. LARGER SCALE DRAWINGS HAVE PRECEDENCE OVER SMALLER SCALE DRAWINGS. SPECIFICATIONS AND GENERAL NOTES HAVE PRECEDENCE OVER DRAWINGS.
- ADDITIONAL SPEC. NOTES**
12. ACCESS PANELS: ALL EQUIPMENT SWITCHES AND VALVES THAT ARE CONCEALED MUST BE PROVIDED WITH ACCESS PANELS REQUIRING A KEY OR TOOL TO BE REMOVED IN THE DRAWINGS.
 13. GLASS: ALL GLASS AND GLASS INSULATIONS TO CONFORM TO CANADIAN SAFETY COMMISSION, PRODUCT SAFETY ACT AND ALL CODE REQUIREMENTS.
 14. NO NEW FACILITIES OR EQUIPMENT INSTALLED FOR THE PERMANENT INSTALLATION MAY BE USED FOR TEMPORARY PURPOSES UNLESS THE CONTRACT DOCUMENTS SPECIFICALLY SPECIFY OTHERWISE.
 15. ALL REPAIRS SHALL BE FIELD VERIFIED PRIOR TO MANUFACTURING OR ORDERING OF ALL FLOOR, WINDOW, EQUIPMENT OR OTHER BUILDING PRODUCTS.
 16. THE EXTINGUISHERS SHALL BE INSTALLED IN ACCORDANCE WITH NFA 10, STANDARD FOR PORTABLE FIRE EXTINGUISHERS.
 17. EMERGENCY LIGHTING TO BE PROVIDED IN ACCORDANCE WITH NFA.
 18. ENTIRE BUILDING TO BE SPANNELED IN ACCORDANCE WITH NFA 10, DRAWINGS, DESIGN AND SPEC TO BE PROVIDED PRIOR TO INSTALLATION.

PROJECT NAME & ADDRESS:
 PLYMOUTH ENTERPRISE CENTER
 Greater Caribou Economic Development Council
 Plymouth, New Hampshire

FIRST FLOOR PLAN

A.I.I.

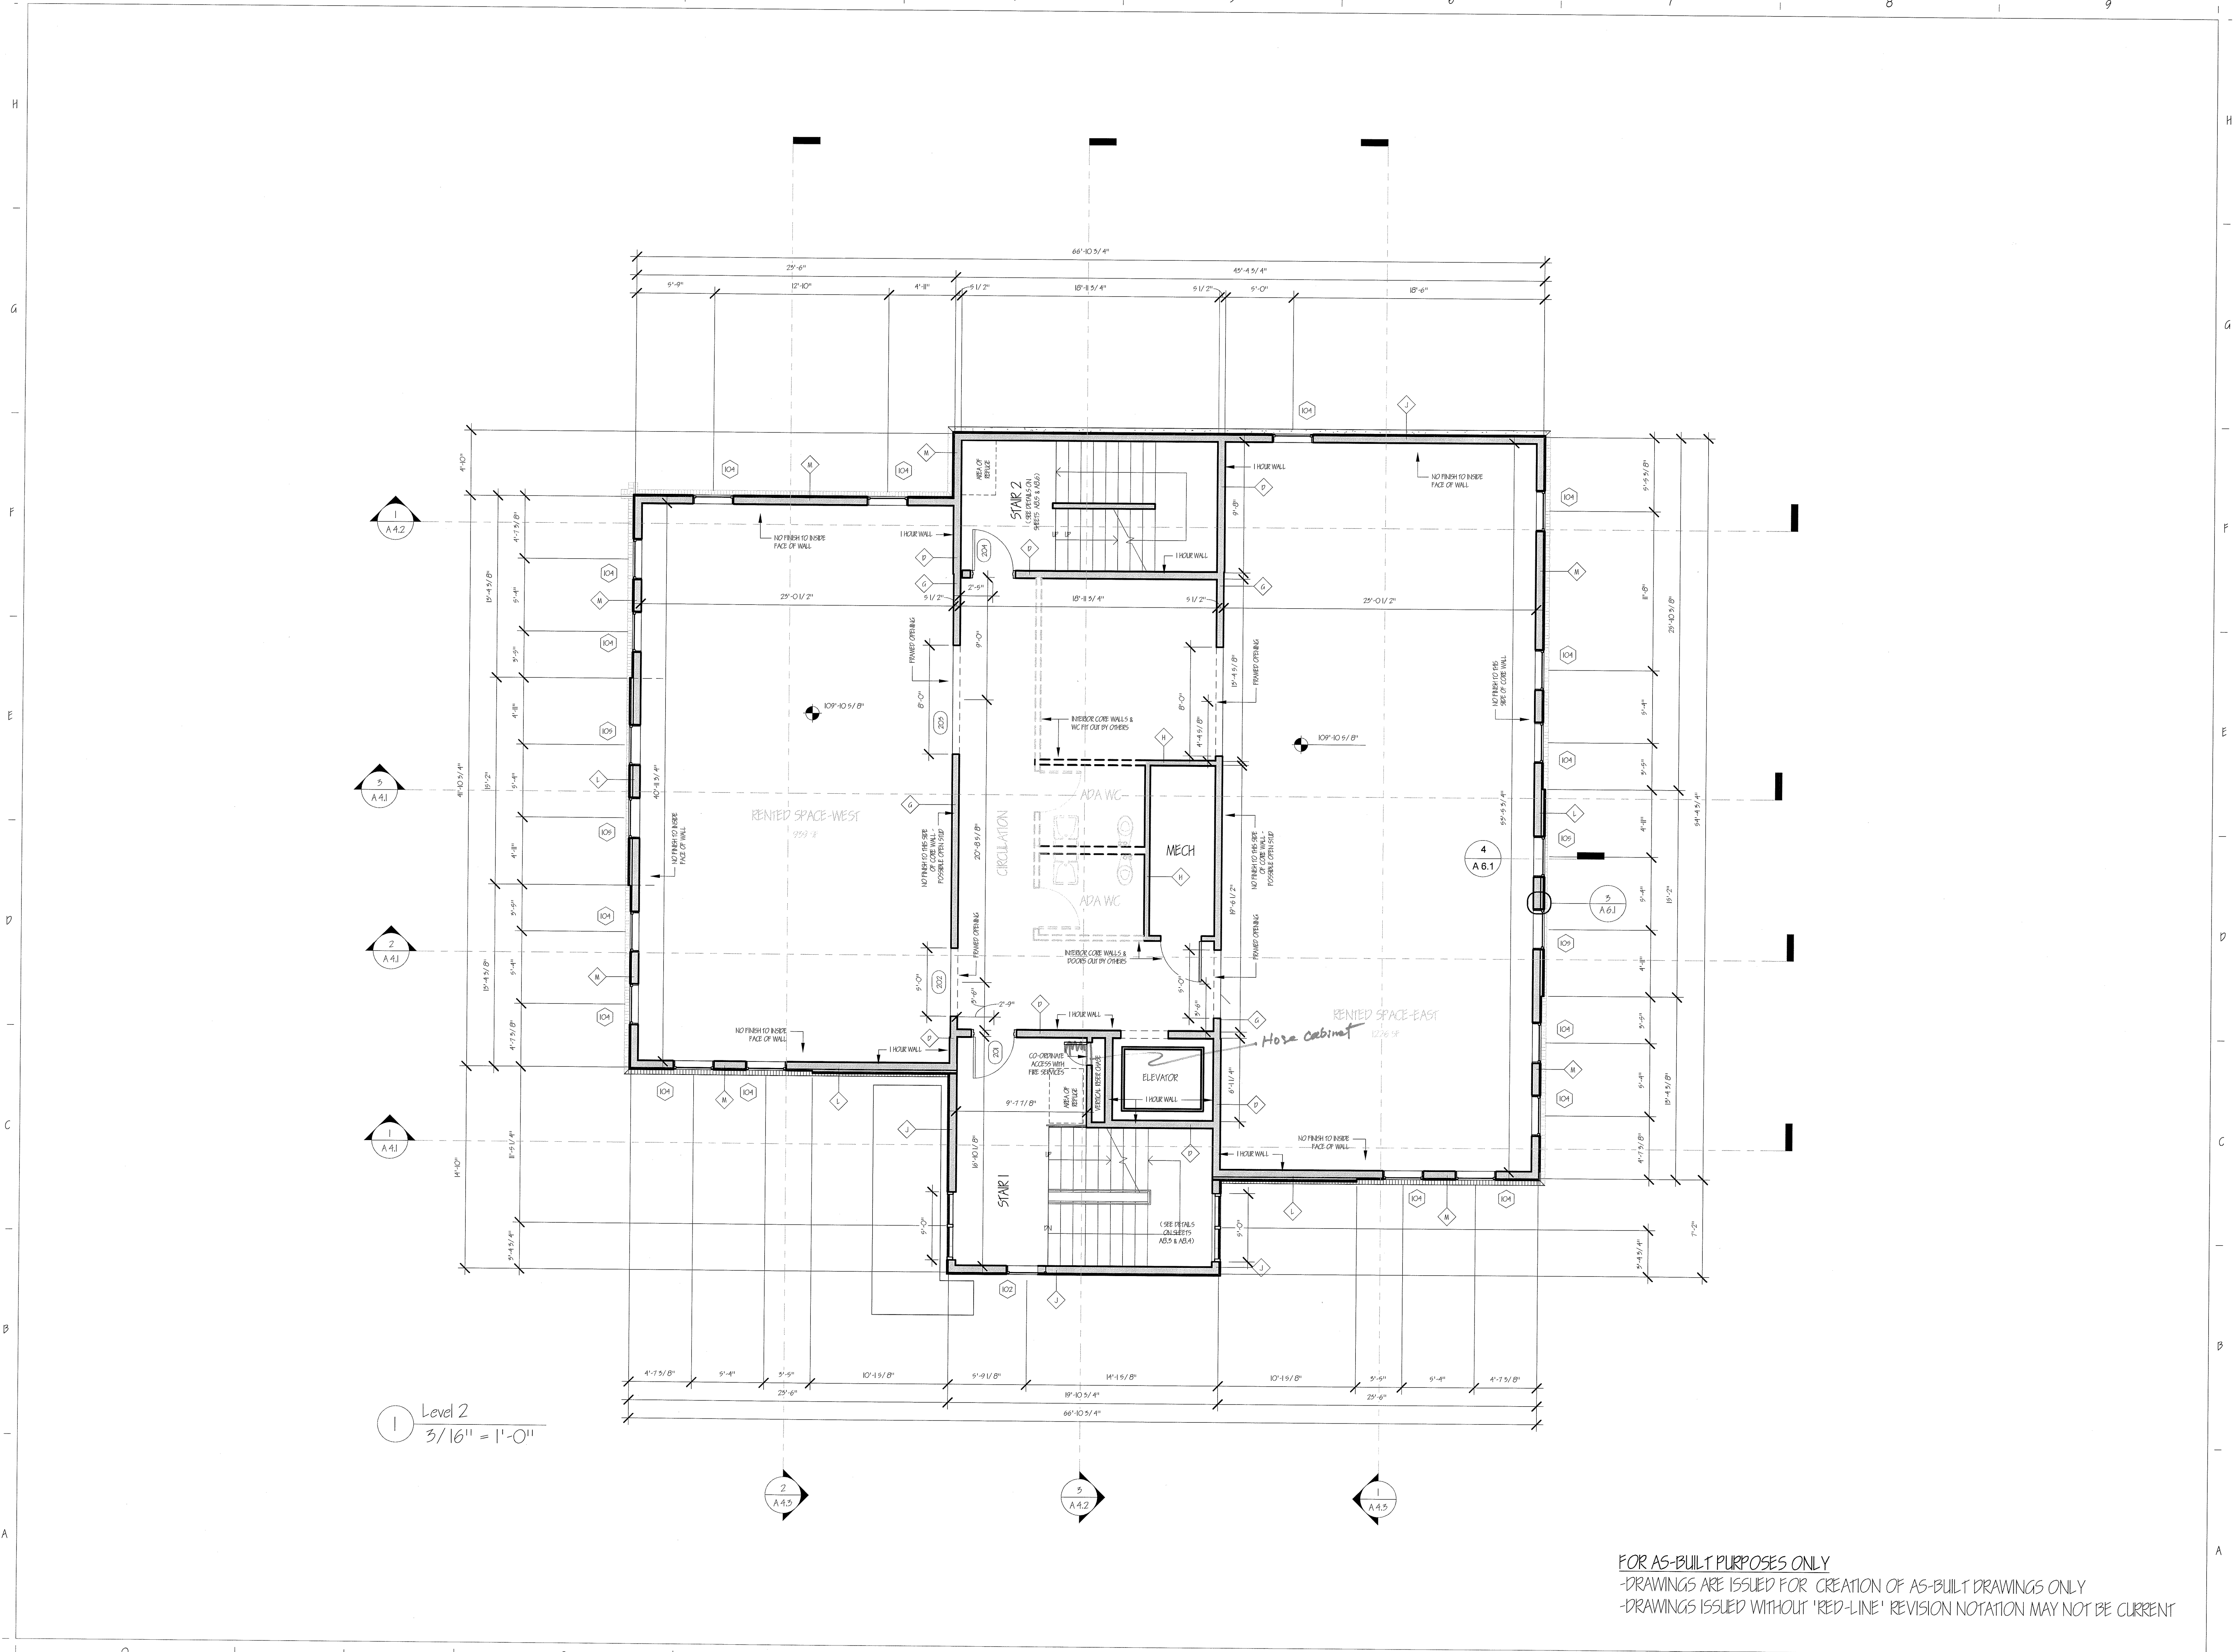


FOR AS-BUILT PURPOSES ONLY
 -DRAWINGS ARE ISSUED FOR CREATION OF AS-BUILT DRAWINGS ONLY
 -DRAWINGS ISSUED WITHOUT 'RED-LINE' REVISION NOTATION MAY NOT BE CURRENT

- GENERAL NOTES**
- BUILDING CODES**
1. ALL WORK PERFORMED BY THE CONTRACTOR AND ALL SUB-CONTRACTORS OF THIS PROJECT SHALL CONFORM TO THE REQUIREMENTS OF THE STATE OF NEW HAMPSHIRE BUILDING CODES (AND AMENDMENTS), THE CODE OF NEW HAMPSHIRE LIFE SAFETY CODE (AND ANY AMENDMENTS), THE TOWN OF WOODSTOCK ZONING REGULATIONS, AND ALL OTHER REGULATIONS AND CODES.
 2. ALL WORK TO COMPLY WITH ADA, ADAAG, LOCAL STATE & FEDERAL HANDICAPPED ACCESSIBILITY REQUIREMENTS.
- CONTRACT & CONTRACT DRAWINGS**
3. THE CONTRACT LINE HAS BEEN INDICATED ON THE DRAWINGS. IF NO LINE HAS BEEN INDICATED THEN THE OWNER, ARCHITECT & GENERAL CONTRACTOR SHOULD REVIEW ON-SITE PRIOR TO CONSTRUCTION.
 4. THE CONTRACTOR SHALL FAMILIARIZE HIMSELF WITH THE CONTRACT DRAWINGS AND SPECIFICATIONS. HE SHALL BE RESPONSIBLE TO THE ARCHITECT BEFORE PROCEEDING. THE CONTRACTOR SHALL BE SOLELY RESPONSIBLE FOR ANY AND ALL CONSTRUCTION METHODS, TECHNIQUES, SEQUENCES, PROCEDURES, SCHEDULING & SAFETY PROGRAMS REQUIRED TO COMPLETE THE WORK OF THE CONTRACT. PROVIDE ALL TEMPORARY PROTECTIVE WORKING NECESSARY TO SAFELY MAINTAIN THE STRUCTURAL INTEGRITY OF EXISTING CONSTRUCTION. ALL STRUCTURAL COMPONENTS AND SYSTEMS ARE INSTALLED & APPROVED BY THE OWNER OR ARCHITECT.
 5. COORDINATION: THE STRUCTURAL, MECHANICAL, AND ELECTRICAL DRAWINGS ARE SUPERSEDED BY THE ARCHITECTURAL DRAWINGS. IT SHALL BE THE RESPONSIBILITY OF THE CONTRACTOR TO CHECK AND COORDINATE ALL THE DRAWINGS BEFORE PARTICIPATION AND/OR INSTALLATION OF ANY WORK. CONTRACTOR SHALL IMMEDIATELY NOTIFY THE ARCHITECT OF ANY DISCREPANCIES.
 6. ALL STRUCTURAL DRAWINGS SHALL BE USED IN CONJUNCTION WITH THE SITE, ARCHITECTURAL, MECHANICAL, PLUMBING, AND ELECTRICAL DRAWINGS AND SPECIFICATIONS. VERIFY LOCATION AND DIMENSIONS OF CHASES, INSERTS, OPENINGS, SLEEVES, WORKS, DIPS, REVEALS, PRESSURES, AND OTHER PRELECT REQUIREMENTS NOT SHOWN ON THE STRUCTURAL DRAWINGS. VERIFY AND COORDINATE ALL DIMENSIONS RELATED TO THIS PROJECT.
 7. UNLESS OTHERWISE INDICATED, DETAILS SHOWN ARE TO BE CONSIDERED TYPICAL FOR SIMILAR CONDITIONS.
 8. IF THERE ARE CONFLICTS BETWEEN THE WORK INDICATED IN ANY OF THE DRAWINGS, AND/OR CONFLICTS BETWEEN THE SPECIFICATIONS, AND/OR CONFLICTS BETWEEN THE DRAWINGS AND SPECIFICATIONS, THE MORE COMPLEX OF THE CONFLICTING ALTERNATIVES SHALL BE INCLUDED IN THE BID OR PROPOSAL.
 9. REFER TO THE SPECIFICATIONS IN THE PROJECT MANUAL FOR ADDITIONAL INFORMATION AND INSTRUCTIONS.
- LEGEND & PRECEDENCE**
10. LEGEND: ALL SYMBOLS AND ABBREVIATIONS USED ON THE DRAWINGS ARE COVERED CONSTRUCTION STANDARDS. IF THE CONTRACTOR HAS ANY QUESTION REGARDING THE SAME OR THE EXACT MEANING, THE ARCHITECT SHALL BE NOTIFIED FOR CLARIFICATION.
 11. PRECEDENCE: DIMENSIONS SHALL HAVE PRECEDENCE OVER SCALE. LARGER SCALE DRAWINGS HAVE PRECEDENCE OVER SMALLER SCALE DRAWINGS. SPECIFICATIONS AND GENERAL NOTES HAVE PRECEDENCE OVER DRAWINGS.
- ADDITIONAL MISC. NOTES**
12. ACCESS PANELS: ALL EQUIPMENT SWITCHES, AND VALVES THAT ARE CONCEALED AND/OR PROVIDE ACCESS PANELS REGARDLESS WHETHER OR NOT THEY ARE INDICATED IN THE DRAWINGS.
 13. GLASS: ALL GLASS AND GLASS INSTALLATIONS TO CONFORM TO CONSUMER SAFETY COMMISSION PRODUCT SAFETY ACT AND ALL CODE REQUIREMENTS.
 14. NO NEW FACILITIES OR EQUIPMENT INTENDED FOR THE PERMANENT INSTALLATION MAY BE USED FOR TEMPORARY PURPOSES UNLESS THE CONTRACT DOCUMENTS SPECIFICALLY SPECIFIES ANY USE.
 15. ALL ROUGH OPENINGS SHALL BE FIELD VERIFIED PRIOR TO MANUFACTURING OR ORDERING OF ALL FLOOR, WINDOW, EQUIPMENT OR OTHER BUILDING PRODUCTS.
 16. FIRE EXTINGUISHERS SHALL BE INSTALLED IN ACCORDANCE WITH NFPA I.C. STANDARD FOR PORTABLE FIRE EXTINGUISHERS.
 17. EMERGENCY LIGHTING TO BE PROVIDED IN ACCORDANCE WITH NFPA.
 18. EXISTING BUILDING TO BE SPANNED IN ACCORDANCE WITH NFPA IS DRAWINGS, DESIGN AND SPEC. TO BE PREPARED PRIOR TO INSTALLATION.

PROJECT NAME & ADDRESS:
PLYMOUTH ENTERPRISE CENTER
 Crafton County Economic Development Council
 Plymouth, New Hampshire

SECOND FLOOR PLAN

A12

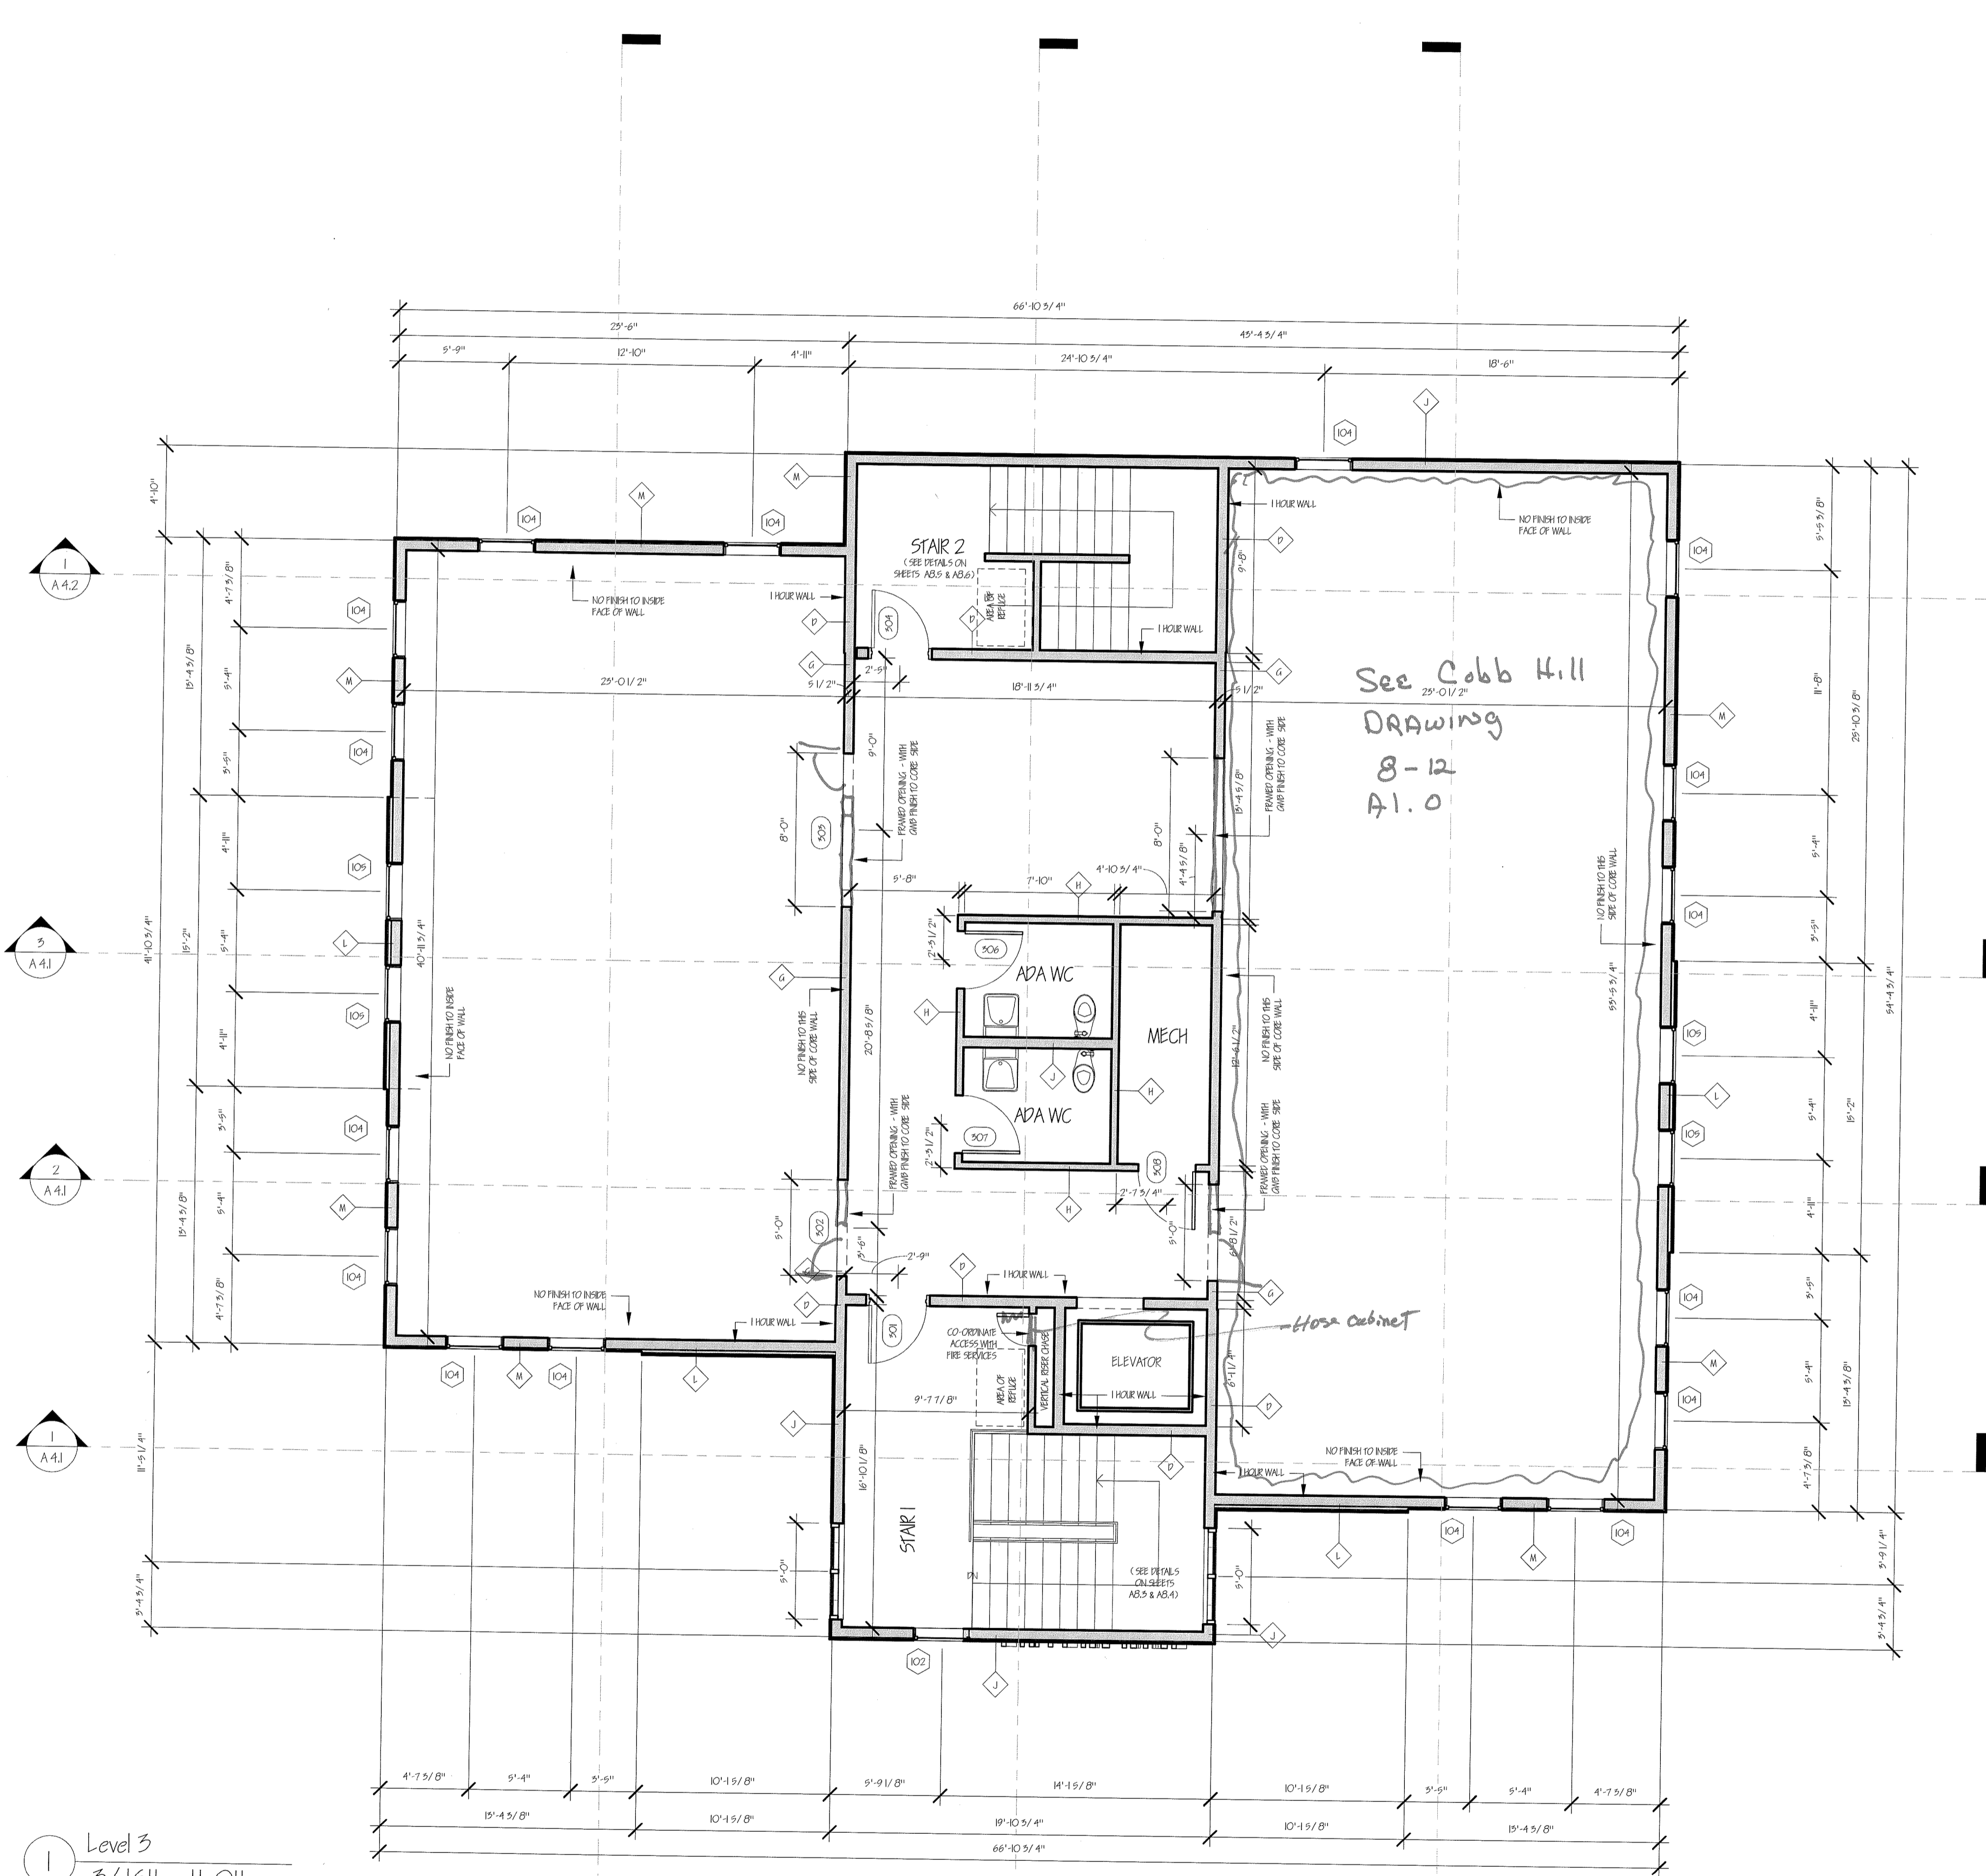

1 Level 3
3/16" = 1'-0"

See Cobb Hill
DRAWING
8-12
A1.0


FOR AS-BUILT PURPOSES ONLY
-DRAWINGS ARE ISSUED FOR CREATION OF AS-BUILT DRAWINGS ONLY
-DRAWINGS ISSUED WITHOUT 'RED-LINE' REVISION NOTATION MAY NOT BE CURRENT

- GENERAL NOTES:**
- BUILDING CODE:**
1. ALL WORK PERFORMED BY THE CONTRACTOR AND ALL SUB-CONTRACTORS OF THE PROJECT SHALL CONFORM TO THE REQUIREMENTS OF THE STATE OF NEW HAMPSHIRE BUILDING CODES (AND ANY AMENDMENTS), THE STATE OF NEW HAMPSHIRE LIFE SAFETY CODE (AND ANY AMENDMENTS), THE TOWN OF WOODSTOCK ZONING REGULATIONS, AND ALL OTHER REGULATIONS AND CODES.
 2. ALL WORK TO COMPLY WITH ADA, AS WELL AS LOCAL, STATE & FEDERAL HANDICAPPED ACCESSIBILITY REQUIREMENTS.
- CONTRACT & CONTRACT DRAWING:**
3. THE CONTRACT TIME HAS BEEN INDICATED ON THE DRAWINGS. IF NO TIME HAS BEEN INDICATED THEN THE OWNER, ARCHITECT & GENERAL CONTRACTOR SHOULD REVIEW ON THE TRACK TO COMPLETION.
 4. THE CONTRACTOR SHALL FAMILIARIZE HIMSELF WITH THE CONTRACT DRAWINGS. ANY DISCREPANCIES SHALL BE BROUGHT TO THE ATTENTION OF THE PROJECT BEFORE PROCEEDING. THE CONTRACTOR SHALL BE SOLELY RESPONSIBLE FOR ANY AND ALL CONSTRUCTION MEANS, METHODS, TECHNIQUES, SEQUENCES, PROCEDURES, SCHEDULING & SAFETY PROGRAMS REQUIRED TO COMPLETE THE WORK OF THIS CONTRACT. PROVIDE ALL TEMPORARY BRACING & SHORING NECESSARY TO SAFELY MAINTAIN THE STRUCTURAL INTEGRITY OF NEW AND EXISTING CONSTRUCTION. ALL STRUCTURING, CONCRETE AND SYSTEMS ARE INSTALLED & APPROVED BY THE OWNER OR ARCHITECT.
 5. COORDINATION: THE STRUCTURAL, MECHANICAL AND ELECTRICAL DRAWINGS ARE CONSIDERED TO BE ARCHITECTURAL DRAWINGS. IT SHALL BE THE RESPONSIBILITY OF THE CONTRACTOR TO CHECK AND COORDINATE ALL THE DRAWINGS BEFORE FABRICATION AND/OR INSTALLATION OF ANY ITEMS. CONTRACTOR SHALL IMMEDIATELY NOTIFY THE ARCHITECT OF ANY DISCREPANCIES OR CONFLICTS.
 6. ALL STRUCTURAL DRAWINGS SHALL BE USED IN CONJUNCTION WITH THE SITE, ARCHITECTURAL, MECHANICAL, PLUMBING AND ELECTRICAL DRAWINGS AND SPECIFICATIONS. VERIFY LOCATION AND DIMENSIONS OF CHASES, INSERTS, OPENINGS, SERVICES, WAKES, DIPS, TRAYS, DEFLECTIONS, AND OTHER PROJECT REQUIREMENTS BY REFERENCE TO THE STRUCTURAL DRAWINGS. VERIFY AND COORDINATE ALL DIMENSIONS RELATED TO THE PROJECT.
 7. UNLESS OTHERWISE INDICATED, DIMENSIONS SHOWN ARE TO BE CONSIDERED TYPICAL FOR SIMILAR CONDITIONS.
 8. IF THERE ARE ANY CONFLICTS BETWEEN THE WORK INDICATED IN ANY OF THE DRAWINGS, ANY OR ANY CONFLICTS BETWEEN THE SPECIFICATIONS AND/OR CONFLICTS BETWEEN THE DRAWINGS AND PROJECTIONS, THE MORE DETAILED OR THE CONFLICTING ALTERNATIVES SHALL BE INCLUDED IN THE BID OR PROPOSAL.
 9. REFER TO THE SPECIFICATIONS IN THE PROJECT MANUAL FOR ADDITIONAL INFORMATION AND INSTRUCTIONS.
- LEGEND & PREFERENCE:**
10. LEGEND: ALL SYMBOLS AND ABBREVIATIONS USED ON THE DRAWINGS ARE CONSIDERED CONSTRUCTION STANDARDS. IF THE CONTRACTOR HAS ANY QUESTIONS REGARDING THE SAME OR OTHER EXACT MEANING, THE ARCHITECT SHALL BE NOTIFIED FOR CLARIFICATION.
 11. PREFERENCE: DIMENSIONS SHALL HAVE PRECEDENCE OVER SCALE. LARGER SCALE DRAWINGS HAVE PRECEDENCE OVER SMALLER SCALE DRAWINGS. SPECIFICATIONS AND GENERAL NOTES TAKE PRECEDENCE OVER DRAWINGS.
- ADDITIONAL NOTES:**
12. ACCESS PANELS, ALL EQUIPMENT SWITCHES, AND VALVES SHALL BE COORDINATED WITH THE PROJECT ARCHITECTURAL PRODUCT SAFETY ACT AND ALL CODE REQUIREMENTS.
 13. GLASS: ALL GLASS AND GLASS REGULATIONS TO CONFORM TO CONSUMER SAFETY CONCEPTS, PRODUCT SAFETY ACT AND ALL CODE REQUIREMENTS.
 14. NO NEW FACILITIES OR EQUIPMENT INSTALLED FOR THE PERMANENT INSTALLATION MAY BE USED FOR TEMPORARY PURPOSES UNLESS THE CONTRACT DOCUMENTS SPECIFICALLY SPECIFY THAT USE.
 15. ALL ROUGH OPENINGS SHALL BE FIELD VERIFIED PRIOR TO MANUFACTURING OR ORDERING OF ALL FLOOR, WINDOW, EQUIPMENT OR OTHER BUILDING PRODUCTS.
 16. FIRE EXTINGUISHERS SHALL BE INSTALLED IN ACCORDANCE WITH NFPA 10, STANDARD FOR PORTABLE FIRE EXTINGUISHERS.
 17. EMERGENCY LIGHTING TO BE PROVIDED IN ACCORDANCE WITH NFPA.
 18. ENTIRE BUILDING TO BE SPARKLEPROOF IN ACCORDANCE WITH NFPA STANDARDS. SPARK AND SPEC TO BE PROVIDED PRIOR TO INSTALLATION.
- Copyright © 2014 Alpa General

PROJECT NAME & ADDRESS:
PLIMOUTH ENTERPRISE CENTER
Grafton County Economic Development Council
Plymouth, New Hampshire

THIRD FLOOR PLAN
A1.3

1 Roof Plan
 3/16" = 1'-0"

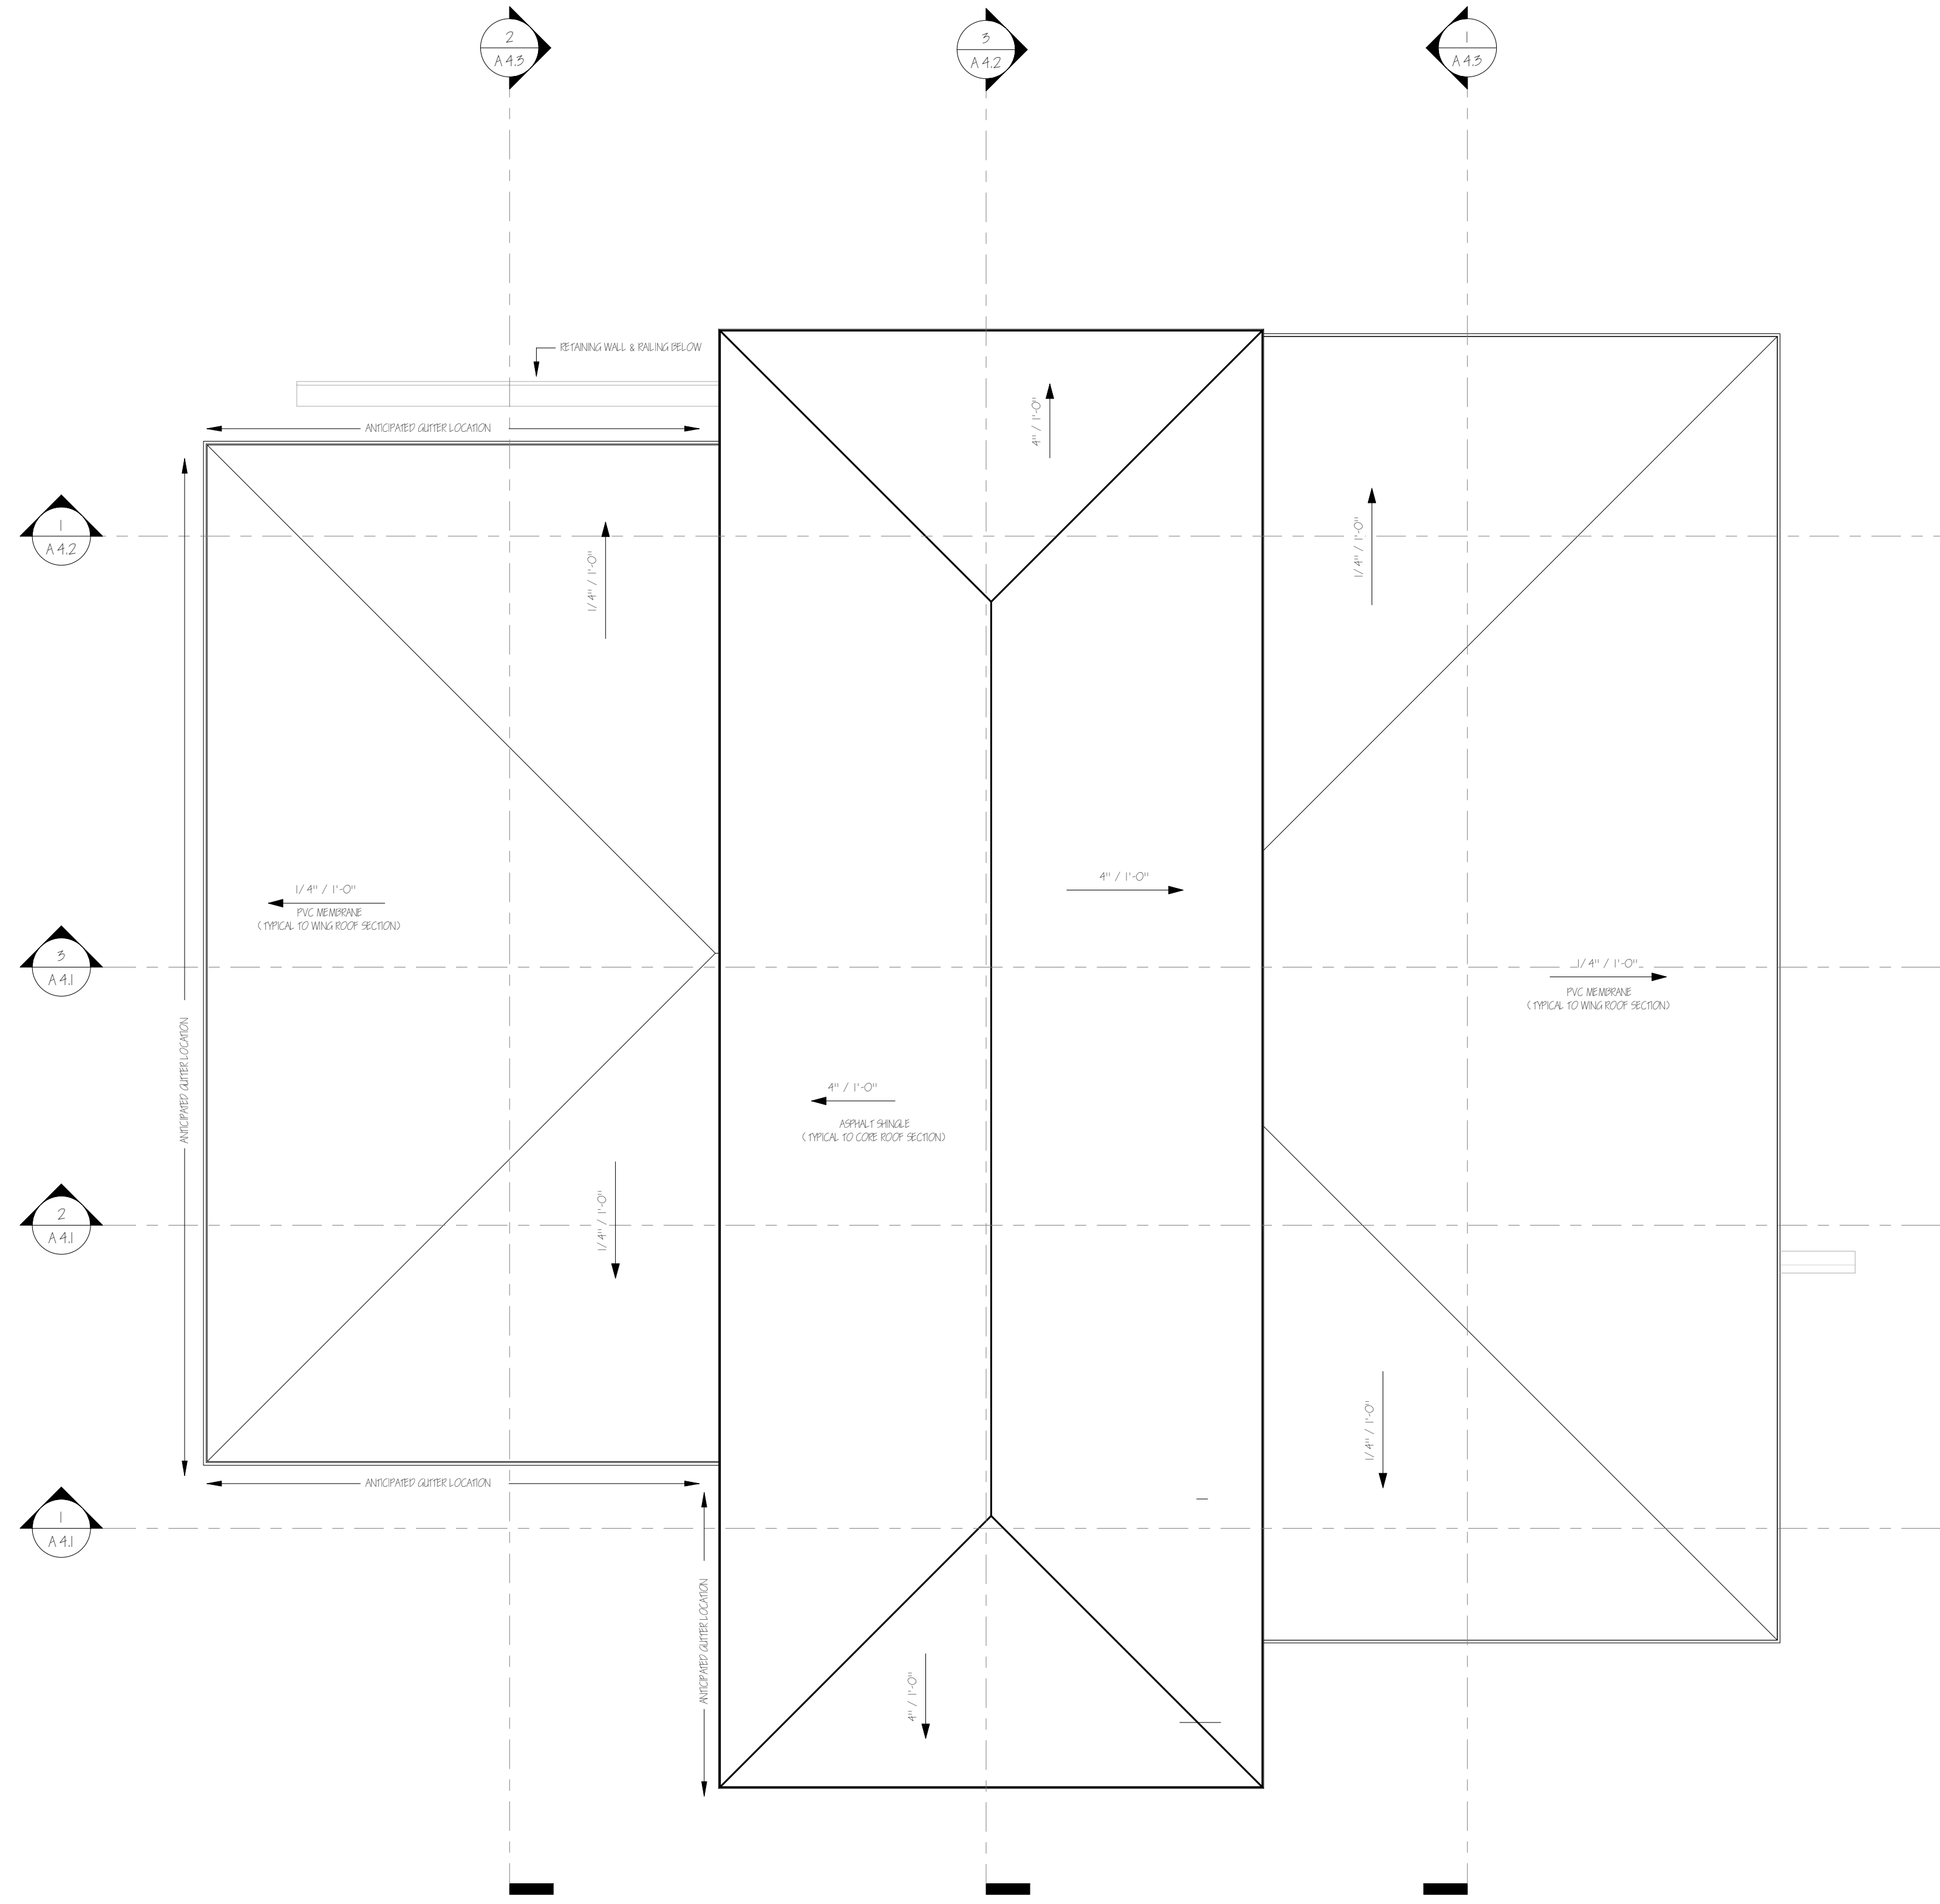

FOR AS-BUILT PURPOSES ONLY
 -DRAWINGS ARE ISSUED FOR CREATION OF AS-BUILT DRAWINGS ONLY
 -DRAWINGS ISSUED WITHOUT 'RED-LINE' REVISION NOTATION MAY NOT BE CURRENT

GENERAL NOTES:

- BUILDING CODE**
- ALL WORK PERFORMED BY THE CONTRACTOR AND ALL SUB-CONTRACTORS OF THIS PROJECT SHALL CONFORM TO THE REQUIREMENTS OF THE STATE OF NEW HAMPSHIRE BUILDING CODES AND ANY AMENDMENTS; THE STATE OF NEW HAMPSHIRE LIFE SAFETY CODE (AND ANY AMENDMENTS); THE TOWN OF WOODS HOLE ZONING REGULATIONS, AND ALL OTHER REGULATORY AND CODES.
 - ALL WORK TO COMPLY WITH LOCAL, STATE AND FEDERAL HANDICAPPED ACCESSIBILITY REQUIREMENTS.
- CONTRACT & CONTRACT DRAWINGS**
- IF THE CONTRACT HAD ANY ADDENDUMS ON THE DRAWINGS, IF NO LIST WAS INDICATED BY THE OWNER, ARCHITECT & GENERAL CONTRACTOR SHOULD REVIEW ON-SITE PRIOR TO CONSTRUCTION.
 - THE CONTRACTOR SHALL FAMILIARIZE HIMSELF WITH THE CONTRACT DRAWINGS. ANY DISCREPANCIES SHALL BE BROUGHT TO THE ATTENTION OF THE ARCHITECT BEFORE PROCEEDING. THE CONTRACTOR SHALL BE SOLELY RESPONSIBLE FOR ANY AND ALL CONSTRUCTION MEANS, METHODS, SEQUENCES, PROCEDURES, SCHEDULING & SCHEDULING PROCEDURES REQUIRED TO COMPLETE THE WORK OF THIS CONTRACT. PROVIDE ALL TEMPORARY PROTECTIVE MEASURES AND SAFETY MEASURES TO MAINTAIN THE STRUCTURAL INTEGRITY OF EXISTING CONSTRUCTION UNTIL ALL STRUCTURAL COMPONENTS AND SYSTEMS ARE INSTALLED & APPROVED BY THE OWNER OR ARCHITECT.
 - COORDINATION OF THE STRUCTURAL, MECHANICAL, AND ELECTRICAL DRAWINGS ARE SUPPLEMENTARY TO THE ARCHITECTURAL DRAWINGS. IT SHALL BE THE RESPONSIBILITY OF THE CONTRACTOR TO CHECK AND COORDINATE ALL THE DRAWINGS BEFORE FABRICATION AND/OR INSTALLATION OF ANY WORK. CONTRACTOR SHALL IMMEDIATELY NOTIFY THE ARCHITECT OF ANY DISCREPANCIES OR ERRORS.
 - ALL STRUCTURAL DRAWINGS SHALL BE IN CONJUNCTION WITH THE ARCHITECTURAL, MECHANICAL, PLUMBING, AND ELECTRICAL DRAWINGS AND SPECIFICATIONS. VERIFY LOCATION AND DIMENSIONS OF CHASES, INSERTS, OPENINGS, SLEEVES, WELDS, WIPS, REINFORCING, REINFORCEMENTS, AND OTHER PROJECT REQUIREMENTS SHOWN ON THE STRUCTURAL DRAWINGS. VERIFY AND COORDINATE ALL DIMENSIONS RELATED TO THIS PROJECT.
 - UNLESS OTHERWISE INDICATED, DETAILS SHOWN ARE TO BE CONSIDERED TYPICAL FOR SIMILAR CONDITIONS.
 - IF THERE EXIST CONFLICTS BETWEEN THE WORK INDICATED IN ANY OF THE DRAWINGS AND/OR ANY CONFLICTS WITHIN THE SPECIFICATIONS, AND/OR CONFLICTS BETWEEN THE DRAWINGS AND SPECIFICATIONS BE THE MORE DETAILED OF THE DRAWINGS, ALTERNATIVES SHALL BE INCLUDED IN THE BID OR PROPOSAL.
 - REFER TO THE SPECIFICATIONS IN THE PROJECT MANUAL FOR ADDITIONAL INFORMATION AND INSTRUCTIONS.

LEGEND & PRECEDENCE

- LEGEND: ALL SYMBOLS AND ABBREVIATIONS USED ON THE DRAWINGS ARE CONSIDERED CONSTRUCTION STANDARDS. IF THE CONTRACTOR HAS ANY QUESTIONS REGARDING THE SAME OR THEIR EXACT MEANING, THE ARCHITECT SHALL BE NOTIFIED FOR CLARIFICATION.
- PRECEDENCE: DIMENSIONS SHALL HAVE PRECEDENCE OVER SCALE. LARGER SCALE DRAWINGS HAVE PRECEDENCE OVER SMALLER SCALE DRAWINGS. SPECIFICATIONS AND GENERAL NOTES HAVE PRECEDENCE OVER DRAWINGS.

ADDITIONAL MISC. NOTES


- ACCESS PANELS: ALL EQUIPMENT SWITCHES AND VALVES THAT ARE CONCEALED MUST BE PROVIDED WITH ACCESS PANELS REGARDLESS WHETHER OR NOT THEY ARE INDICATED IN THE DRAWINGS.
- GLASS: ALL GLASS AND GLASS INSTALLATIONS TO CONFORM TO GRANBERRY SAFETY COMMISSION, PROTECT SAFETY ACT AND ALL CODE REQUIREMENTS.
- NO NEW FACILITIES OR EQUIPMENT INTENDED FOR THE PERMANENT INSTALLATION MAY BE USED FOR TEMPORARY PURPOSES UNLESS THE CONTRACT DOCUMENTS SPECIFICALLY SPECIFY THAT USE.
- ALL ROUGH OPENINGS SHALL BE FIELD VERIFIED PRIOR TO MANUFACTURING OR OPENING OF ALL DOOR, WINDOW, EQUIPMENT OR OTHER BUILDING PRODUCTS.
- FIRE EXTINGUISHERS SHALL BE INSTALLED IN ACCORDANCE WITH NFPA 10. STANDARDS FOR PORTABLE FIRE EXTINGUISHERS.
- EMERGENCY LIGHTING TO BE PROVIDED IN ACCORDANCE WITH NFPA.
- ENTER BUILDING TO BE SPRINKLERED IN ACCORDANCE WITH NFPA 13. DRAWINGS, DESIGN AND SPEC TO BE PROVIDED PRIOR TO INSTALLATION.

Copyright 2025 All Rights Reserved

PROJECT NAME & ADDRESS:
PLYMOUTH ENTERPRISE CENTER
 Greater Cranby Economic Development Council
 Plymouth, New Hampshire

ROOF PLAN

A1.4

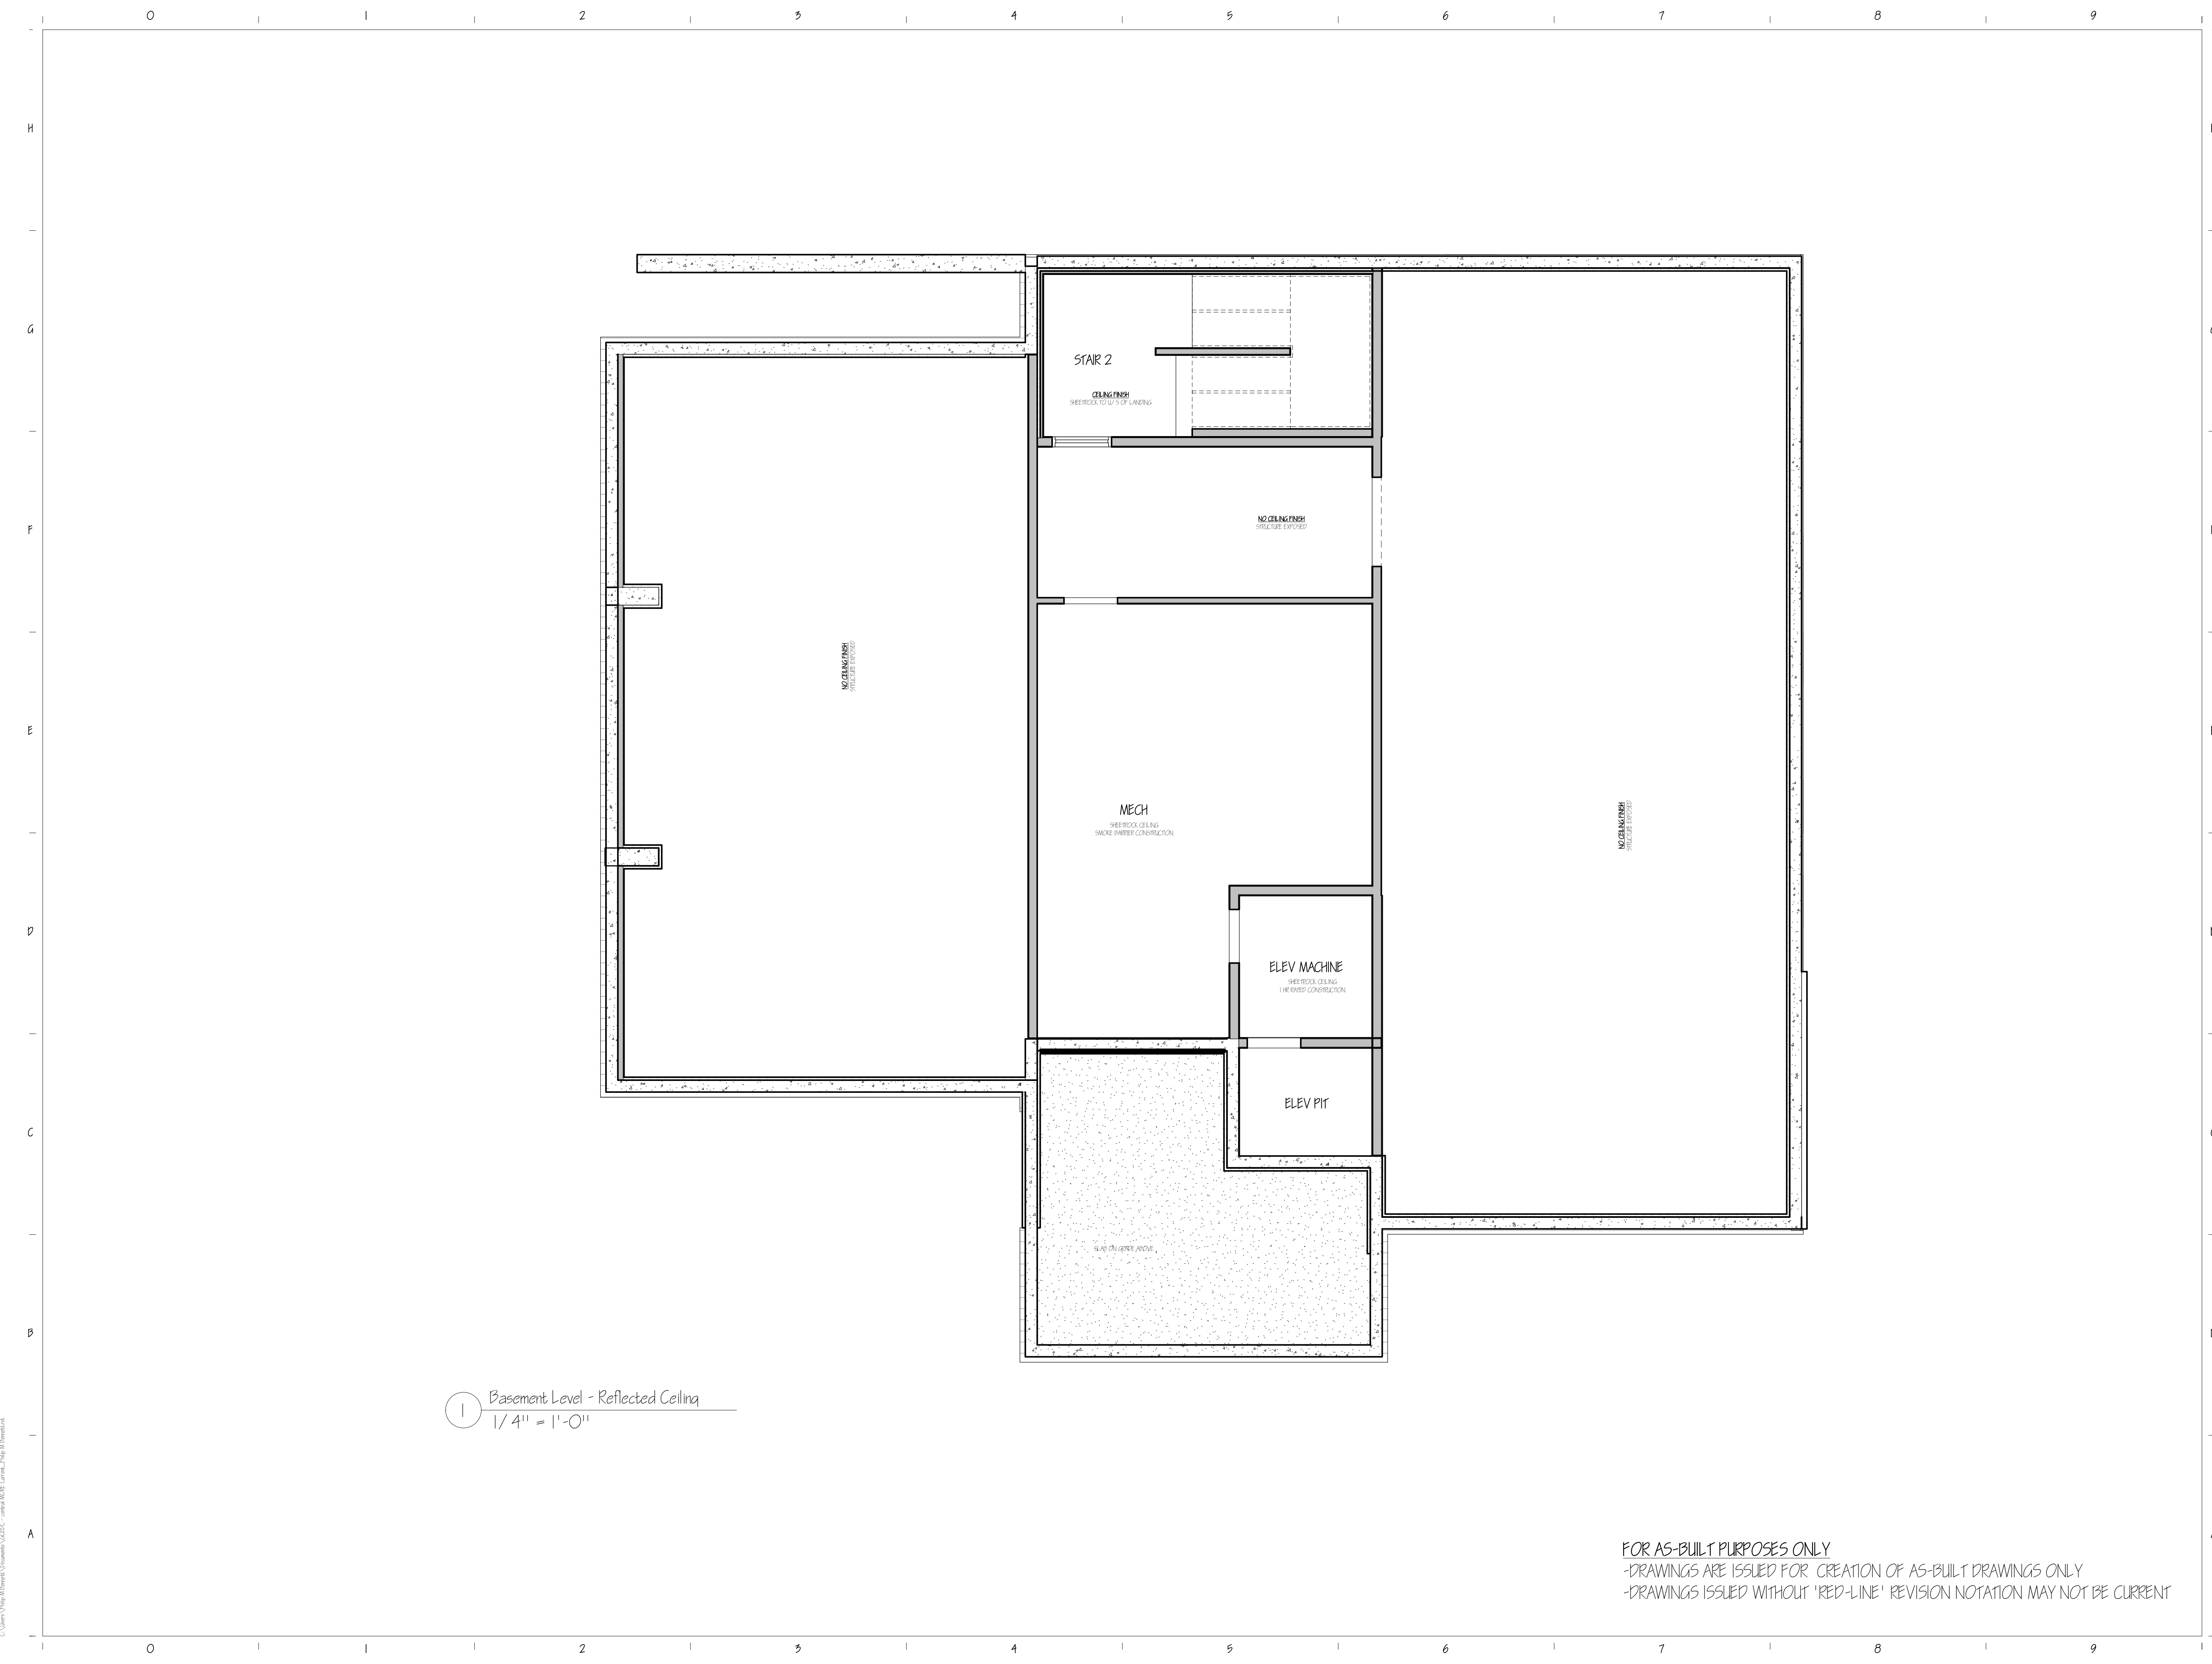

1 Basement Level - Reflected Ceiling
 1/4" = 1'-0"

FOR AS-BUILT PURPOSES ONLY
 -DRAWINGS ARE ISSUED FOR CREATION OF AS-BUILT DRAWINGS ONLY
 -DRAWINGS ISSUED WITHOUT 'RED-LINE' REVISION NOTATION MAY NOT BE CURRENT


GENERAL NOTES:

Copyright 2014 Alba Architects

PROJECT NAME & ADDRESS:
 PLYMOUTH ENTERPRISE CENTER
 Grafton County Economic Development Council
 Plymouth, New Hampshire

BASEMENT CEILING PLAN A 2.0

C:\Users\jlp\Documents\CECE - 061413\CE - 061413\Level 1 - Ceiling Plan.dwg

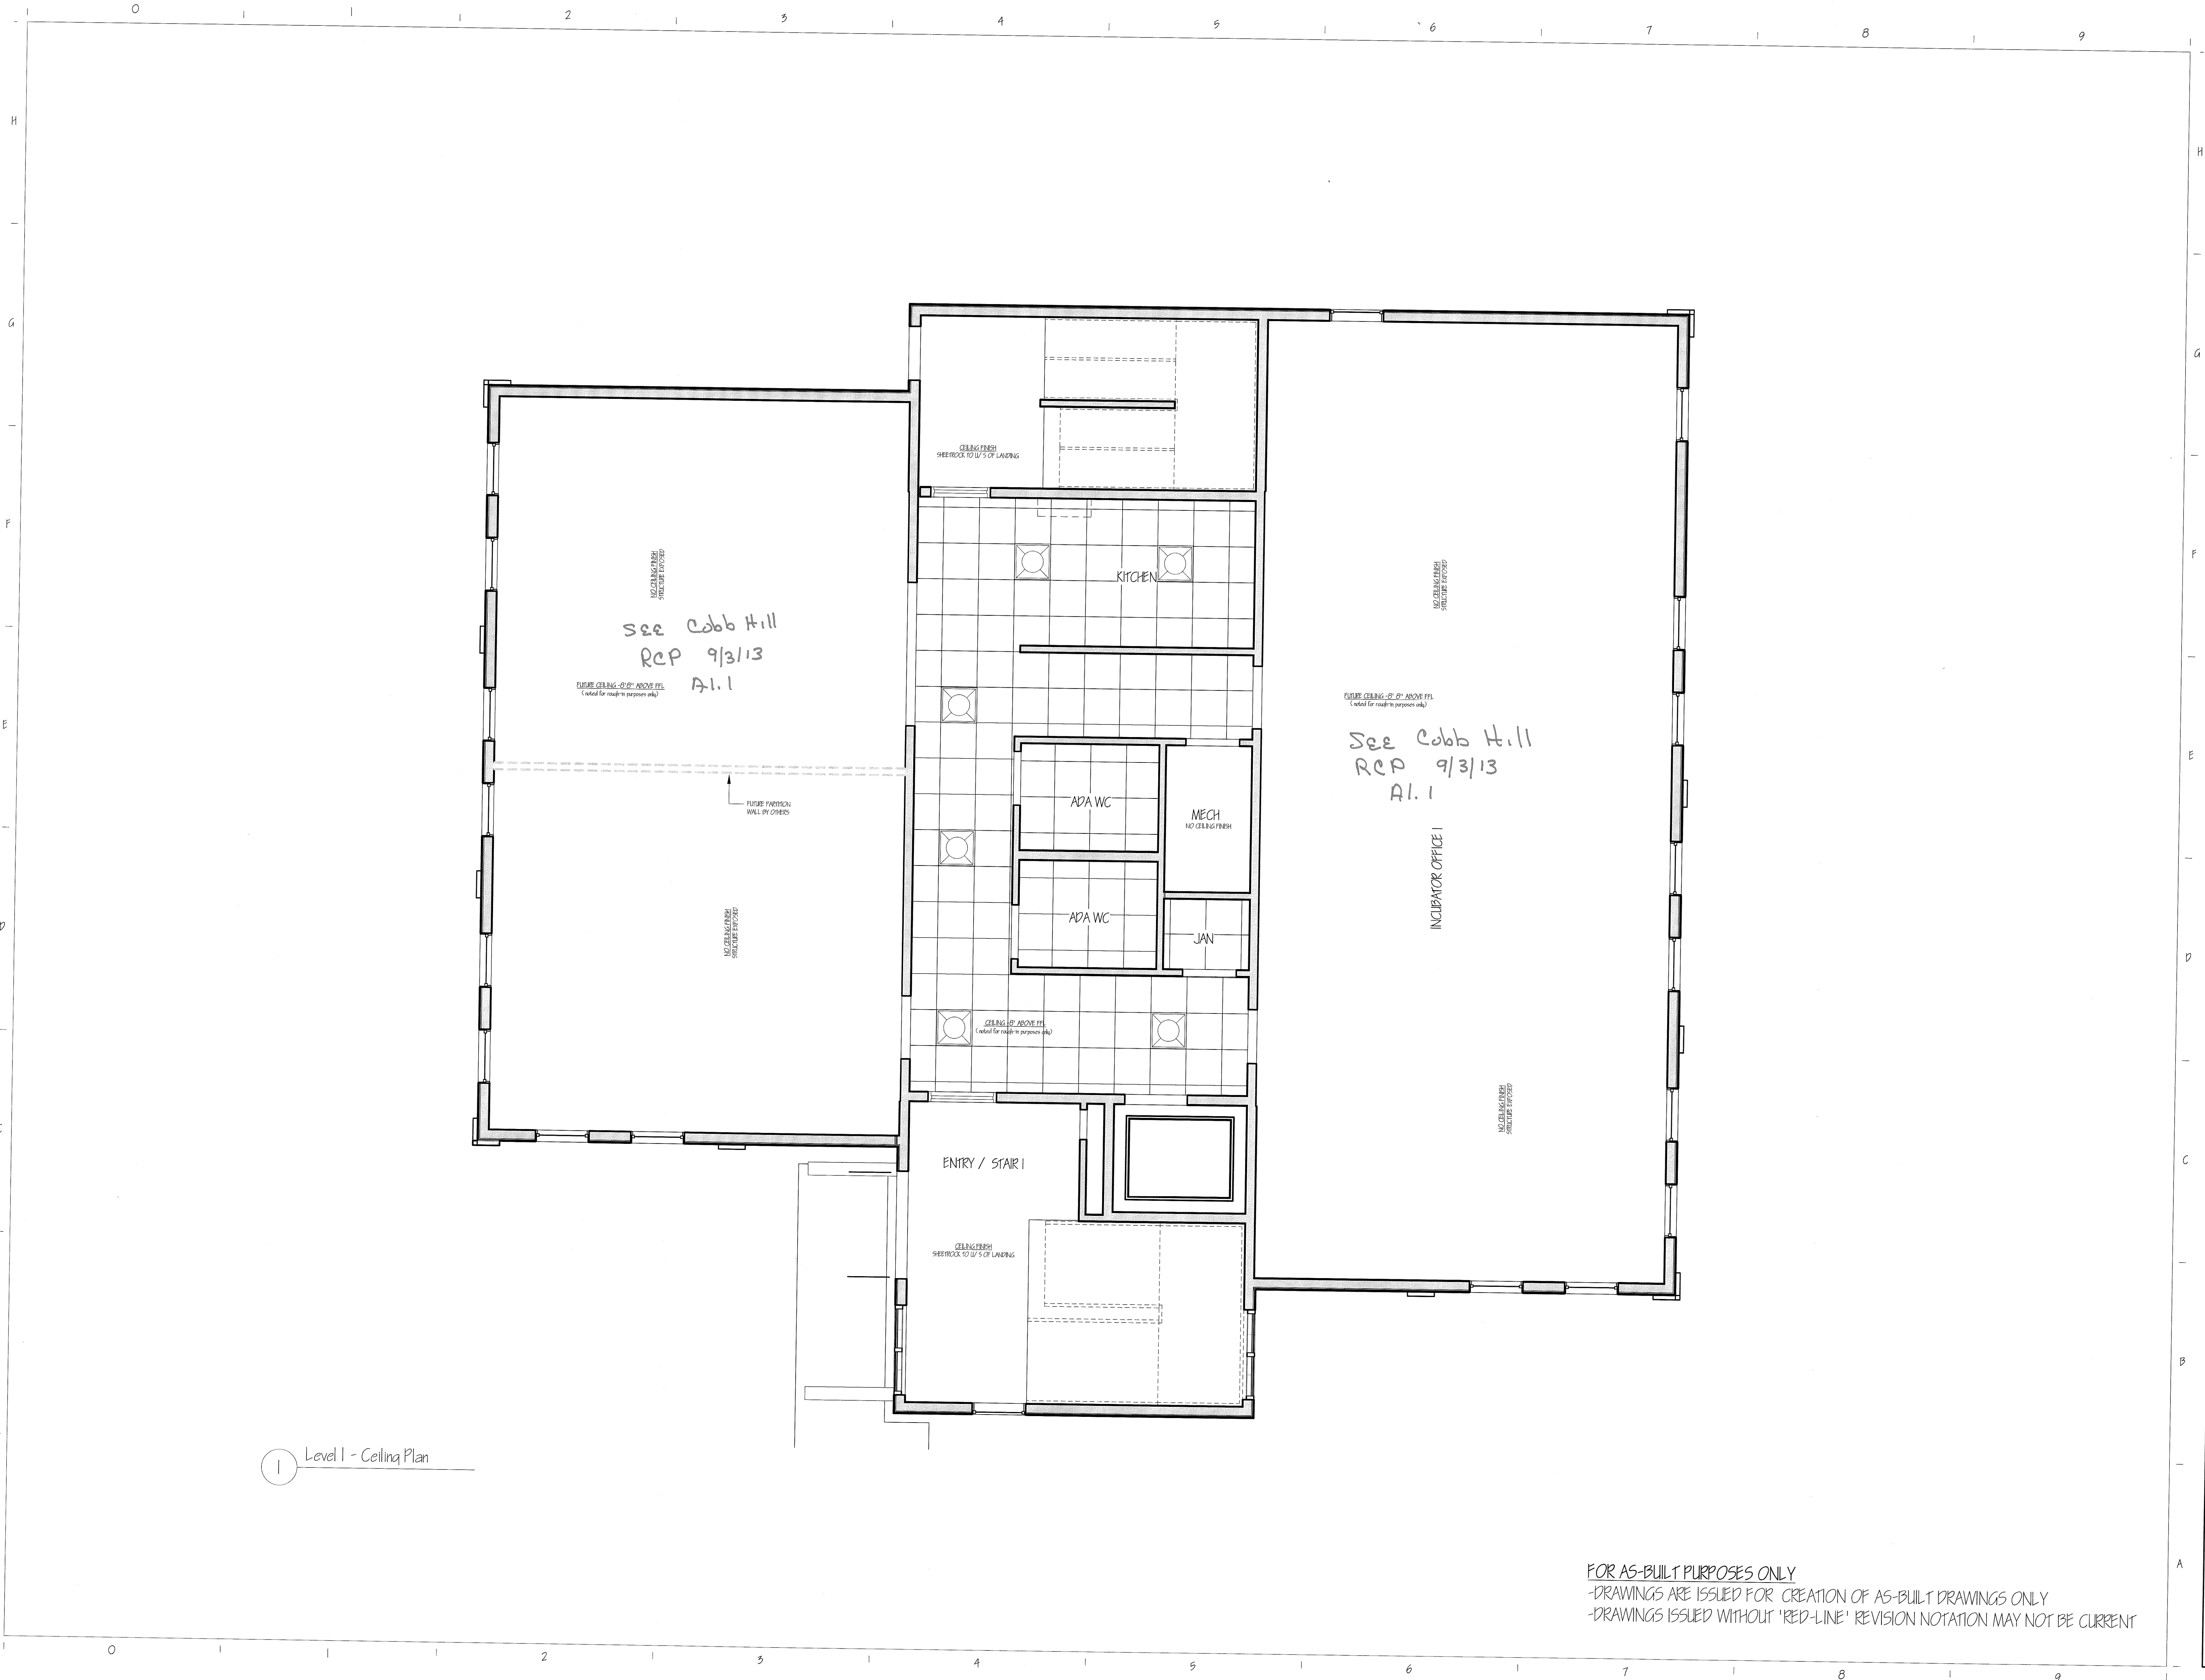

1 Level 1 - Ceiling Plan


FOR AS-BUILT PURPOSES ONLY
-DRAWINGS ARE ISSUED FOR CREATION OF AS-BUILT DRAWINGS ONLY
-DRAWINGS ISSUED WITHOUT 'RED-LINE' REVISION NOTATION MAY NOT BE CURRENT

GENERAL NOTES:

PROJECT NAME & ADDRESS:
PLYMOUTH ENTERPRISE CENTER
Grafton County Economic Development Council
Plymouth, New Hampshire

FIRST FLOOR CEILING PLAN A 2.1

1 Level 2 - Ceiling Plan
 1/4" = 1'-0"

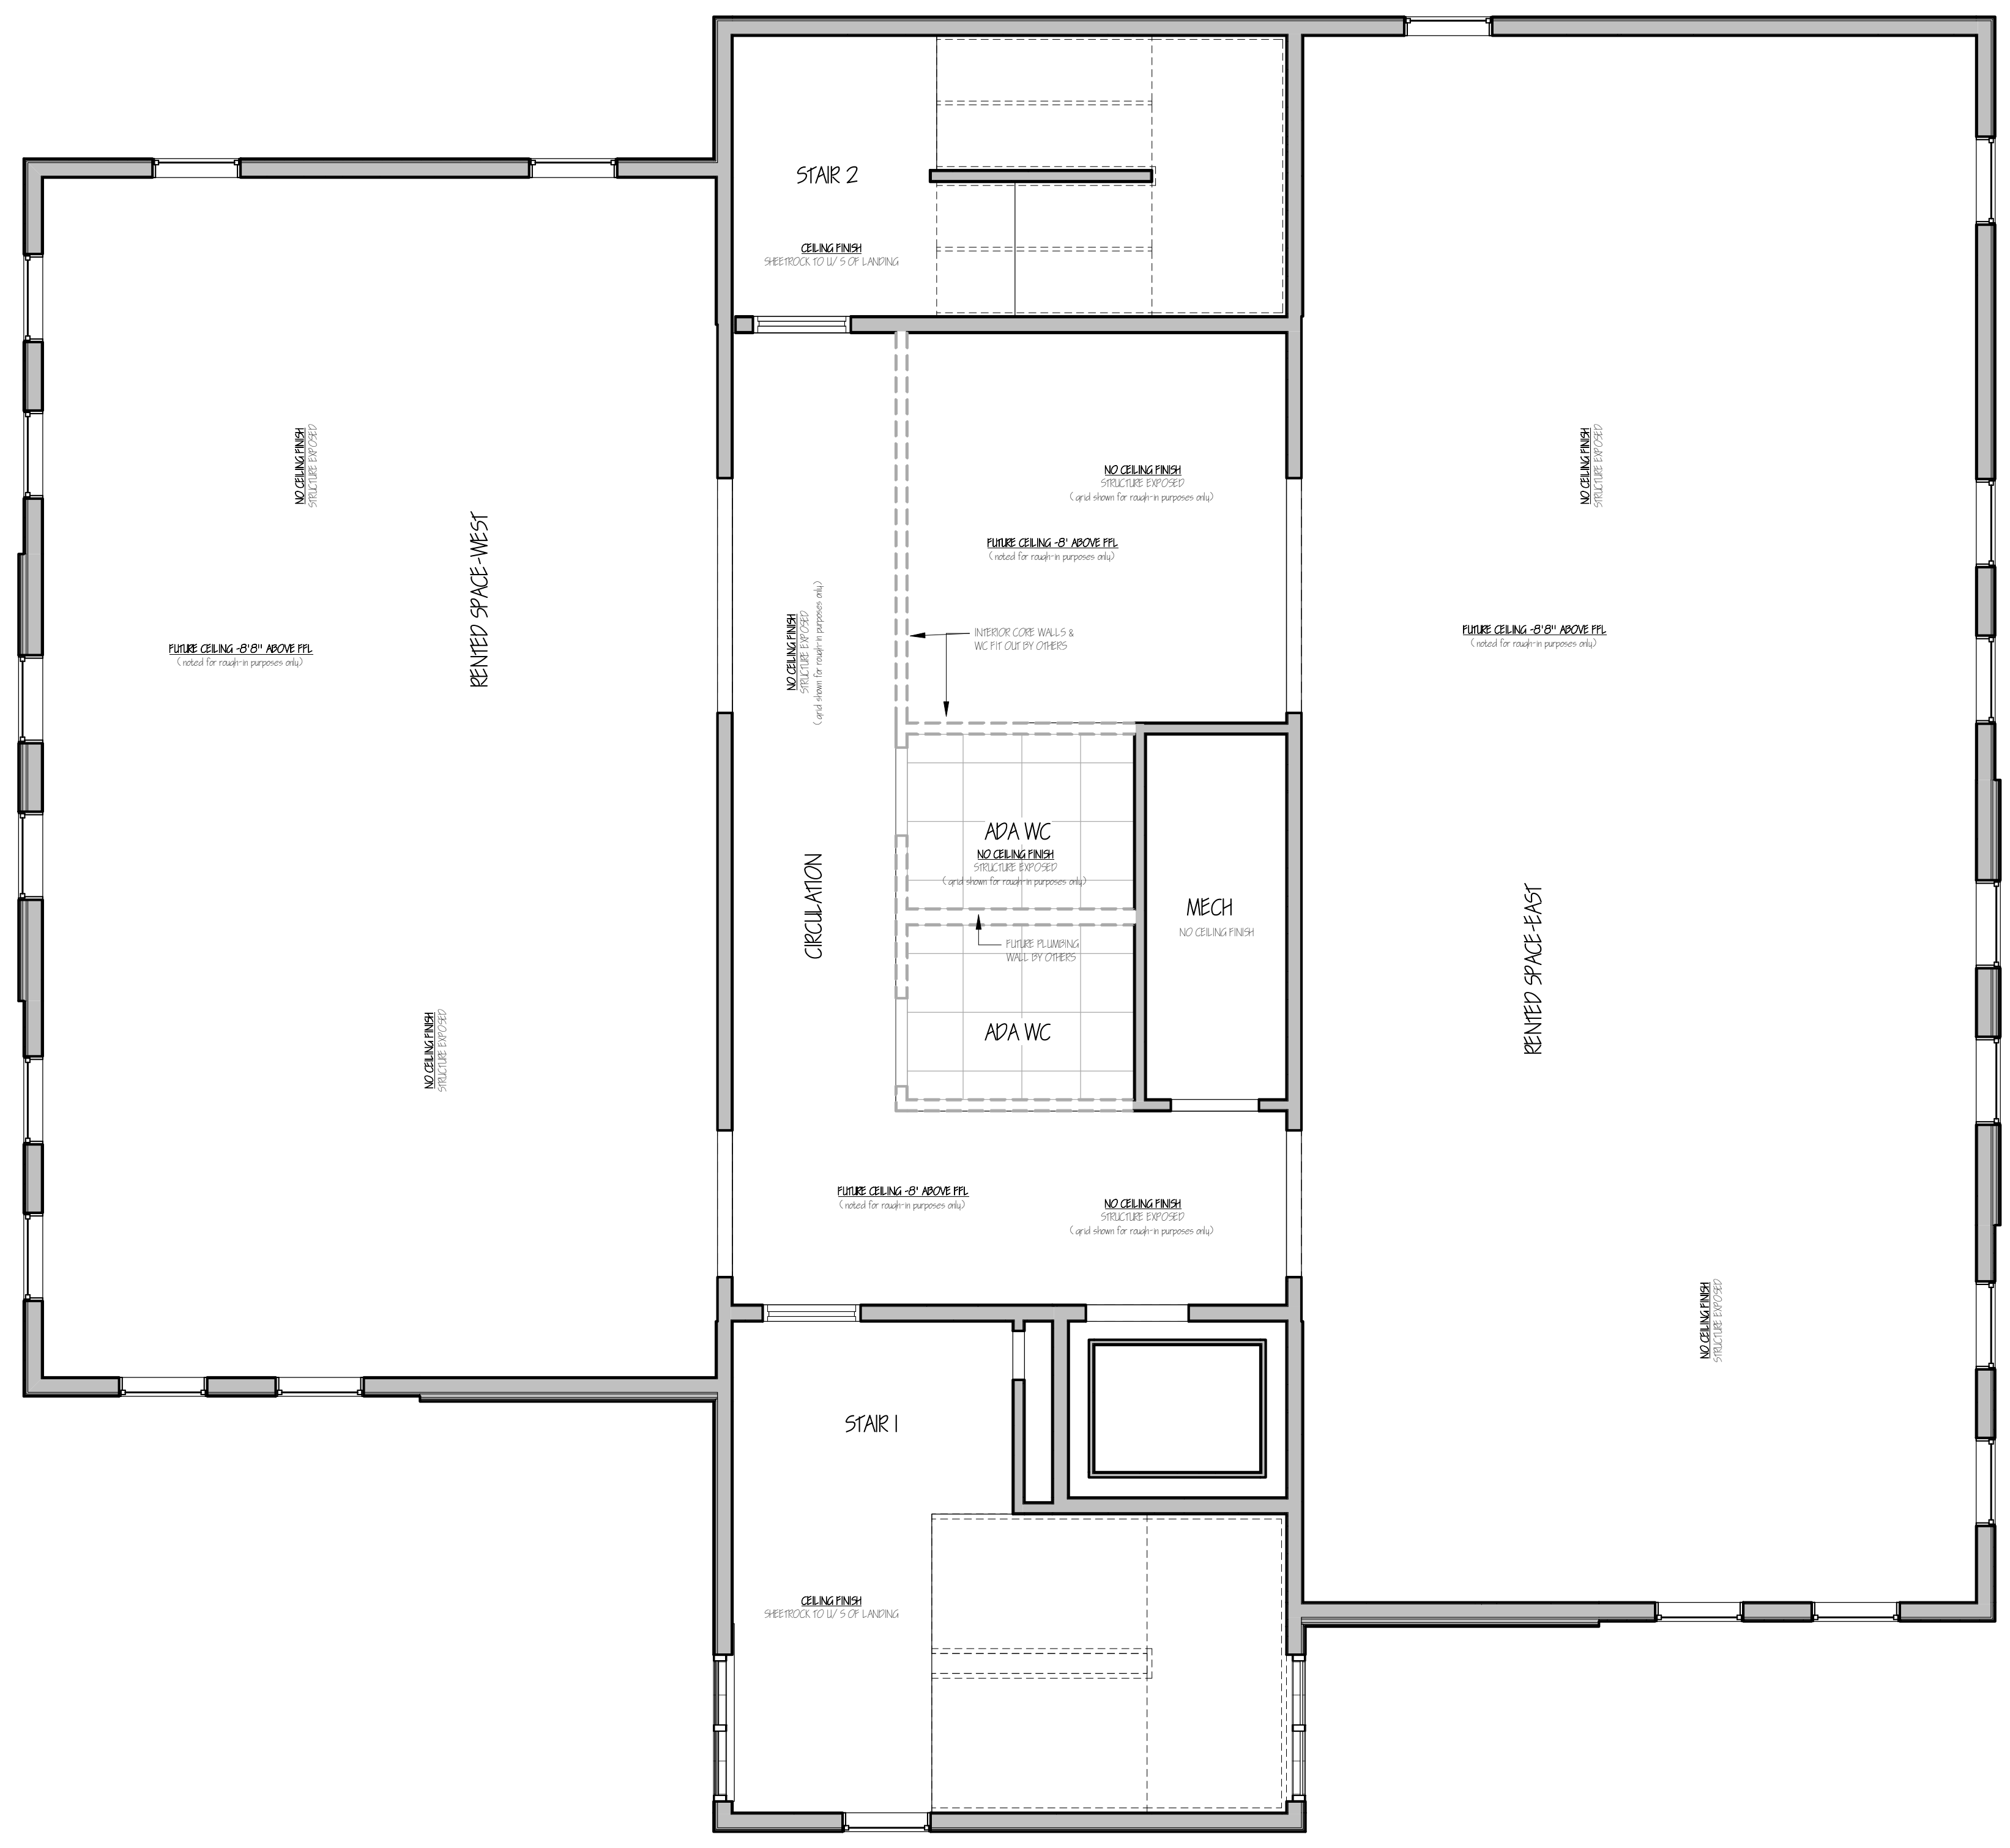


FOR AS-BUILT PURPOSES ONLY
 -DRAWINGS ARE ISSUED FOR CREATION OF AS-BUILT DRAWINGS ONLY
 -DRAWINGS ISSUED WITHOUT 'RED-LINE' REVISION NOTATION MAY NOT BE CURRENT

GENERAL NOTES:

PROJECT NAME & ADDRESS:
 PLYMOUTH ENTERPRISE CENTER
 Grafton County Economic Development Council
 Plymouth, New Hampshire

SECOND FLOOR CEILING PLAN A 2.2

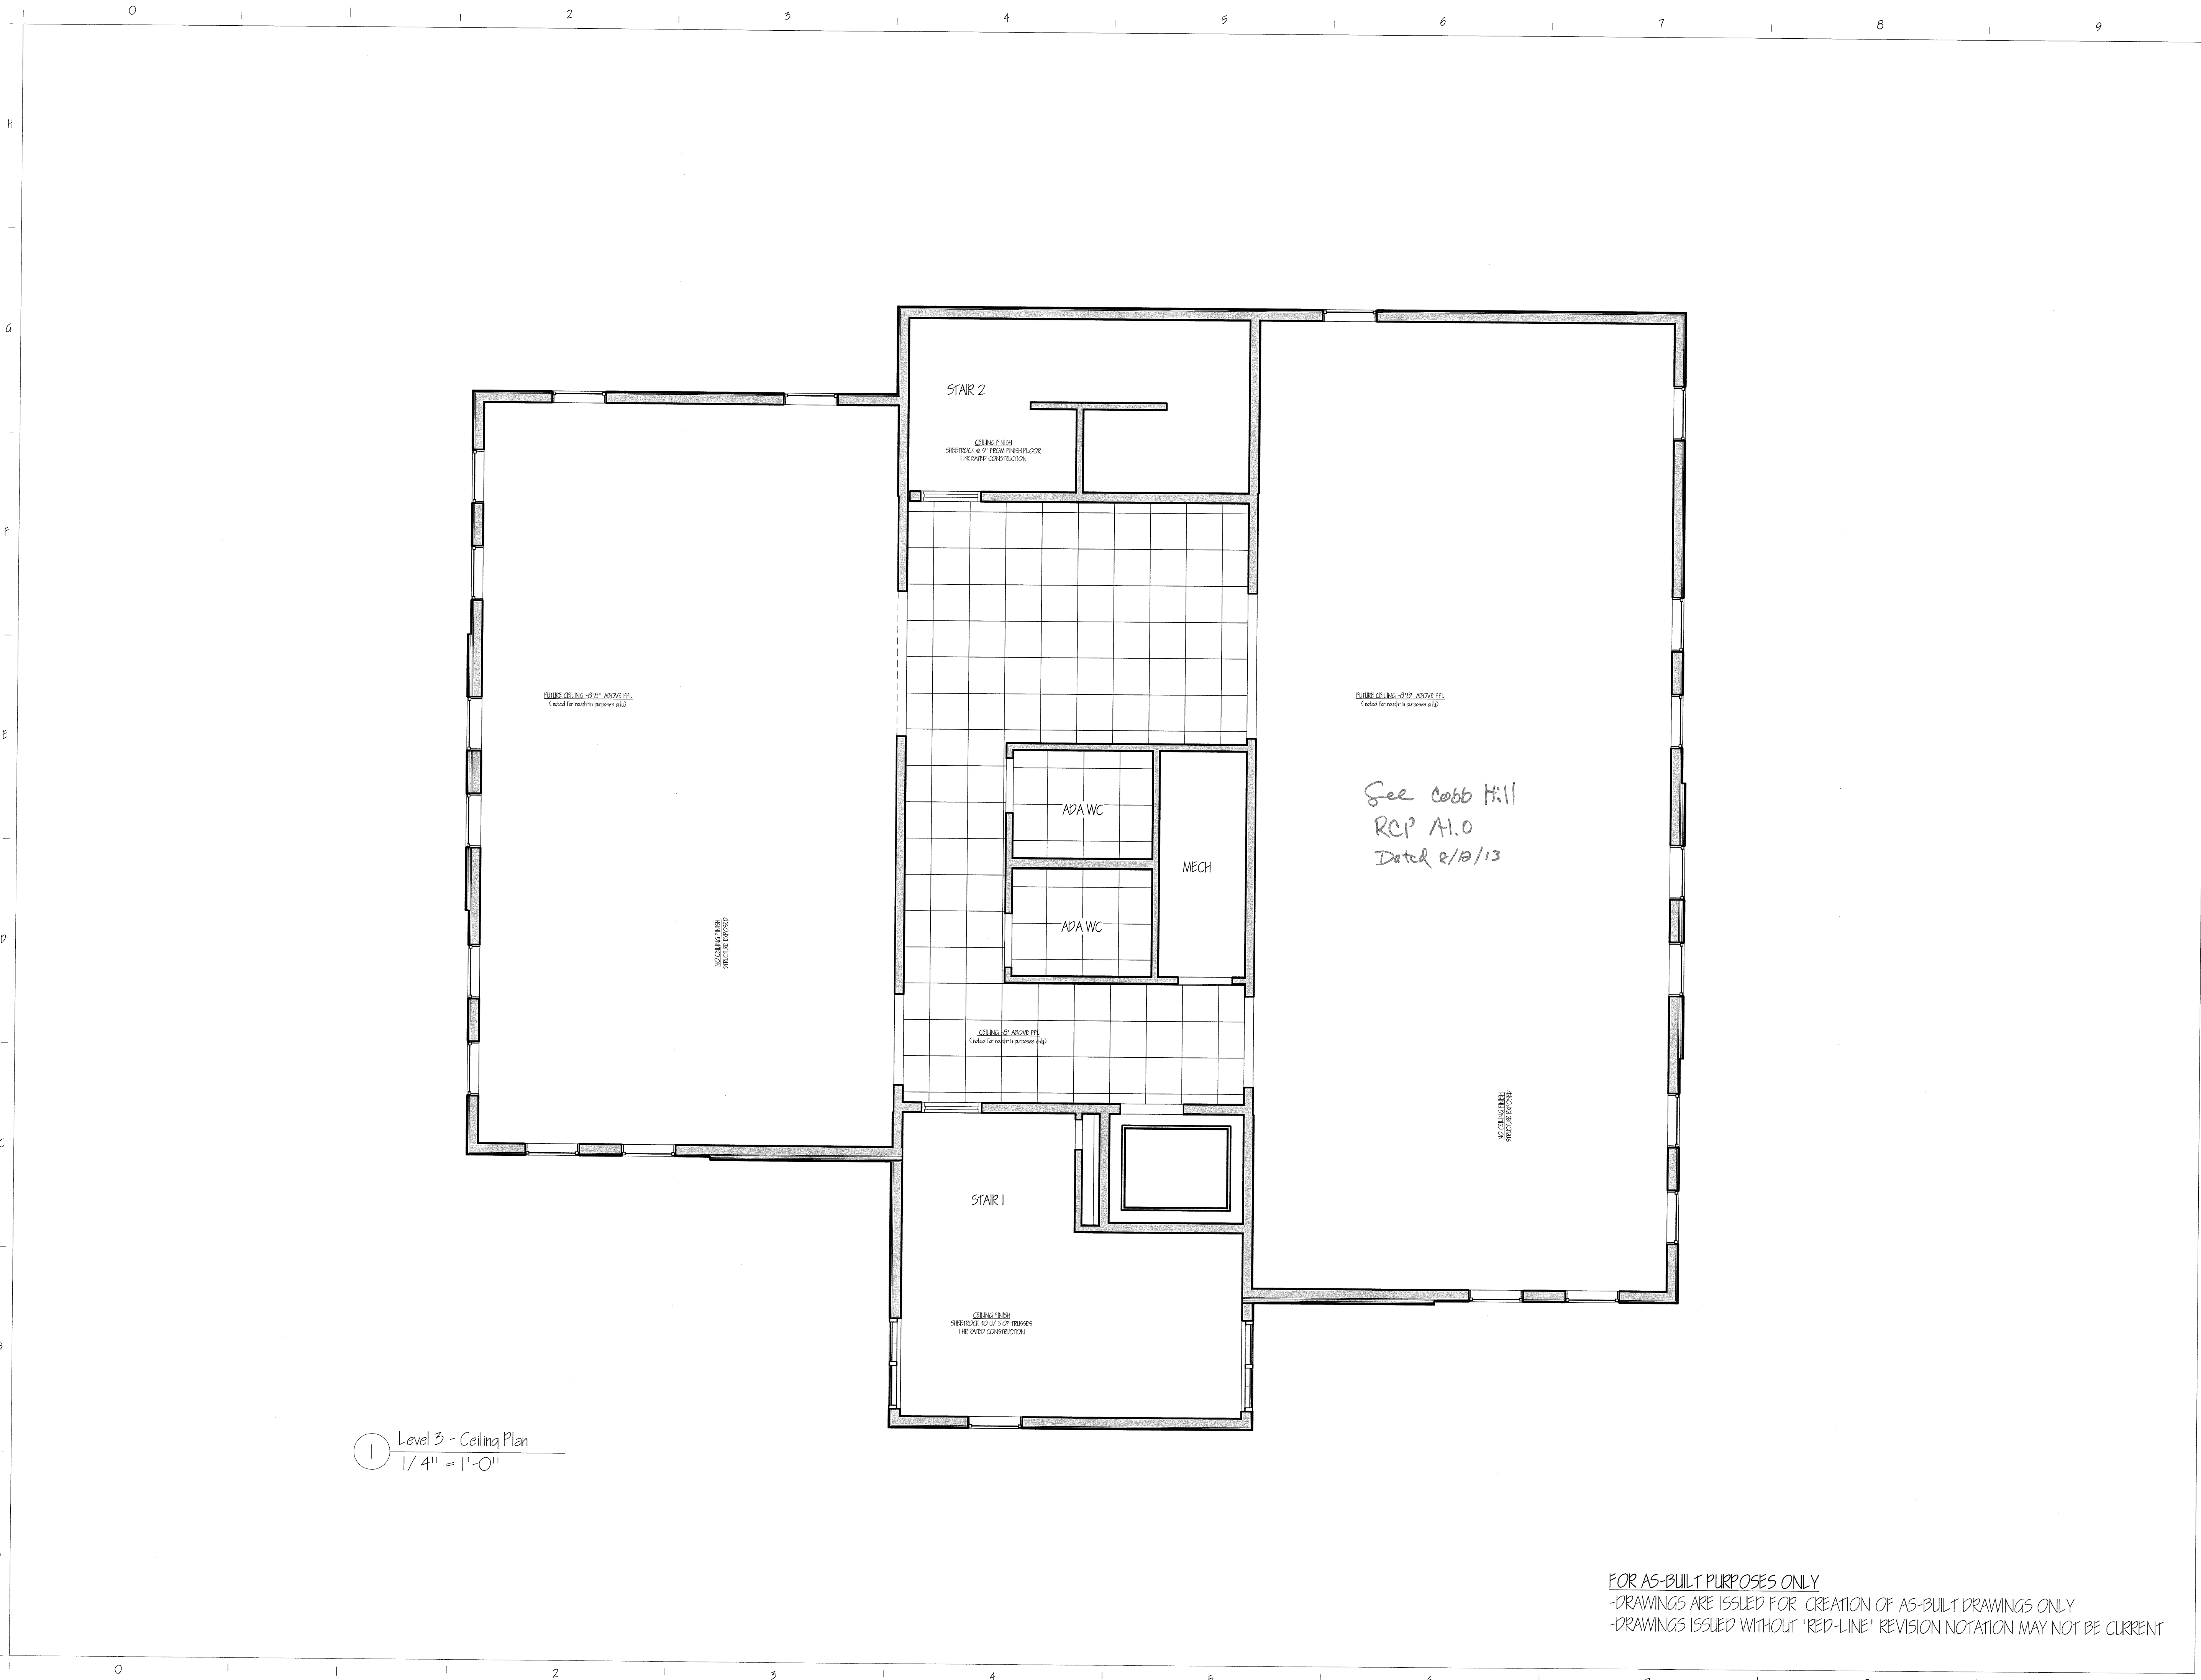

① Level 3 - Ceiling Plan
 1/4" = 1'-0"


See Cobb Hill
 RCP A1.0
 Dated 2/10/13

FOR AS-BUILT PURPOSES ONLY
 -DRAWINGS ARE ISSUED FOR CREATION OF AS-BUILT DRAWINGS ONLY
 -DRAWINGS ISSUED WITHOUT 'RED-LINE' REVISION NOTATION MAY NOT BE CURRENT


GENERAL NOTES:

PROJECT NAME & ADDRESS:
 PLYMOUTH ENTERPRISE CENTER
 Grafton County Economic Development Council
 Plymouth, New Hampshire

THIRD FLOOR CEILING PLAN A 2.3

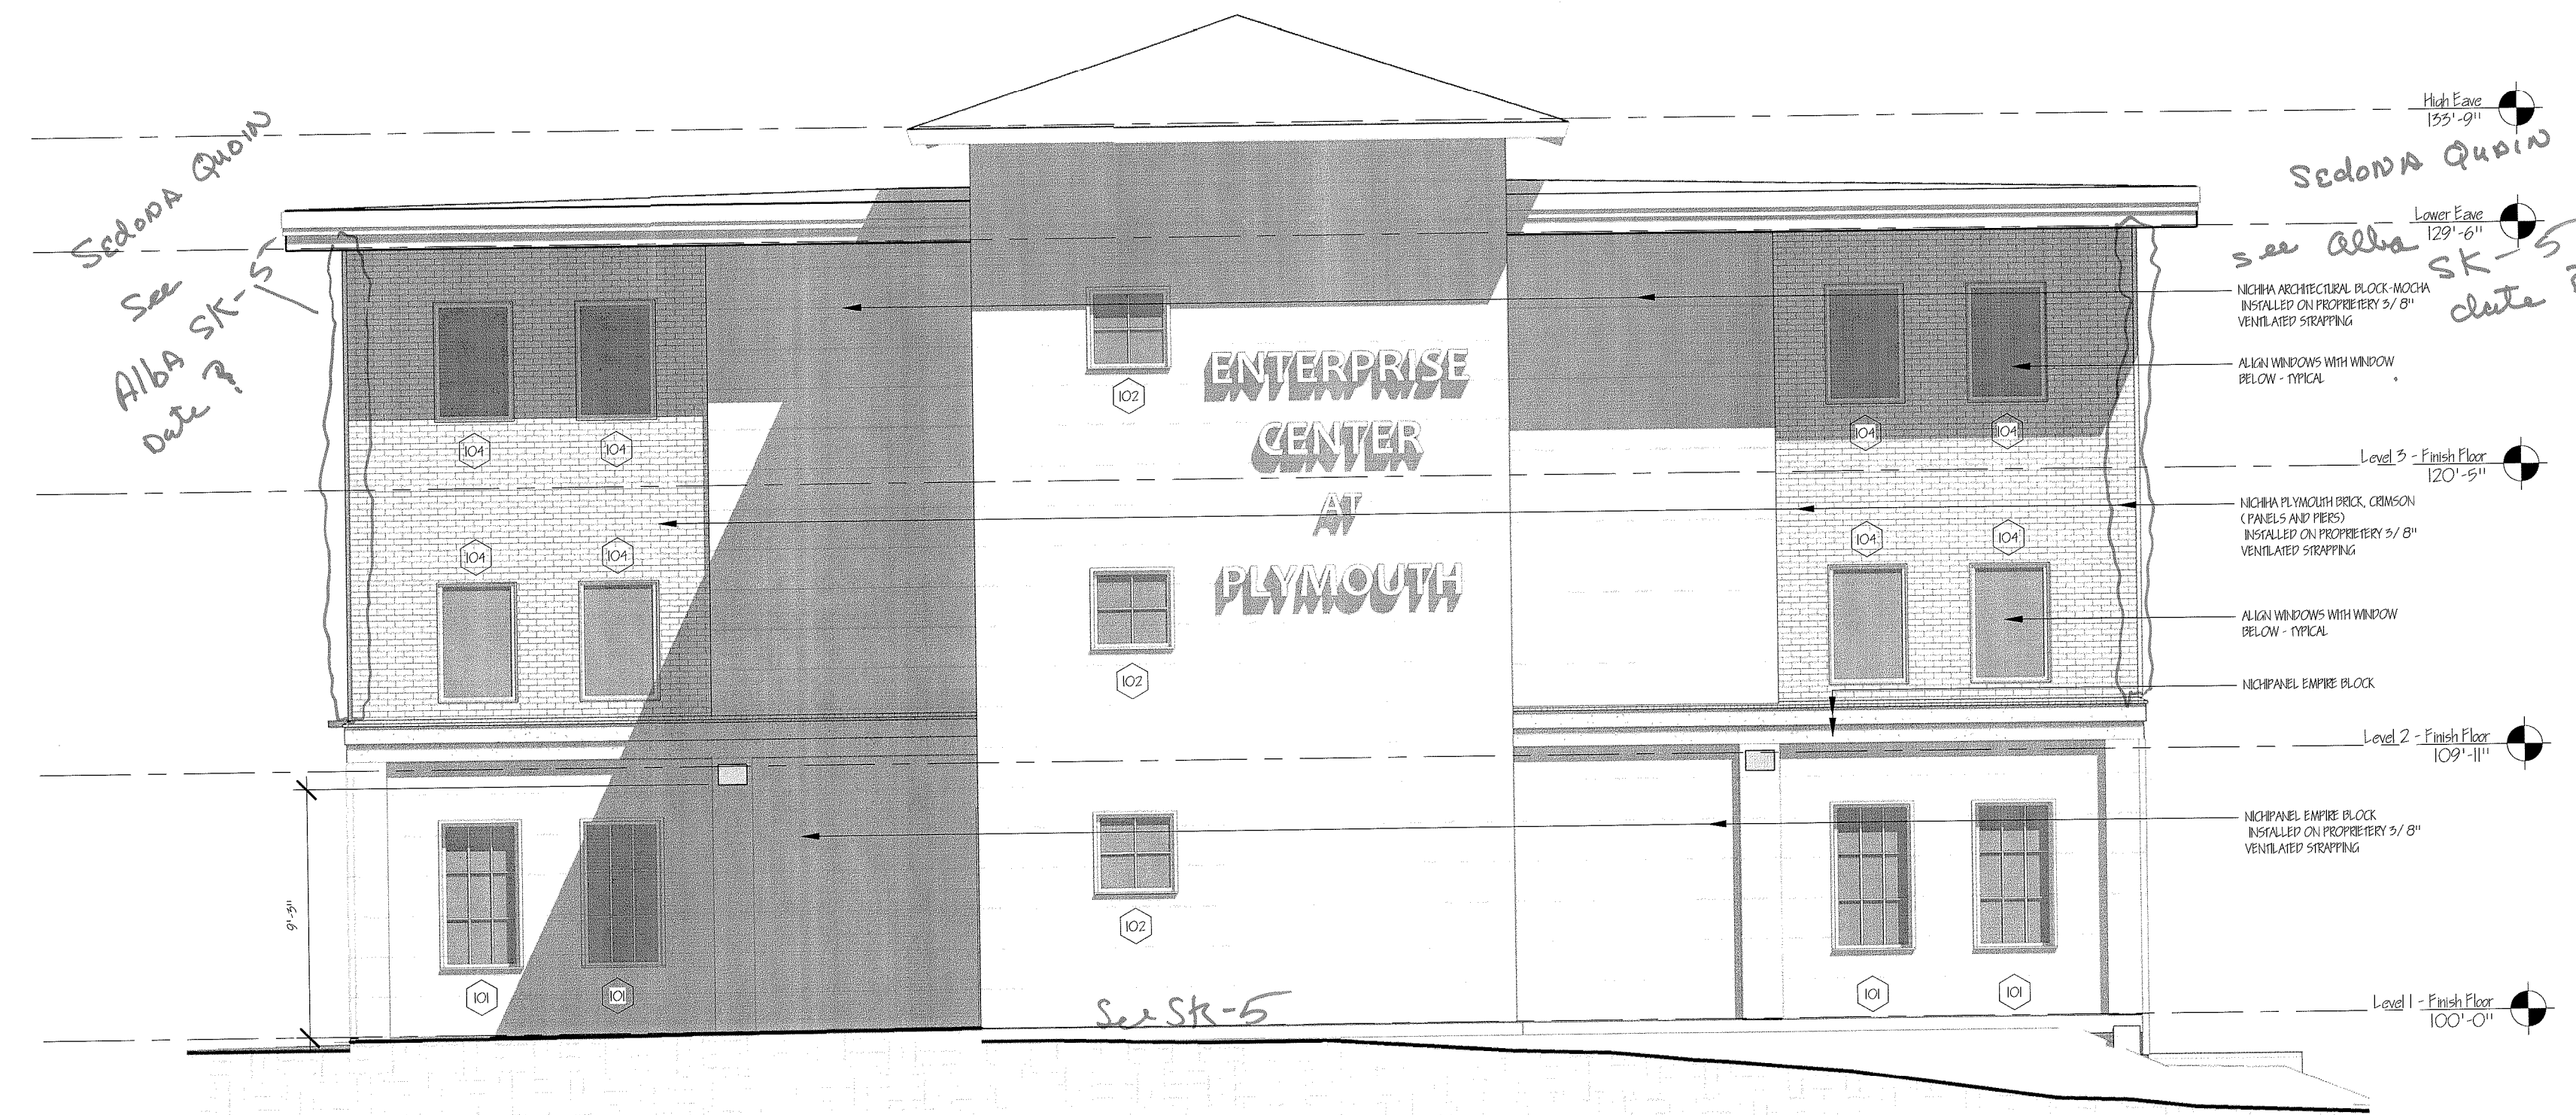

1 South Elevation
3/16" = 1'-0"

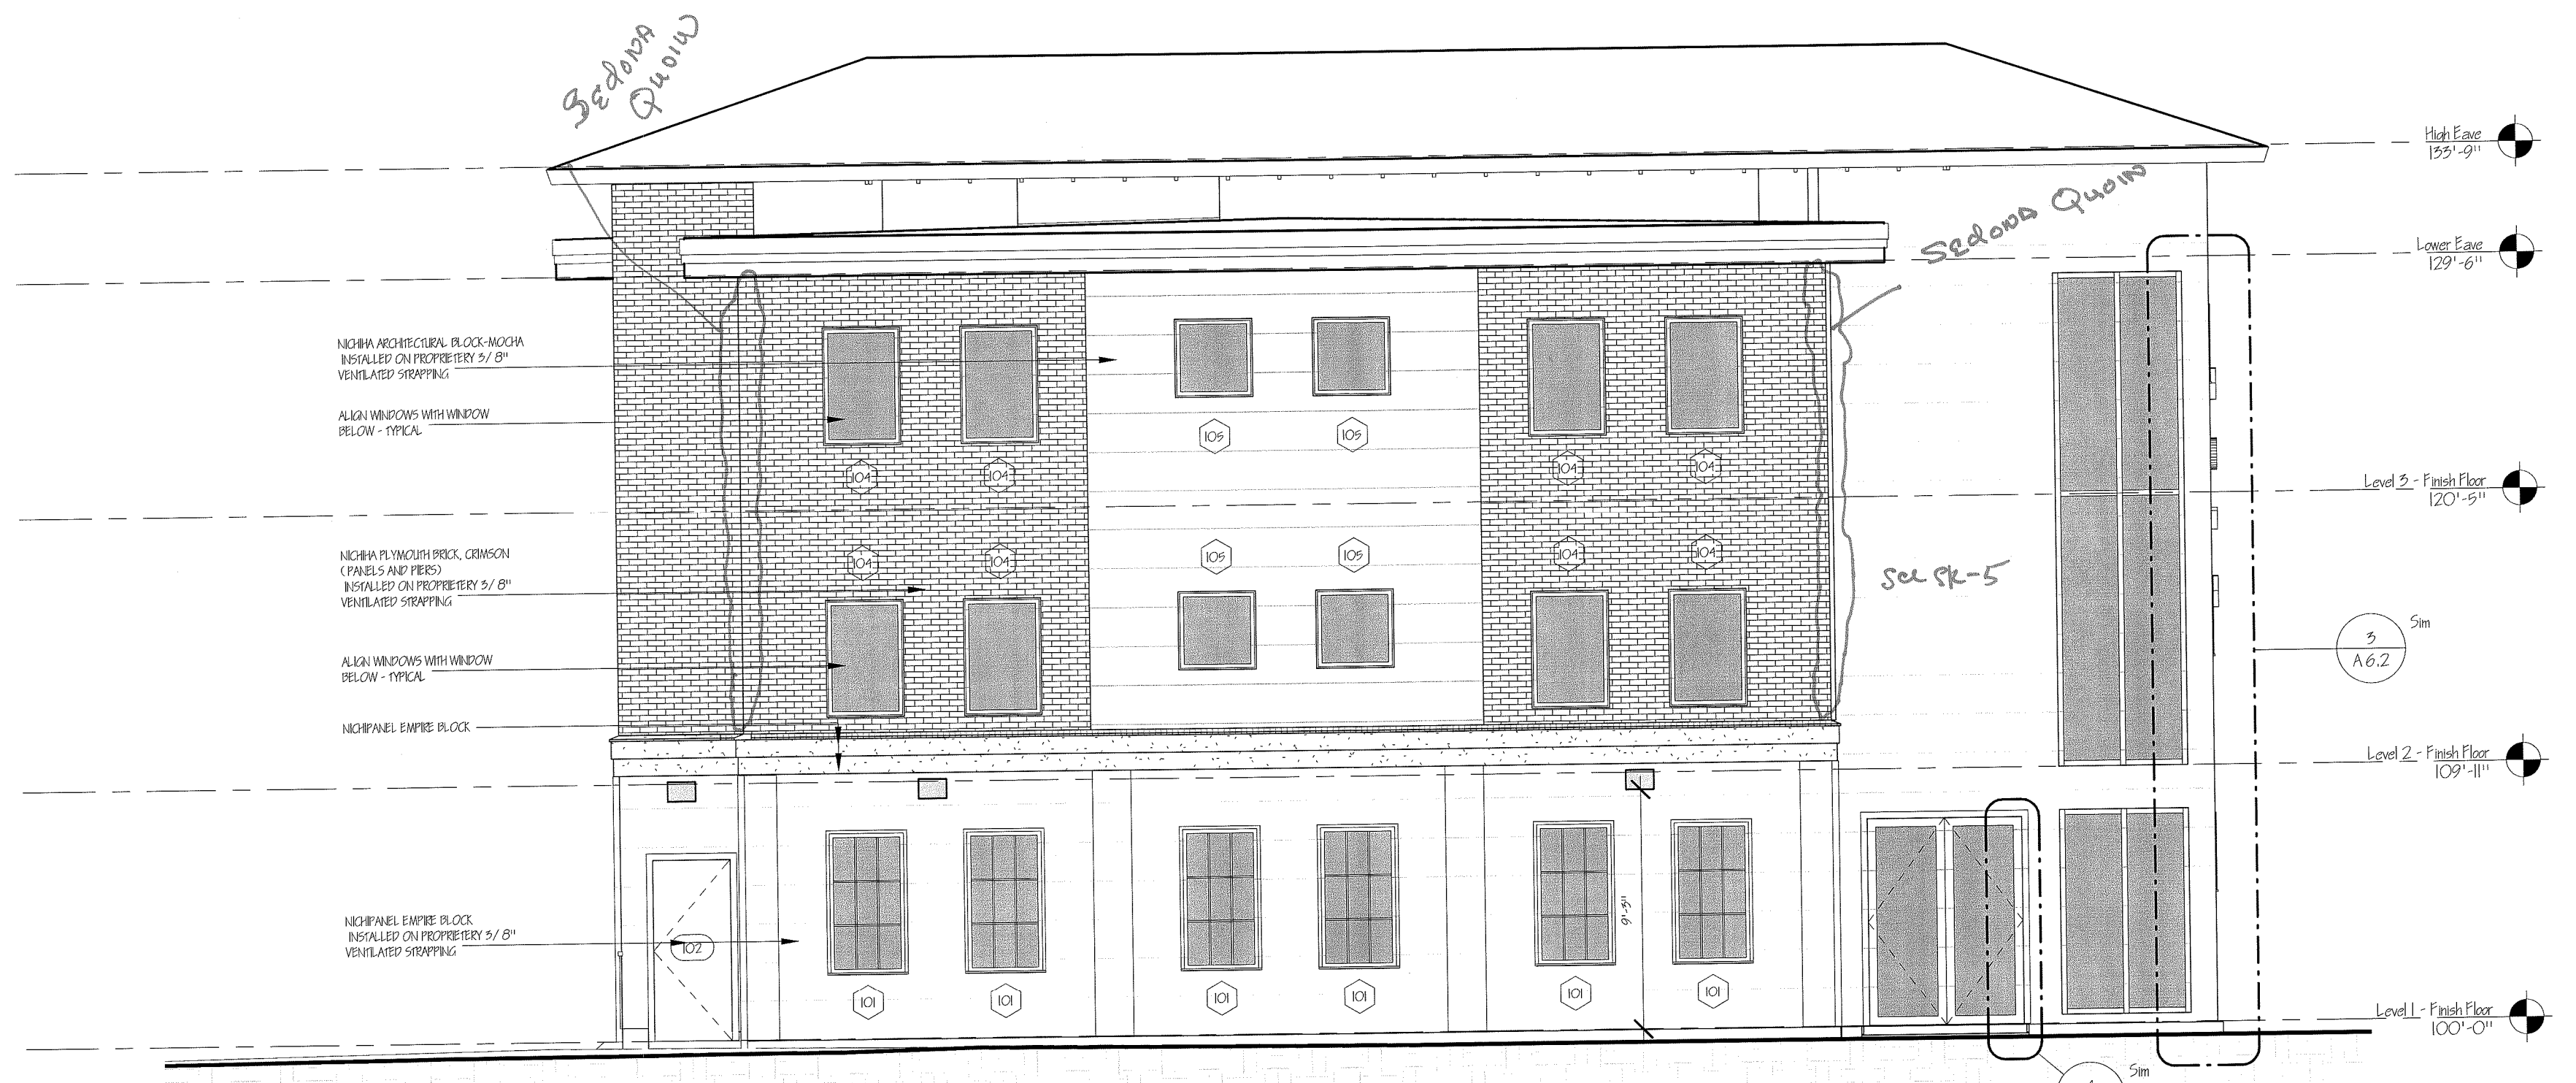

2 West Elevation
3/16" = 1'-0"


FOR AS-BUILT PURPOSES ONLY
-DRAWINGS ARE ISSUED FOR CREATION OF AS-BUILT DRAWINGS ONLY
-DRAWINGS ISSUED WITHOUT 'RED-LINE' REVISION NOTATION MAY NOT BE CURRENT

- GENERAL NOTES:**
- BUILDING CODE:**
1. ALL WORK PERFORMED BY THE CONTRACTOR AND ALL SUB-CONTRACTORS OF THIS PROJECT SHALL COMPLY WITH THE REQUIREMENTS OF THE STATE OF NEW HAMPSHIRE BUILDING CODES (AND ANY AMENDMENTS), THE STATE OF NEW HAMPSHIRE LIFE SAFETY CODE (AND ANY AMENDMENTS), THE TOWN OF WOODSPOCK ZONING REGULATIONS, AND ALL OTHER REGULATIONS AND CODES.
 2. ALL WORK TO COMPLY WITH ADA, ADAAG, LOCK, SEAS & FEDERAL HANDBOOK ACCESSIBILITY REQUIREMENTS.
 3. THE CONTRACTOR HAS BEEN INDICATED ON THE DRAWINGS. IF NO LIMIT HAS BEEN INDICATED THEN THE OWNER, ARCHITECT & GENERAL CONTRACTOR SHOULD REVIEW ON-SITE PRIOR TO CONSTRUCTION.
 4. THE CONTRACTOR SHALL FAMILIARIZE HIMSELF WITH THE CONTRACT DRAWINGS. ANY DISCREPANCIES SHALL BE BROUGHT TO THE ATTENTION OF THE ARCHITECT BEFORE PROCEEDING. THE CONTRACTOR SHALL BE SOLELY RESPONSIBLE FOR ANY AND ALL CONSTRUCTION MEANS, METHODS, TECHNIQUES, SEQUENCES, PROCEDURES, SCHEDULING & SAFETY PROGRAMS NECESSARY TO COMPLETE THE WORK OF THE CONTRACT. PROVIDE ALL TEMPORARY PROTECTIVE & PROTECTIVE NECESSARY TO SAFELY MAINTAIN THE STRUCTURE, INTEGRITY OF NEW AND EXISTING CONSTRUCTION. ALL STRUCTURAL COMPONENTS AND SYSTEMS ARE INSTALLED & APPROVED BY THE OWNER & ARCHITECT.
 5. COORDINATE THE STRUCTURAL, MECHANICAL, AND ELECTRICAL DRAWINGS AND SPECIFICATIONS TO THE ARCHITECTURAL DRAWINGS. IT SHALL BE THE RESPONSIBILITY OF THE CONTRACTOR TO CHECK AND COORDINATE ALL THE DRAWINGS BEFORE PROCEEDING AND/OR INSTALLATION OF ANY WORK. CONTRACTOR SHALL IMMEDIATELY NOTIFY THE ARCHITECT OF ANY DISCREPANCIES OR ERRORS.
 6. ALL STRUCTURE DRAWINGS SHALL BE USED IN CONJUNCTION WITH THE ARCHITECTURAL, MECHANICAL, PLUMBING, AND ELECTRICAL DRAWINGS AND SPECIFICATIONS. VERIFY LOCATION AND DIMENSIONS OF CEMENT BASES, OPENING SLEEVES, BRACKETS, STEPS, BRIDGES, PRESSURES, AND OTHER PROJECT REQUIREMENTS NOT SHOWN ON THE STRUCTURAL DRAWINGS. VERIFY AND COORDINATE ALL DIMENSIONS RELATED TO THIS PROJECT.
 7. UNLESS OTHERWISE INDICATED, DETAILS SHOWN ARE TO BE CONSIDERED TYPICAL FOR SIMILAR CONDITIONS.
 8. IF THERE EXISTS CONFLICTS BETWEEN THE WORK INDICATED IN ANY OF THE DRAWINGS AND/OR ANY CONFLICTS WITH THE SPECIFICATIONS AND/OR CONFLICTS BETWEEN THE DRAWINGS AND SPECIFICATIONS THE MORE COMPLEX OF THE CONFLICTING DRAWINGS SHALL BE FOLLOWED BY THE ARCHITECT.
 9. REFER TO THE SPECIFICATIONS IN THE PROJECT MANUAL FOR ADDITIONAL INFORMATION AND INSTRUCTIONS.
- LEGEND & PRECEDENCE**
10. LEGEND: ALL SYMBOLS AND ABBREVIATIONS USED ON THE DRAWINGS ARE CONSIDERED CONSTRUCTION STANDARDS. IF THE CONTRACTOR HAS ANY QUESTIONS REGARDING THE SAME OR THEIR EXACT MEANING, THE PROJECT SHALL BE ADVISED FOR CLARIFICATION.
 11. PRECEDENCE: DIMENSIONS SHALL HAVE PRECEDENCE OVER SCALE. LARGER SCALE DRAWINGS HAVE PRECEDENCE OVER SMALLER SCALE DRAWINGS. SPECIFICATIONS AND GENERAL NOTES HAVE PRECEDENCE OVER DRAWINGS.
- ADDITIONAL MISC. NOTES**
12. ACCESS PANELS: ALL EQUIPMENT SWITCHES AND VALVES THAT ARE CONCEALED MUST BE PROVIDED WITH ACCESS PANELS BEARING TO WHETHER OR NOT THEY ARE INDICATED IN THE DRAWINGS.
 13. GLASS: ALL GLASS AND GLASS INSTALLATIONS TO CONFORM TO CONSUMER SWEET'S CONSTRUCTION, PRODUCT SAFETY ACT AND ALL CODE REQUIREMENTS.
 14. NO NEW FACILITIES OR EQUIPMENT INTENDERS FOR THE PERMANENT INSTALLATION MAY BE USED FOR TEMPORARY PURPOSES UNLESS THE CONTRACT DOCUMENTS SPECIFICALLY SPECIFY SIZE USE.
 15. ALL ROUGH OPENINGS SHALL BE FIELD VERIFIED PRIOR TO MANUFACTURING OR ORDERING OF ALL WINDOW, EQUIPMENT OR OTHER BUILDING PRODUCTS.
 16. FIRE EXTINGUISHERS SHALL BE INSTALLED IN ACCORDANCE WITH NFPA 10, STANDARD FOR PORTABLE FIRE EXTINGUISHERS.
 17. EMERGENCY LEAVING TO BE PROVIDED IN ACCORDANCE WITH NFPA.
 18. EXISTING BUILDING TO BE SPANNERED IN ACCORDANCE WITH NFPA 10, DRAWINGS, DESIGN AND SPEC TO BE PROVIDED PRIOR TO INSTALLATION.


PROJECT NAME & ADDRESS:
PLYMOUTH ENTERPRISE CENTER
 Greater Cumberland Economic Development Council
 Plymouth, New Hampshire

A 3.1

BUILDING ELEVATIONS

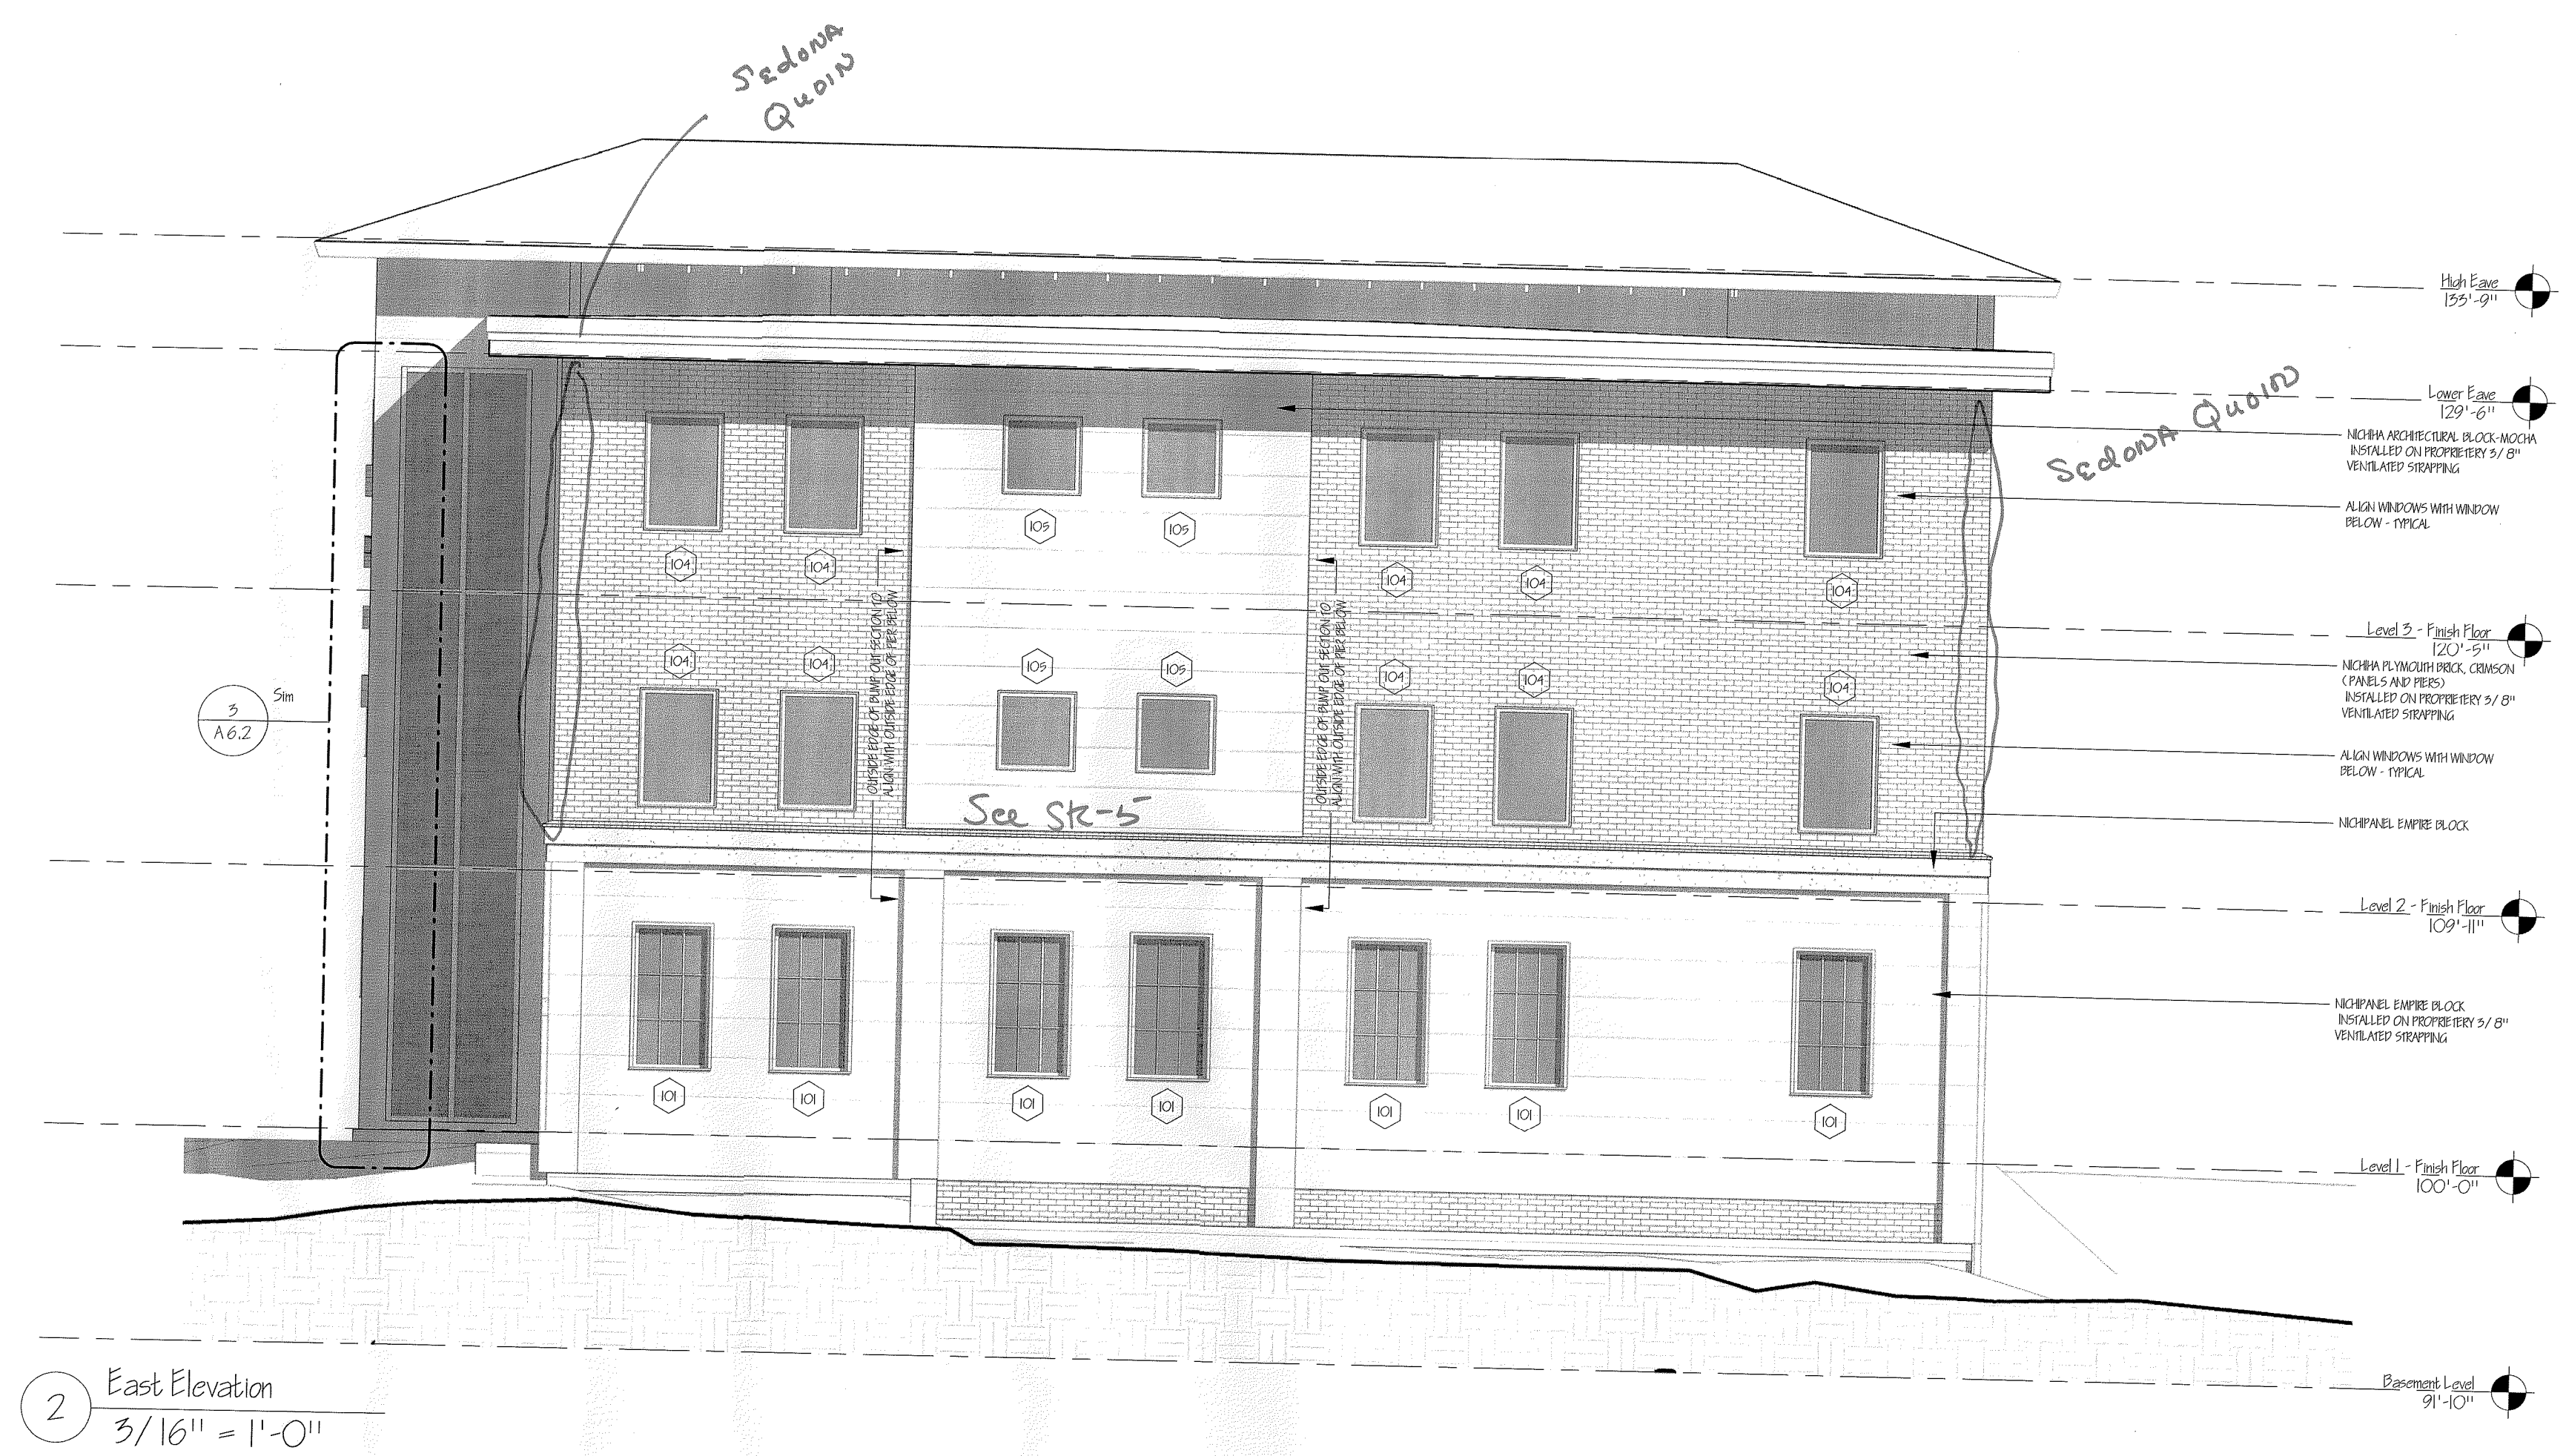

2 East Elevation
3/16" = 1'-0"

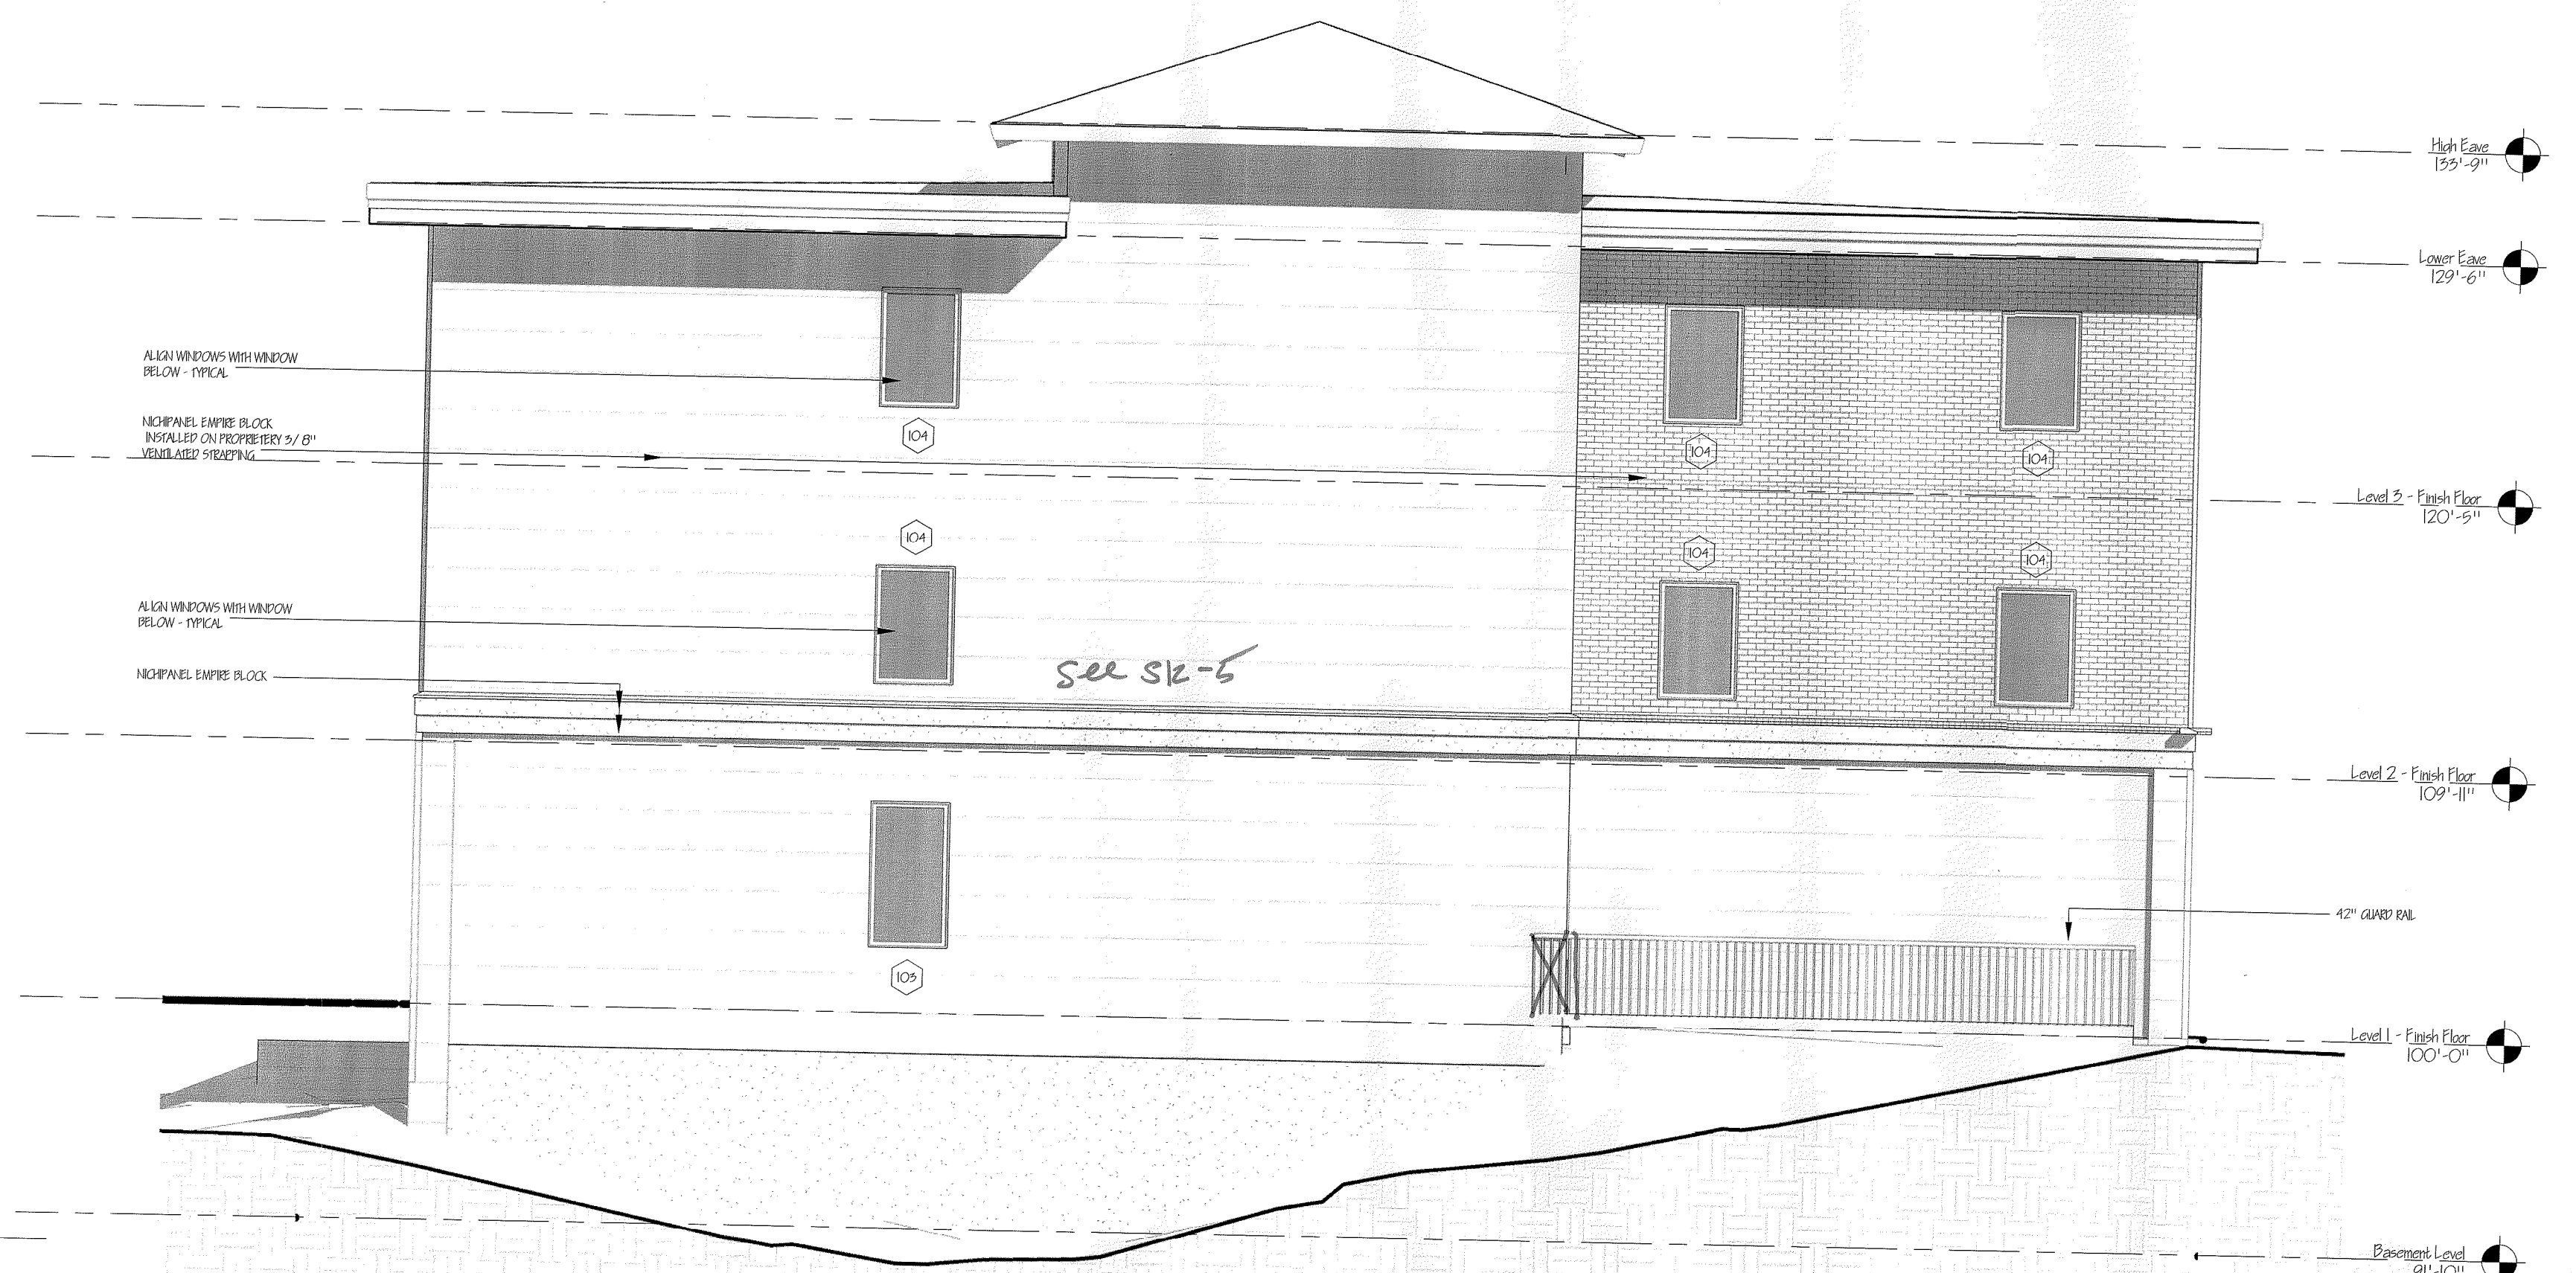

1 North Elevation
3/16" = 1'-0"


FOR AS-BUILT PURPOSES ONLY
-DRAWINGS ARE ISSUED FOR CREATION OF AS-BUILT DRAWINGS ONLY
-DRAWINGS ISSUED WITHOUT 'RED-LINE' REVISION NOTATION MAY NOT BE CURRENT

GENERAL NOTES

- BUILDING CODE**
1. ALL WORK PERFORMED BY THE CONTRACTOR AND ALL SUB-CONTRACTORS OF THIS PROJECT SHALL CONFORM TO THE REQUIREMENTS OF THE STATE OF NEW HAMPSHIRE BUILDING CODES (AND ANY AMENDMENTS), THE STATE OF NEW HAMPSHIRE FIRE SAFETY CODE (AND ANY AMENDMENTS), THE TOWN OF WOODSTOCK ZONING REGULATIONS AND ALL OTHER REGULATIONS AND CODES.
 2. ALL WORK TO COMPLY WITH ANY LOCAL, STATE & FEDERAL UNAPPORTED ACCESSIBILITY REQUIREMENTS.
- CONTRACT & CONTRACT DRAWINGS**
3. THE CONTRACT LIMIT HAS BEEN INDICATED ON THE DRAWINGS. IF NO LIMIT HAS BEEN INDICATED, THE OWNER, ARCHITECT & GENERAL CONTRACTOR SHOULD REVIEW ON-SITE PRIOR TO CONSTRUCTION.
 4. THE CONTRACTOR SHALL FAMILIARIZE HIMSELF WITH THE CONTRACT DRAWINGS. ANY DISCREPANCIES SHALL BE BROUGHT TO THE ATTENTION OF THE ARCHITECT BEFORE PROCEEDING. THE CONTRACTOR SHALL BE SOLELY RESPONSIBLE FOR ANY AND ALL CONSTRUCTION MEANS, METHODS, SEQUENCES, PROCEDURES, SCHEDULE SHEET PREPARATIONS RELIANT TO COMPLETE THE WORK OF THIS CONTRACT. PROVIDE ALL NECESSARY BRACING & SHORING NECESSARY TO SAFELY MAINTAIN THE STRUCTURAL INTEGRITY OF NEW AND EXISTING CONSTRUCTION UNTIL ALL STRUCTURAL COMPONENTS AND SYSTEMS ARE INSTALLED & APPROVED BY THE OWNER OR ARCHITECT.
 5. COORDINATION OF STRUCTURAL, MECHANICAL, AND ELECTRICAL DRAWINGS ARE SUPPLEMENTARY TO THE ARCHITECTURAL DRAWINGS. IF THERE BE THE RESPONSIBILITY OF THE CONTRACTOR TO CHECK AND COORDINATE ALL THE DRAWINGS BEFORE THE FOUNDATION AND/OR INSTALLATION OF ANY WORK. CONTRACTOR SHALL IMMEDIATELY NOTIFY THE ARCHITECT OF ANY DISCREPANCIES OR ERRORS.
 6. ALL STRUCTURAL DRAWINGS SHALL BE USED IN CONJUNCTION WITH THE MECHANICAL, MECHANICAL, PLUMBING AND ELECTRICAL DRAWINGS AND SPECIFICATIONS, VENTILATION, AND DIMENSIONS OF CHASES, INSERTS, SLEEVES, WIRES, PIPES, DUCTS, REFRIGERATION, AND OTHER PROJECT REQUIREMENTS NOT SHOWN ON THE STRUCTURAL DRAWINGS. SORT AND COORDINATE ALL DIMENSIONS RELATED TO THIS PROJECT.
 7. UNLESS OTHERWISE INDICATED, DETAILS SHOWN ARE TO BE CONSIDERED TYPICAL FOR SIMILAR CONDITIONS.
 8. IF THERE EXISTS CONFLICTS BETWEEN THE WORK INDICATED IN ANY OF THE DRAWINGS AND/OR ANY CONFLICTS WITHIN THE SPECIFICATIONS AND/OR CONFLICTS BETWEEN THE DRAWINGS AND SPECIFICATIONS, THE MORE COMPLEX OF THE CONFLICTING REQUIREMENTS SHALL BE INCLUDED IN THE PER OR PROVISION.
 9. REFER TO THE SPECIFICATIONS IN THE PROJECT MANUAL FOR ADDITIONAL INFORMATION AND INSTRUCTIONS.
- LEGEND & PREFERENCE**
10. LEGEND: ALL SYMBOLS AND ABBREVIATIONS USED ON THE DRAWINGS ARE CONSIDERED CONSTRUCTION STANDARDS. IF THE CONTRACTOR HAS ANY QUESTIONS REGARDING THE SAME OR THEIR EXACT MEANING, THE ARCHITECT SHALL BE NOTIFIED FOR CLARIFICATION.
 11. PREFERENCE: DIMENSIONS SHALL HAVE PREFERENCE OVER SCALE. LARGER SCALE DRAWINGS HAVE PREFERENCE OVER SMALLER SCALE DRAWINGS. SPECIFICATIONS AND GENERAL NOTES TAKE PREFERENCE OVER DRAWINGS.
- ADDITIONAL SPEC. NOTES**
12. ACCESS PANELS: ALL EQUIPMENT SWITCHES, AND VALVES THAT ARE CONCEALED MUST BE PROVIDED WITH ACCESS PANELS UNLESS OTHERWISE INDICATED BY THE DRAWINGS.
 13. GLASS: ALL GLASS AND GLASS INSTALLATIONS TO CONFORM TO CONSUMER SAFETY COMMISSIONAL PRODUCT SAFETY ACT AND ALL CODES REQUIREMENTS.
 14. NO NEW FACILITIES OR EQUIPMENT INSTALLED FOR THE PERMANENT INSTALLATION MAY BE USED FOR TEMPORARY SPECIFIC PURPOSES.
 15. ALL ROUGH OPENINGS SHALL BE FIELD VERIFIED PRIOR TO MANUFACTURING OR ORDERING OF ALL POOR, WINDOW, EQUIPMENT OR OTHER BUILDING PRODUCTS.
 16. FIRE EXTINGUISHERS SHALL BE INSTALLED IN ACCORDANCE WITH NFPA 10, STANDING FOR PORTABLE FIRE EXTINGUISHERS.
 17. EMERGENCY LIGHTING TO BE PROVIDED IN ACCORDANCE WITH NFPA.
 18. ENTIRE BUILDING TO BE SPRINKLERED IN ACCORDANCE WITH NFPA 13. DRAWINGS, DESIGN AND SPEC TO BE PROVIDED PRIOR TO INSTALLATION.

PROJECT NAME & ADDRESS:
PLYMOUTH ENTERPRISE CENTER
Graton Community Economic Development Council
Plymouth, New Hampshire

A 3.2
BUILDING ELEVATIONS

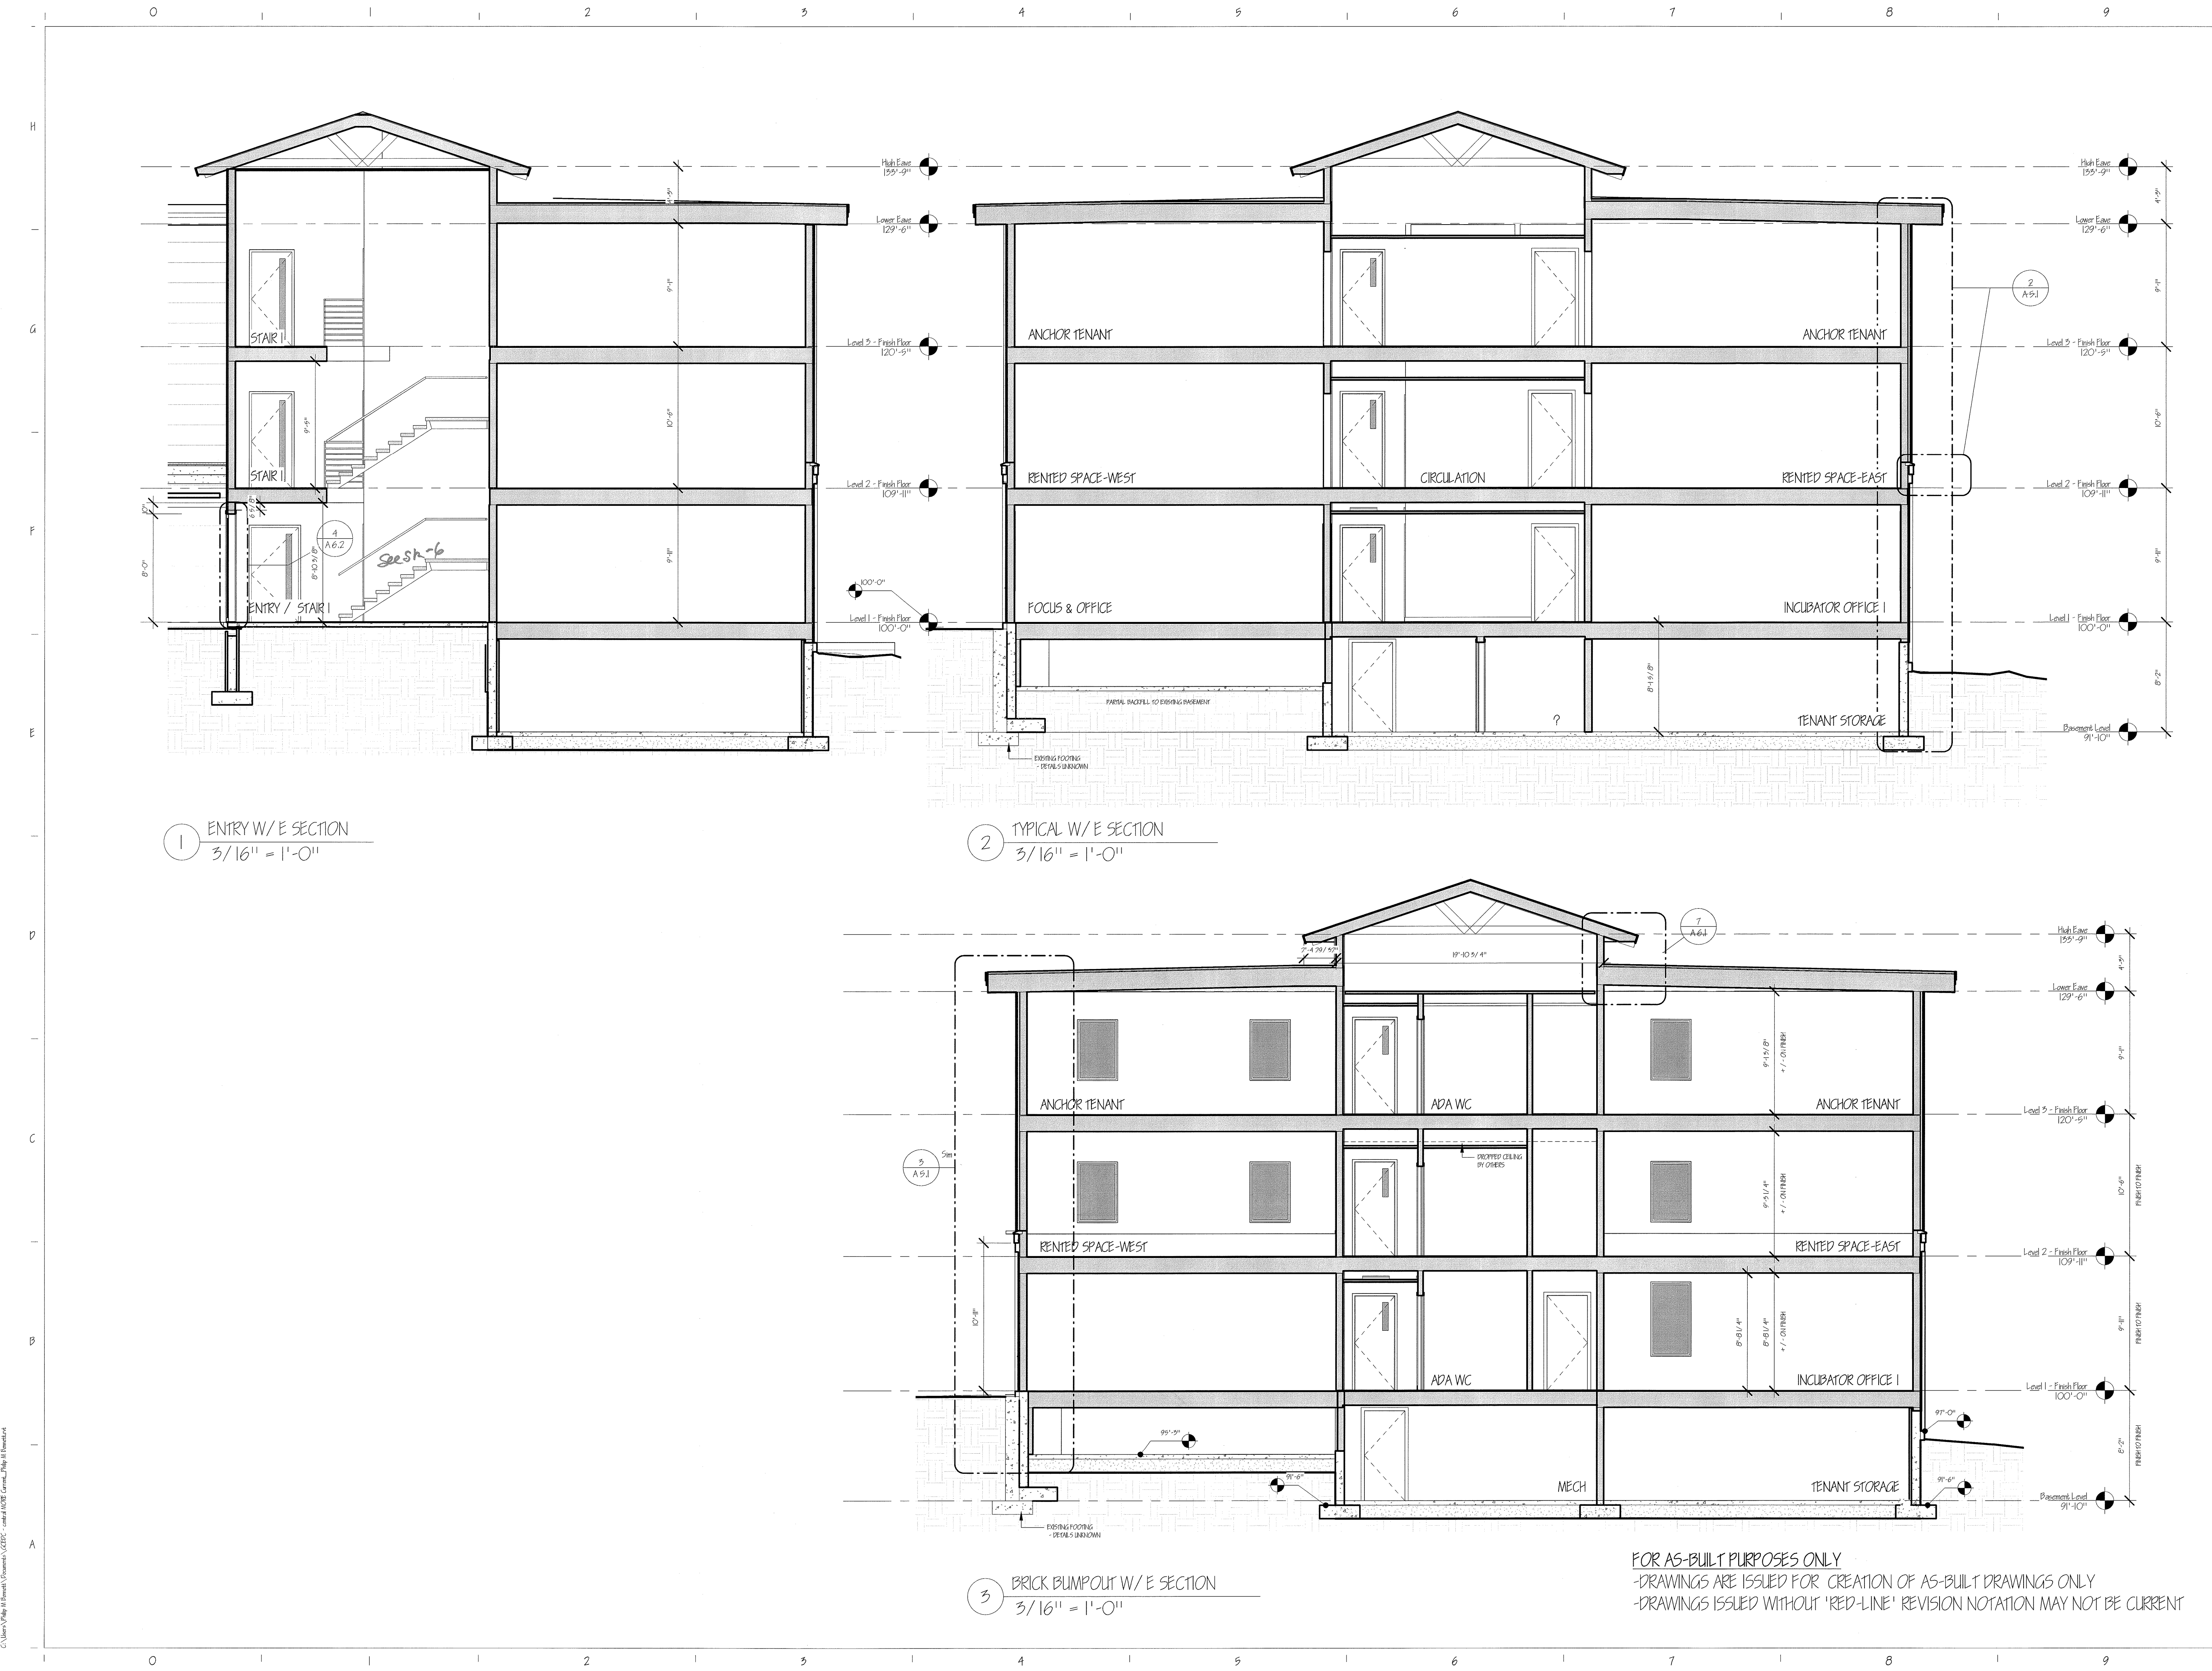

1 ENTRY W/E SECTION
3/16" = 1'-0"

2 TYPICAL W/E SECTION
3/16" = 1'-0"

3 BRICK BUMPOUT W/E SECTION
3/16" = 1'-0"

FOR AS-BUILT PURPOSES ONLY
-DRAWINGS ARE ISSUED FOR CREATION OF AS-BUILT DRAWINGS ONLY
-DRAWINGS ISSUED WITHOUT 'RED-LINE' REVISION NOTATION MAY NOT BE CURRENT

GENERAL NOTES:

BUILDING CODES

1. ALL WORK PERFORMED BY THE CONTRACTOR AND ALL SUB-CONTRACTORS OF THIS PROJECT SHALL CONFORM TO THE REQUIREMENTS OF THE STATE OF NEW HAMPSHIRE BUILDING CODES (AND ANY AMENDMENTS), THE STATE OF NEW HAMPSHIRE LIFE SAFETY CODE (AND ANY AMENDMENTS), THE TOWN OF WOODSTOCK ZONING REGULATIONS, AND ALL OTHER REGULATORY AND CODES.
2. ALL WORK TO COMPLY WITH ANY APPLICABLE LOCAL, STATE & FEDERAL HANDICAPPED ACCESSIBILITY REQUIREMENTS.
3. THE CONTRACTOR SHALL BE RESPONSIBLE FOR OBTAINING ALL NECESSARY PERMITS AND APPROVALS FROM THE TOWN OF WOODSTOCK.
4. THE CONTRACTOR SHALL FAMILIARIZE HIMSELF WITH THE CONTRACT DRAWINGS AND SPECIFICATIONS SHALL BE PROVIDED TO THE ARCHITECT BEFORE PROCEEDING. THE CONTRACTOR SHALL BE SOLELY RESPONSIBLE FOR ANY AND ALL CONSTRUCTION METHODS, MEANS, PROCEDURES, SEQUENCES, SCHEDULES, AND PROCEDURES, AND SHALL BE RESPONSIBLE TO COMPLETE THE WORK OF THIS CONTRACT, PROVIDE ALL REMOVAL WORKING AND WORK NECESSARY TO SAFELY MAINTAIN THE STRUCTURAL INTEGRITY OF ANY EXISTING CONSTRUCTION UNTIL ALL STRUCTURAL COMPONENTS AND SYSTEMS ARE INSTALLED & APPROVED BY THE OWNER OR ARCHITECT.
5. COOPERATION: THE STRUCTURAL, MECHANICAL, AND ELECTRICAL DRAWINGS ARE SUPPLEMENTARY TO THE ARCHITECTURAL DRAWINGS. IT SHALL BE THE RESPONSIBILITY OF THE CONTRACTOR TO CHECK AND COORDINATE ALL THE DRAWINGS BEFORE PROCEEDING AND TO NOTIFY THE ARCHITECT OF ANY CONFLICTS OR INCONSISTENCIES. THE CONTRACTOR SHALL IMMEDIATELY NOTIFY THE ARCHITECT OF ANY CONFLICTS OR ERRORS.
6. ALL STRUCTURAL DRAWINGS SHALL BE USED IN CONJUNCTION WITH THE ARCHITECTURAL, MECHANICAL, PLUMBING, AND ELECTRICAL DRAWINGS AND SPECIFICATIONS. VERIFY LOCATION AND DIMENSIONS OF CHIMNEYS, ROOFS, OPENINGS, SLATES, WALLS, CEILING, REVISIONS, ETC. BEFORE ANY OTHER PROJECT REQUIREMENTS NOT SHOWN ON THE STRUCTURAL DRAWINGS. VERIFY AND COORDINATE ALL DIMENSIONS RELATED TO THIS PROJECT.
7. UNLESS OTHERWISE INDICATED, DETAILS SHOWN ARE TO BE CONSIDERED TYPICAL FOR SIMILAR CONDITIONS.
8. IF THERE ARE CONFLICTS BETWEEN THE WORK INDICATED IN ANY OF THE DRAWINGS AND/OR ANY CONFLICTS WITH THE SPECIFICATIONS, ANY OR CONFLICTS BETWEEN THE DRAWINGS AND SPECIFICATIONS, THE ARCHITECT SHALL BE THE DECIDING AUTHORITY. ALL DIMENSIONS SHALL BE INDICATED IN THE DRAWINGS OR NOTATION.
9. REFER TO THE SPECIFICATIONS IN THE PROJECT MANUAL FOR ADDITIONAL INFORMATION AND RESTRICTIONS.

LEGEND & PRECEDENCE

10. LEGEND: ALL SYMBOLS AND ABBREVIATIONS USED ON THE DRAWINGS ARE CONSIDERED CONVENTIONAL STANDARDS. IF THE CONTRACTOR HAS ANY QUESTIONS REGARDING THE SAME OR THEIR EXACT MEANING, THE ARCHITECT SHALL BE NOTIFIED FOR CLARIFICATION.
11. PRECEDENCE: DIMENSIONS SHALL HAVE PRECEDENCE OVER SCALE. LARGER SCALE DRAWINGS HAVE PRECEDENCE OVER SMALLER SCALE DRAWINGS. SPECIFICATIONS AND GENERAL NOTES TAKE PRECEDENCE OVER DRAWINGS.


ADDITIONAL MECH. NOTES

12. ACCESS PANELS: ALL EQUIPMENT SWITCHES AND VALVES THAT ARE CONCEALED MUST BE PROVIDED WITH ACCESS PANELS REQUIRED WHERE THEY ARE NOT SHOWN IN THE DRAWINGS.
13. GLASS: ALL GLASS AND GLASS INSTALLATIONS TO CONFORM TO CONSUMER-SWIFT COMMERCIAL PRODUCT SAFETY ACT AND ALL CODE REQUIREMENTS.
14. NO NEW FACILITIES OR EQUIPMENT INSTALLED FOR THE PERMANENT INSTALLATION MAY BE USED FOR TEMPORARY PURPOSES UNLESS THE CONTRACT DOCUMENTS SPECIFICALLY SPECIFY THAT USE.
15. ALL ROUGH OPENINGS SHALL BE FIELD VERIFIED PRIOR TO MANUFACTURING OR ORDERING OF ALL DOOR, WINDOW, EQUIPMENT OR OTHER BUILDING PRODUCTS.
16. THE EXTINGUISHERS SHALL BE INSTALLED IN ACCORDANCE WITH NFPA 12, STANDARD FOR PORTABLE FIRE EXTINGUISHERS.
17. EMERGENCY LIGHTING TO BE PROVIDED IN ACCORDANCE WITH NFPA.
18. ENTIRE BUILDING TO BE SPARKLEPROOF IN ACCORDANCE WITH NFPA 15, DRAWINGS, DESIGN AND SPEC. TO BE PROVIDED PRIOR TO INSTALLATION.


Copyright © 2019 by alba architects

PROJECT NAME & ADDRESS:
PL YMOUQUH ENTERPRISE CENTER
Grafton County Economic Development Council
Plymouth, New Hampshire

BUILDING SECTIONS
A 4.1

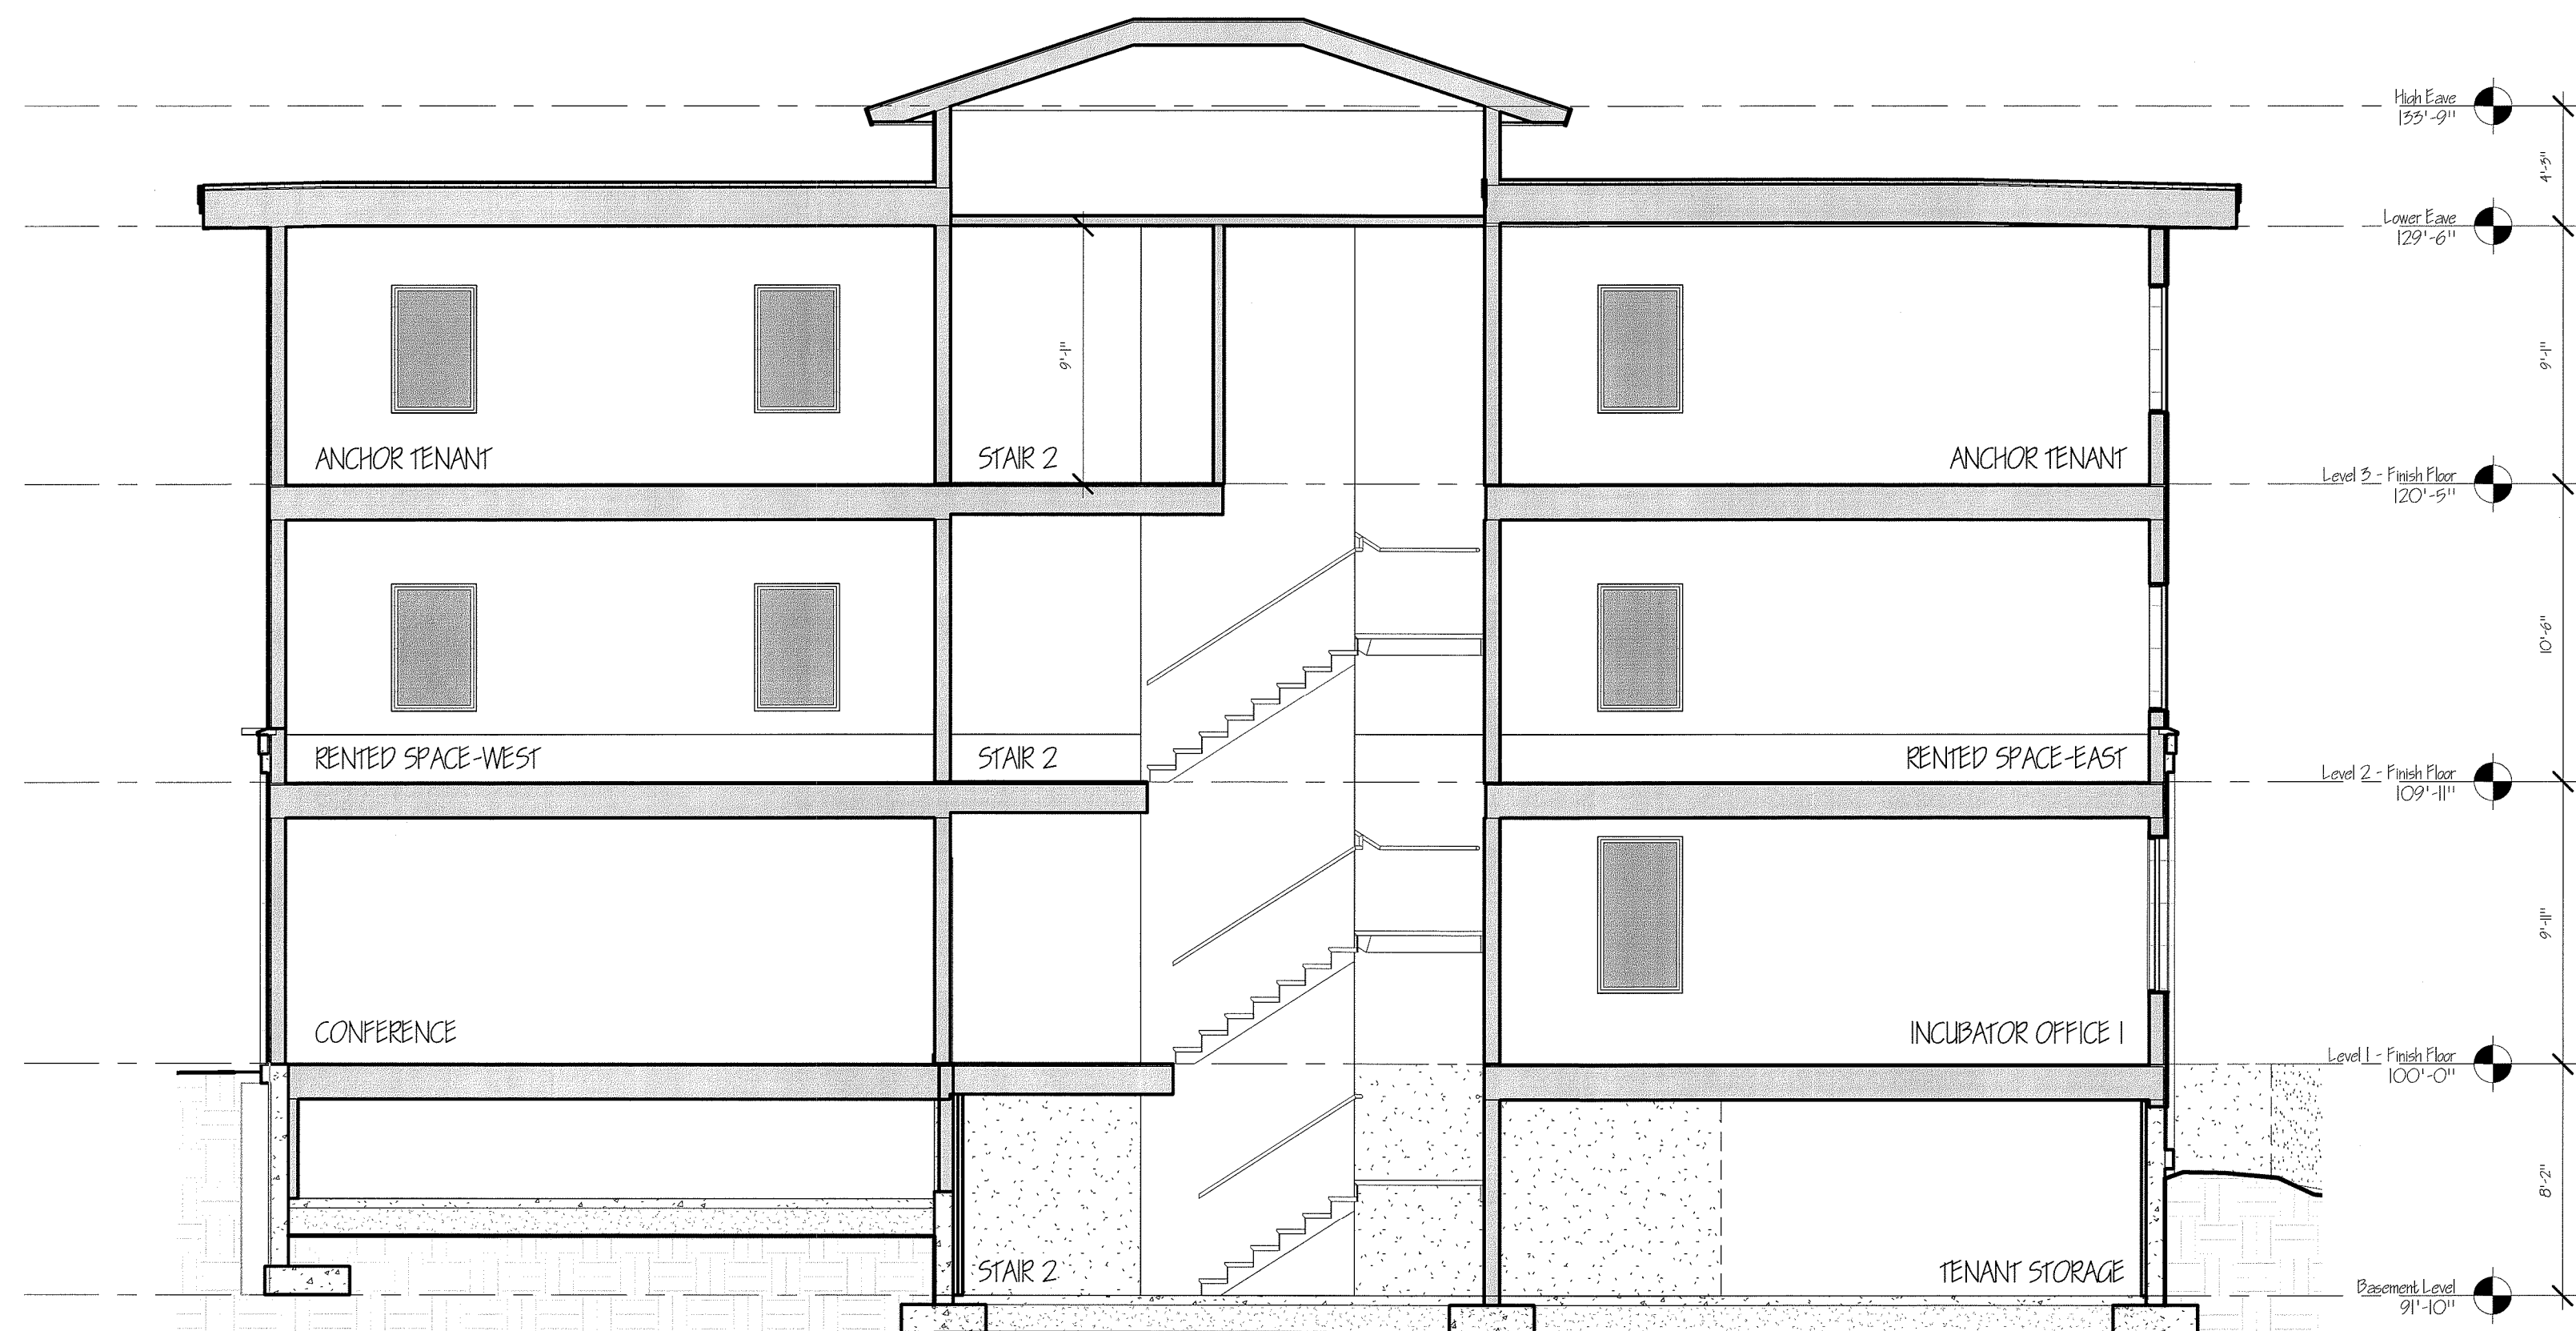

1 STAIR 2 W/E SECTION
3/16" = 1'-0"

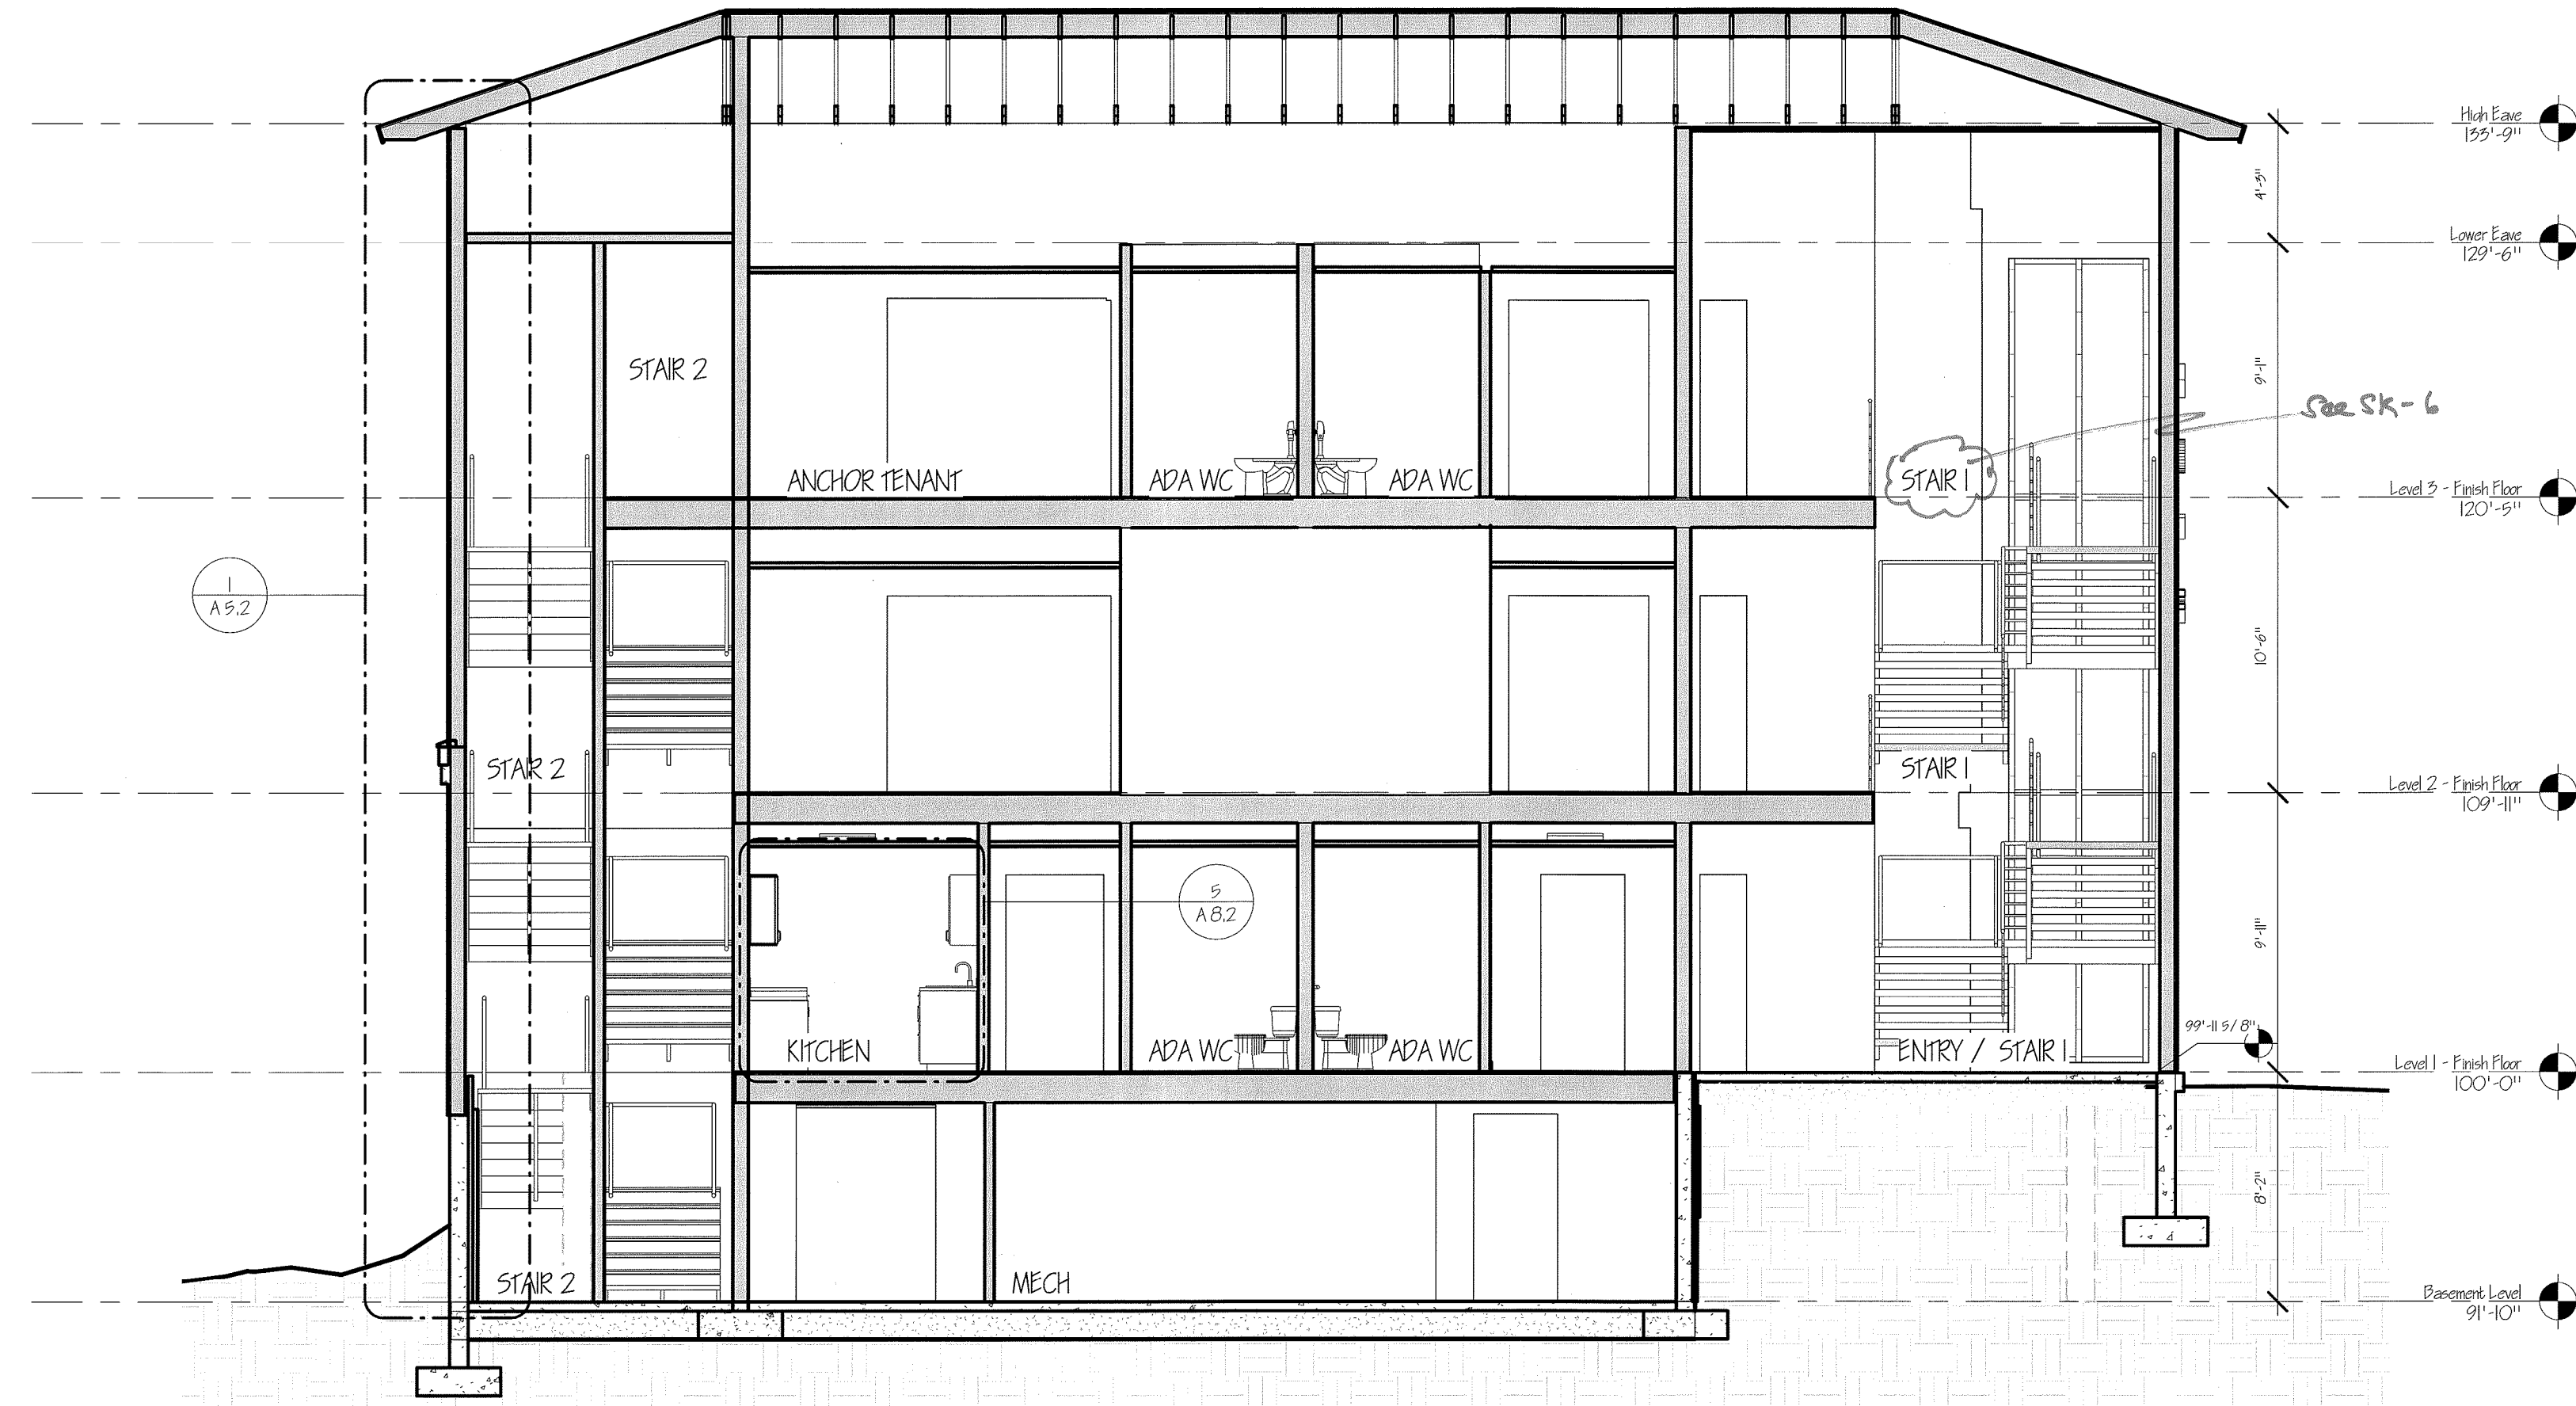

3 CORE N/S SECTION
3/16" = 1'-0"


FOR AS-BUILT PURPOSES ONLY
-DRAWINGS ARE ISSUED FOR CREATION OF AS-BUILT DRAWINGS ONLY
-DRAWINGS ISSUED WITHOUT 'RED-LINE' REVISION NOTATION MAY NOT BE CURRENT

- GENERAL NOTES:**
- BUILDING CODE:**
1. ALL WORK PERFORMED BY THE CONTRACTOR AND ALL SUB-CONTRACTORS OF THIS PROJECT SHALL CONFORM TO THE REQUIREMENTS OF THE STATE OF NEW HAMPSHIRE BUILDING CODE AND ANY AMENDMENTS, THE STATE OF NEW HAMPSHIRE LIFE SAFETY CODE (AND ANY AMENDMENTS), THE TOWN OF WOODRIDGE ZONING REGULATIONS, AND ALL OTHER REGULATIONS AND CODES.
 2. ALL WORK TO COMPLY WITH ADA, ASHRAE, LOCAL, STATE & FEDERAL HANDICAPPED ACCESSIBILITY REQUIREMENTS.
 3. THE CONTRACT LINES HAVE BEEN INDICATED ON THE DRAWINGS. IF NO LINE HAS BEEN INDICATED THEN THE OWNER, ARCHITECT & GENERAL CONTRACTOR SHALL REVIEW ON-SITE PRIOR TO CONSTRUCTION.
 4. THE CONTRACTOR SHALL FAMILIARIZE HIMSELF WITH THE CONTRACT DRAWINGS AND SPECIFICATIONS. THE CONTRACTOR SHALL BE SOLELY RESPONSIBLE FOR ANY AND ALL CONSTRUCTION MEANS, METHODS, TECHNIQUES, SEQUENCES, PROCEDURES, SCHEDULING & SAFETY PROGRAMS REQUIRED TO COMPLETE THE WORK OF THIS CONTRACT. PROVIDE ALL NECESSARY BRACING & SHORING NECESSARY TO SAFELY MAINTAIN THE STRUCTURAL INTEGRITY OF NEW AND EXISTING CONSTRUCTION. ALL STRUCTURAL COMPONENTS AND SYSTEMS ARE INSTALLED & APPROVED BY THE OWNER OR ARCHITECT.
 5. COORDINATION: THE STRUCTURAL, MECHANICAL, AND ELECTRICAL DRAWINGS ARE SUPERSEDED BY THE ARCHITECTURAL DRAWINGS. IT SHALL BE THE RESPONSIBILITY OF THE CONTRACTOR TO CHECK AND COORDINATE ALL THE DRAWINGS BEFORE PROCEEDING AND TO NOTIFY THE ARCHITECT OF ANY CONFLICTS IMMEDIATELY UPON BEING AWARE OF ANY DISCREPANCIES OR ERRORS.
 6. ALL STRUCTURAL DRAWINGS SHALL BE USED IN CONJUNCTION WITH THE ARCHITECTURAL, MECHANICAL, PLUMBING, AND ELECTRICAL DRAWINGS AND SPECIFICATIONS. VERIFY LOCATION AND DIMENSIONS OF CHASES, DUCTS, OPENINGS, SILLINGS, WALLS, PARTS, BEAMS, PERMISSIBLES, AND OTHER PROJECT REQUIREMENTS NOT SHOWN ON THE STRUCTURAL DRAWINGS. VERIFY AND COORDINATE ALL DIMENSIONS RELATED TO THIS PROJECT.
 7. UNLESS OTHERWISE INDICATED, DETAILS SHOWN ARE TO BE CONSIDERED TYPICAL FOR SIMILAR CONDITIONS.
 8. IF THERE ARE CONFLICTS BETWEEN THE WORK INDICATED IN ANY OF THE DRAWINGS AND/OR ANY CONFLICTS WITH THE SPECIFICATIONS AND/OR CONFLICTS BETWEEN THE DRAWINGS AND SPECIFICATIONS THE MORE DETAILED OF THE CONFLICTING ALTERNATIVES SHALL BE INCLUDED IN THE BID OR PROPOSAL.
 9. REFER TO THE SPECIFICATIONS IN THE PROJECT MANUAL FOR ADDITIONAL INFORMATION AND INSTRUCTIONS.
- LEGEND & PRECEDENCE**
10. LEGEND: ALL SYMBOLS AND ABBREVIATIONS USED ON THE DRAWINGS ARE CONSIDERED CONSTRUCTION STANDARDS. IF THE CONTRACTOR HAS ANY QUESTIONS REGARDING THE SAME OR THEIR EXACT MEANING, THE ARCHITECT SHALL BE NOTIFIED FOR CLARIFICATION.
 11. PRECEDENCE: DIMENSIONS SHALL HAVE PRECEDENCE OVER SCALE. LARGER SCALE DRAWINGS HAVE PRECEDENCE OVER SMALLER SCALE DRAWINGS. SPECIFICATIONS AND GENERAL NOTES TAKE PRECEDENCE OVER DRAWINGS.
- ADDITIONAL MISC. NOTES**
12. ACCESS PANELS: ALL EQUIPMENT UNITS AND VALVES SHALL BE CONCEALED AND MUST BE PROVIDED WITH ACCESS PANELS REQUIRED WHEREVER OR NOT SET ARE INDICATED IN THE DRAWINGS.
 13. GLASS: ALL GLASS AND GLASS INSULATIONS TO CONFORM TO CONSUMER-SPECIFIC PERFORMANCE, PRODUCT SAFETY ACT AND ALL CODE REQUIREMENTS.
 14. NO NEW FACILITIES OR EQUIPMENT INTENDED FOR THE PERMANENT INSTALLATION MAY BE USED FOR TEMPORARY PURPOSES UNLESS THE CONTRACT DOCUMENTS SPECIFICALLY SPECIFY THIS USE.
 15. ALL ROUGH OPENINGS SHALL BE FIELD VERIFIED PRIOR TO MANUFACTURING OR ORDERING OF ALL DOOR, WINDOW, EQUIPMENT OR OTHER BUILDING PRODUCTS.
 16. THE STRUCTURES SHALL BE INSTALLED IN ACCORDANCE WITH NFPA 10, STANDARD FOR PORTABLE FIRE EXTINGUISHERS.
 17. EMERGENCY LIGHTING TO BE PROVIDED IN ACCORDANCE WITH NFPA.
 18. ENTIRE BUILDING TO BE OPERATED IN ACCORDANCE WITH NFPA 10, DRAWINGS, DESIGN AND SPEC TO BE PROVIDED PRIOR TO INSTALLATION.


PROJECT NAME & ADDRESS:
PLYMOUTH ENTERPRISE CENTER
 Crafton County Economic Development Council
 Plymouth, New Hampshire

A 4.2

BUILDING SECTIONS

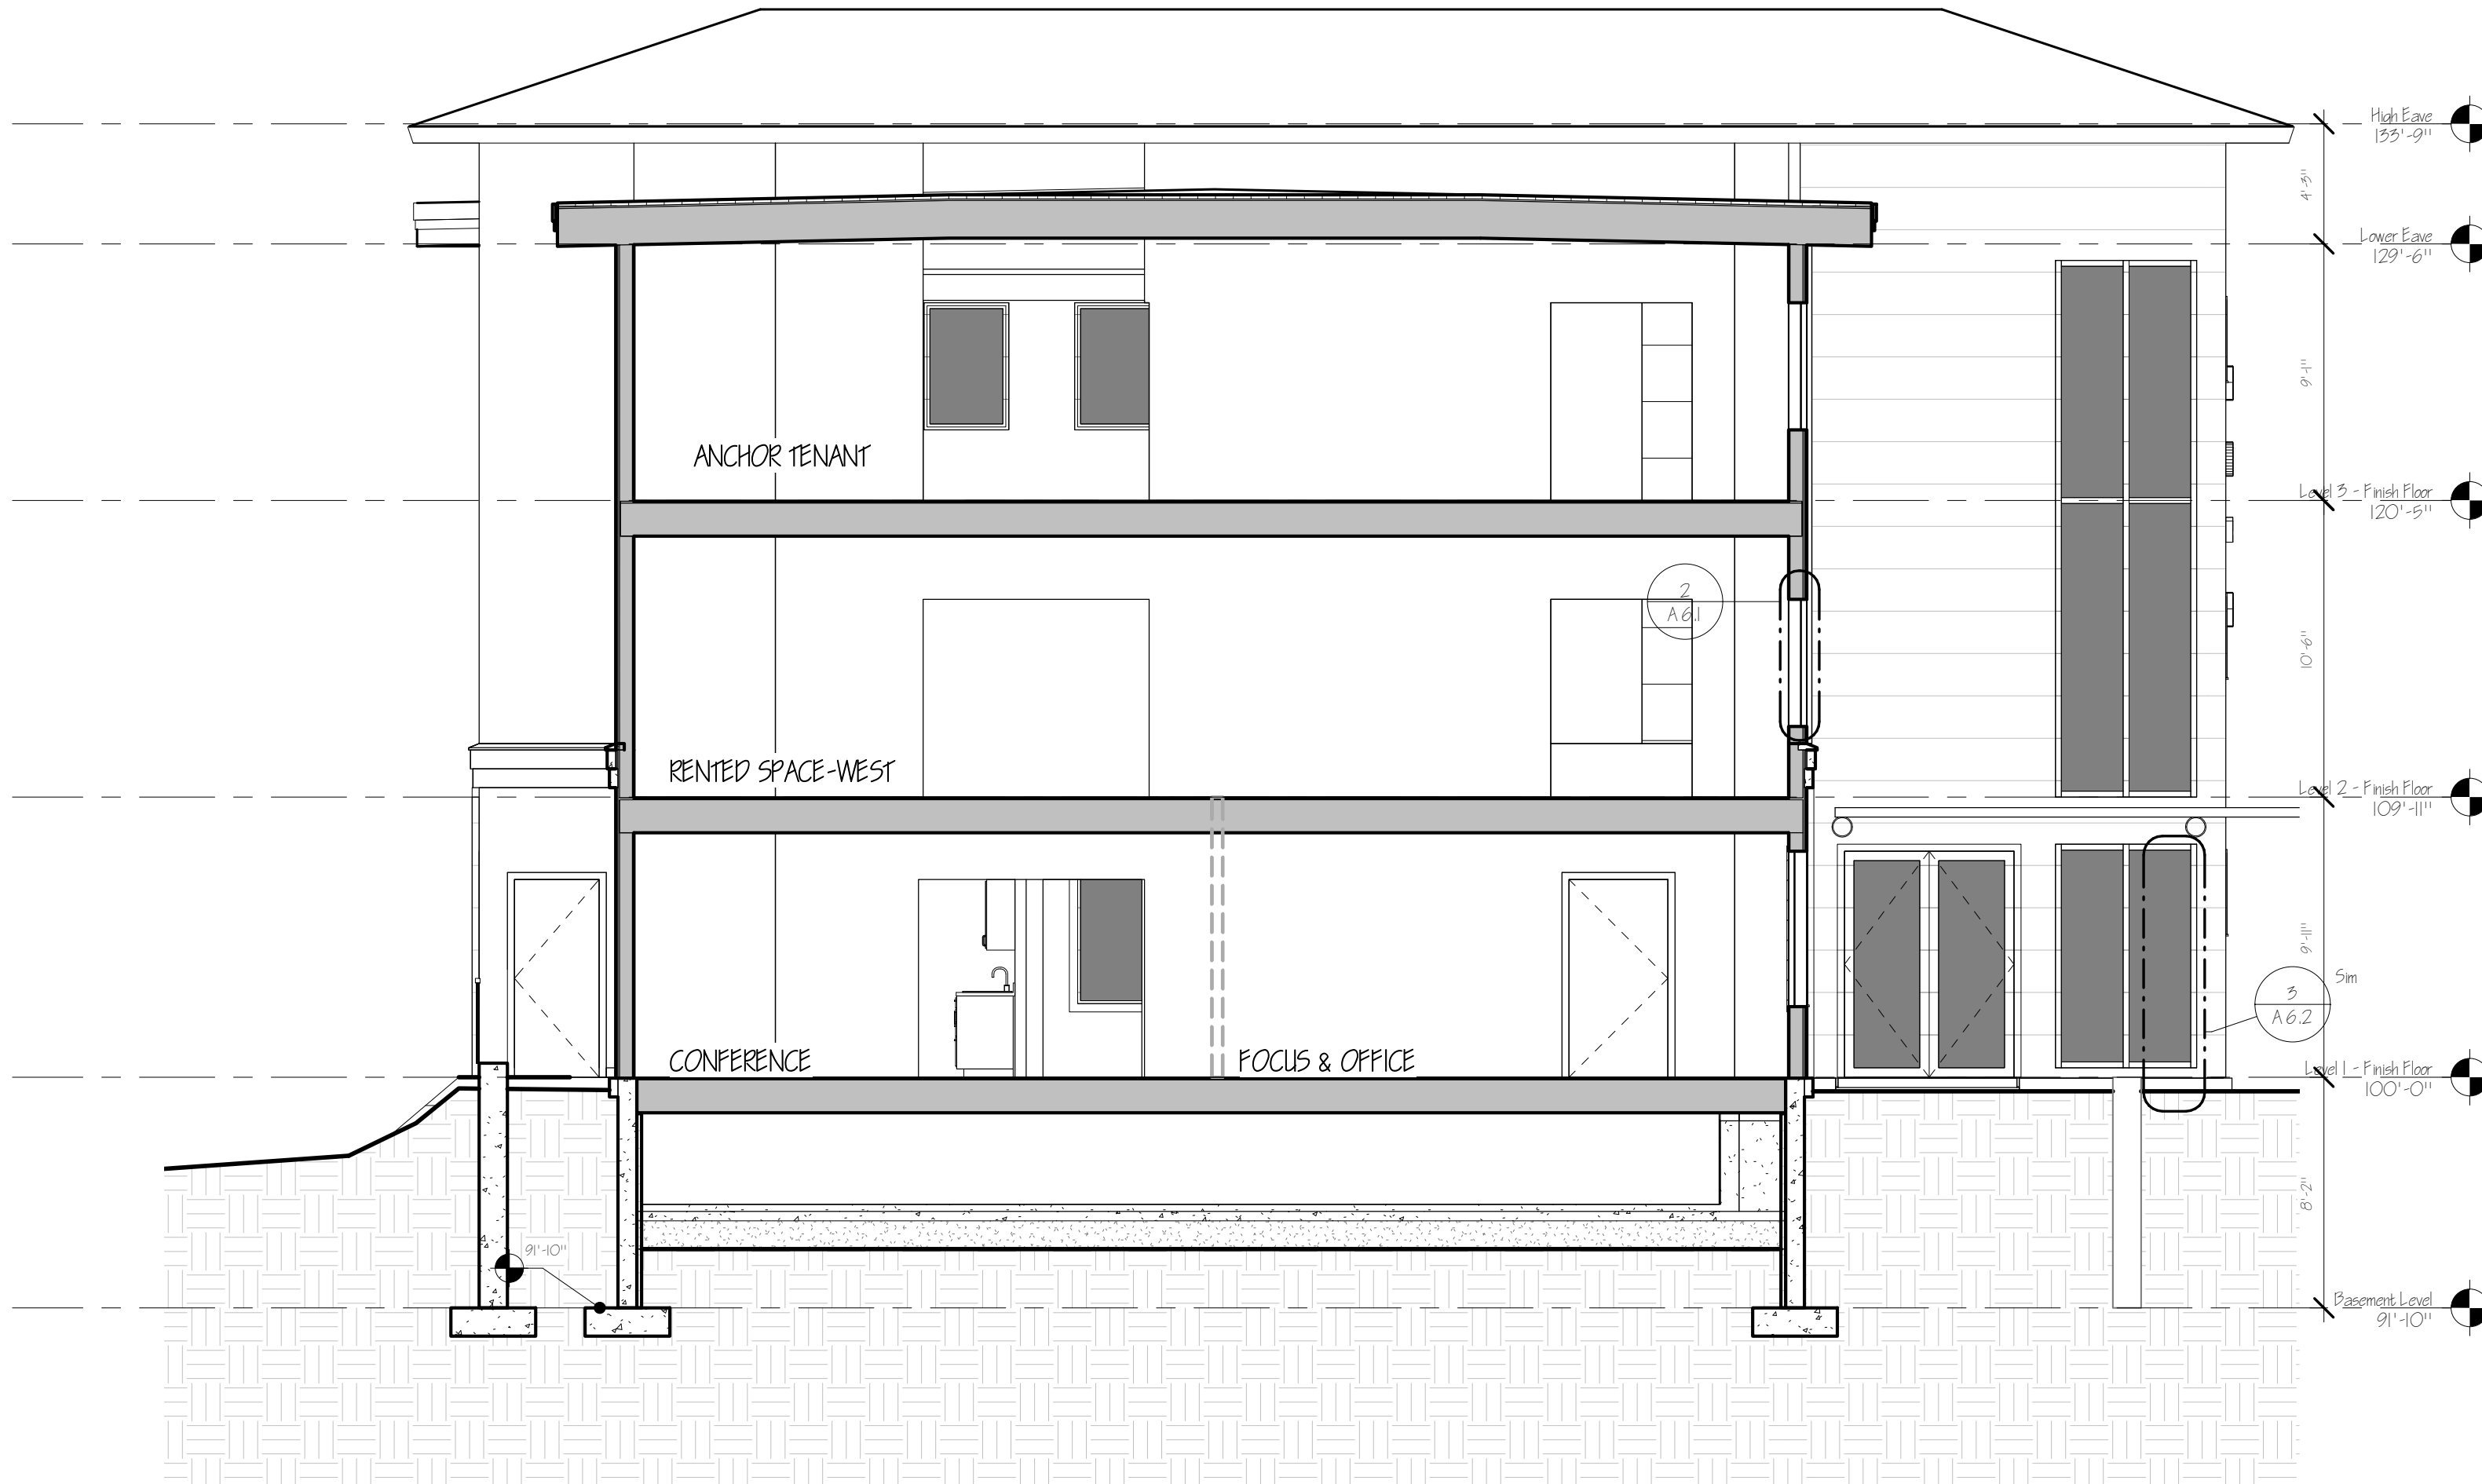

2 WEST N/S SECTION
3/16" = 1'-0"

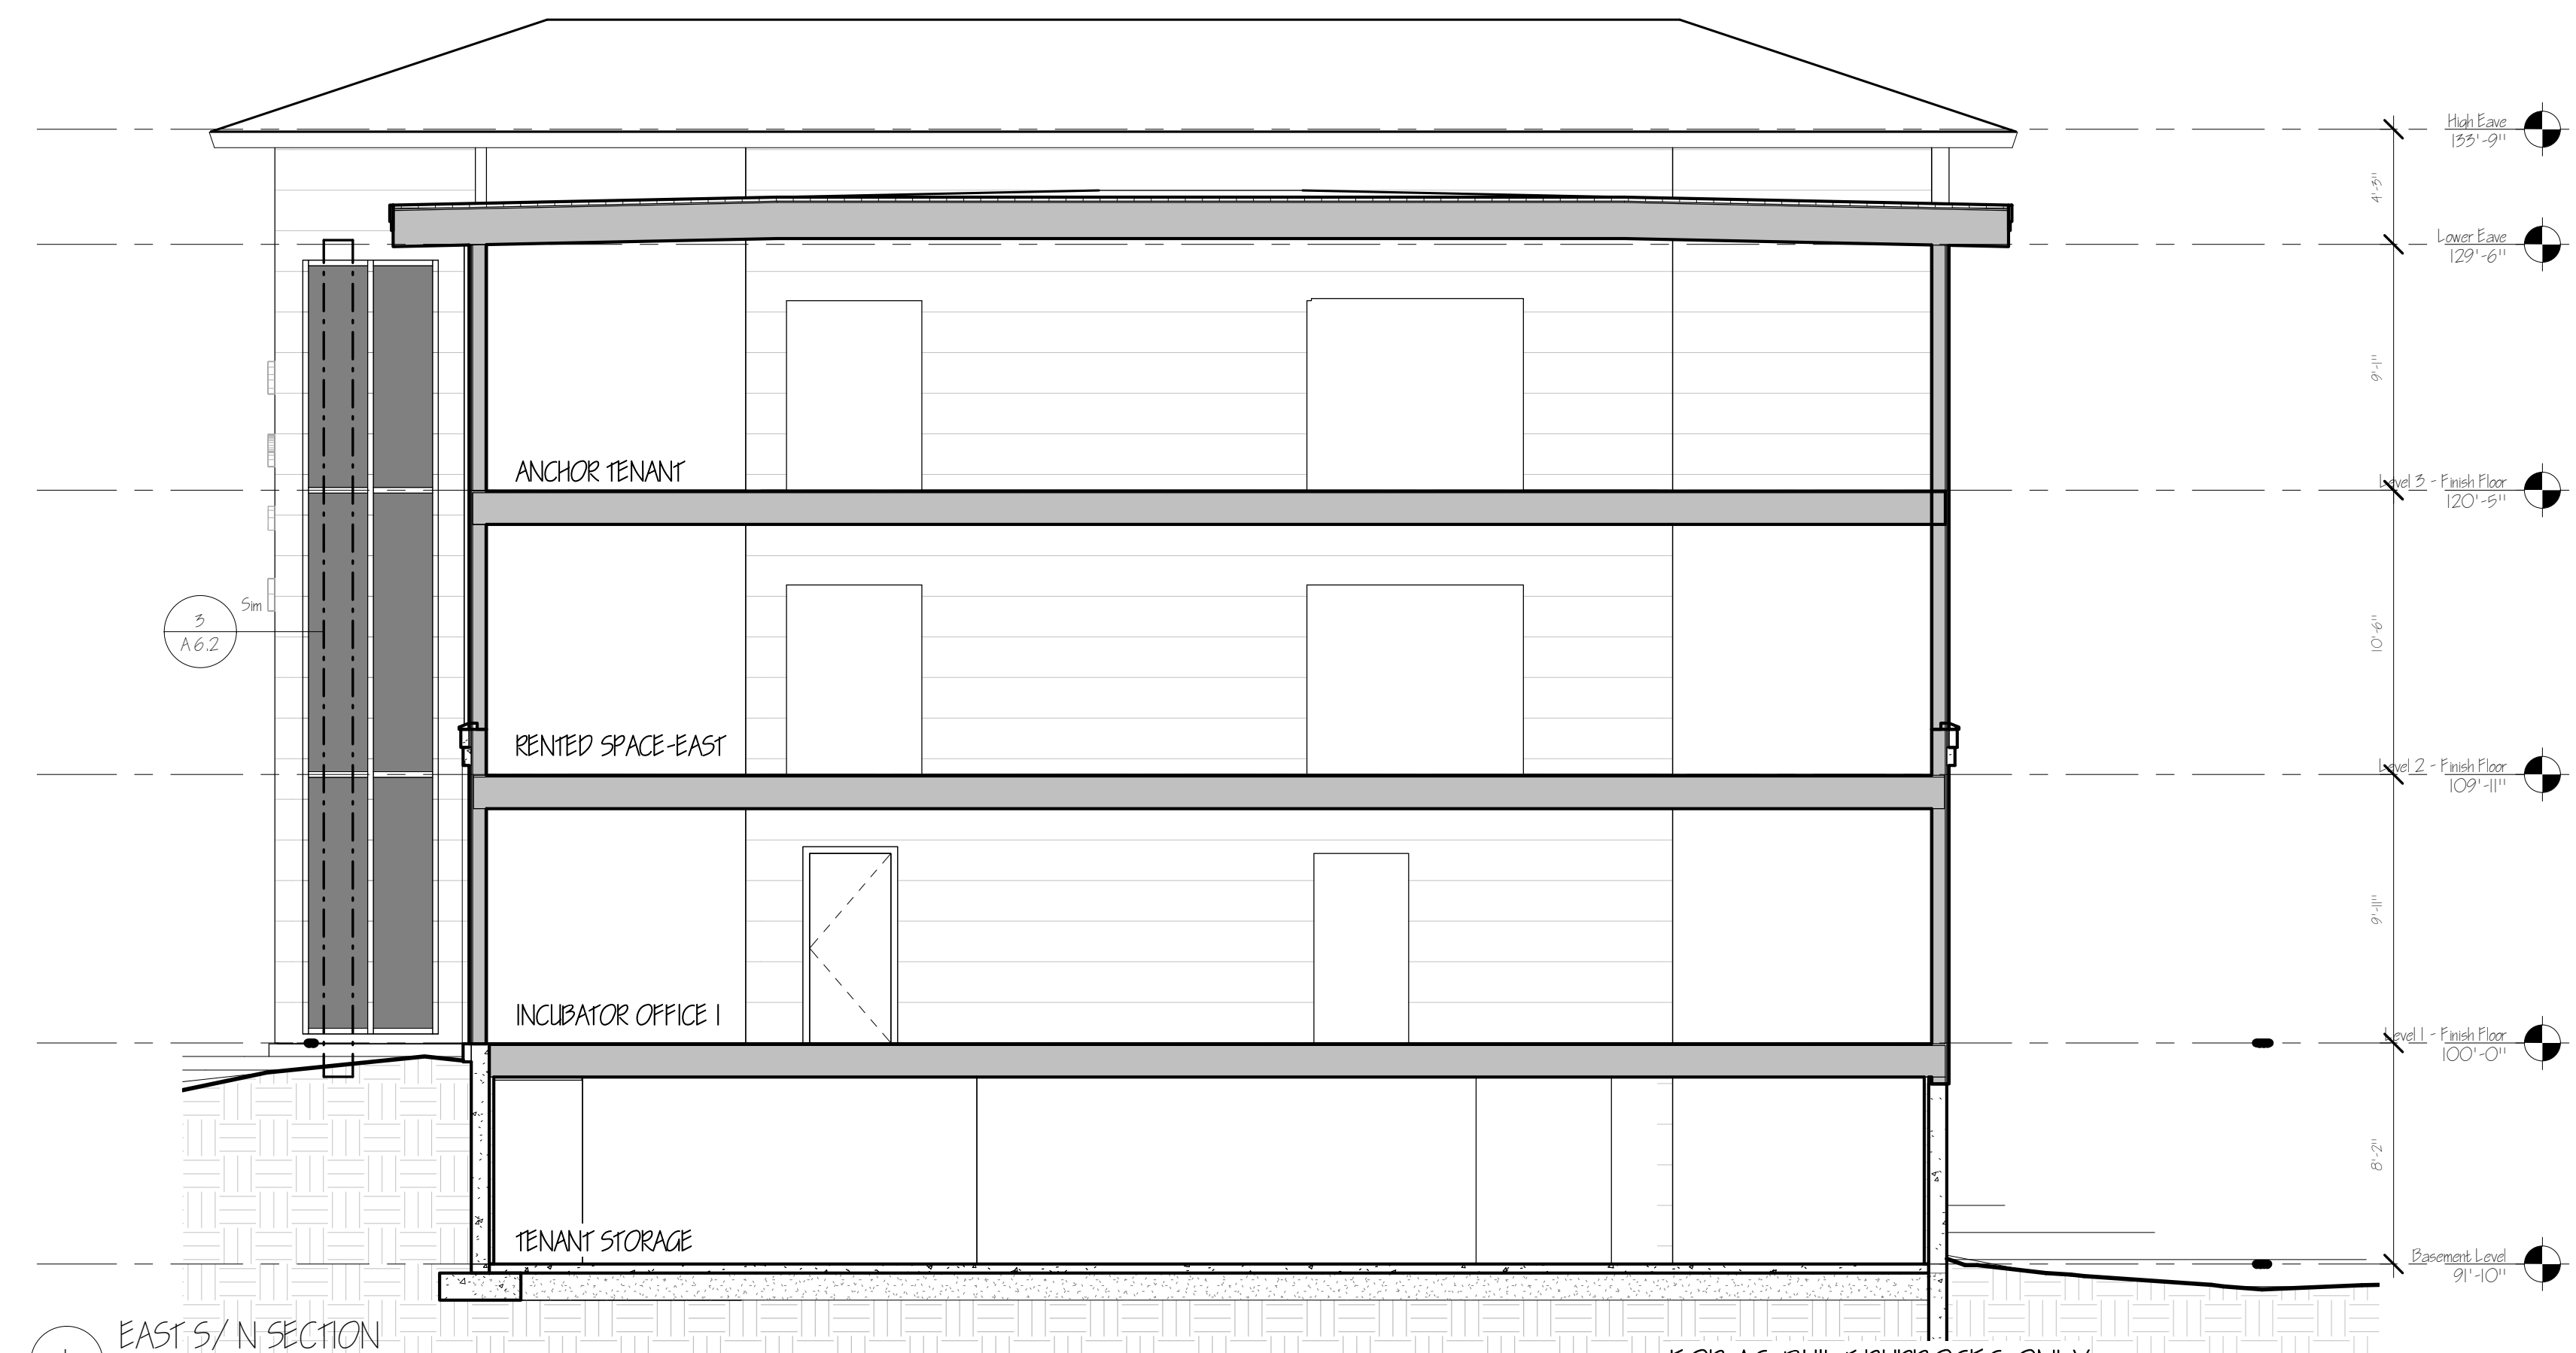

1 EAST S/N SECTION
3/16" = 1'-0"

FOR AS-BUILT PURPOSES ONLY
-DRAWINGS ARE ISSUED FOR CREATION OF AS-BUILT DRAWINGS ONLY
-DRAWINGS ISSUED WITHOUT 'RED-LINE' REVISION NOTATION MAY NOT BE CURRENT


GENERAL NOTES:

- BUILDING CODE**
1. ALL WORK PERFORMED BY THE CONTRACTOR AND ALL SUB-CONTRACTORS OF THIS PROJECT SHALL CONFORM TO THE REQUIREMENTS OF THE STATE OF NEW HAMPSHIRE BUILDING CODES AND ANY AMENDMENTS; THE STATE OF NEW HAMPSHIRE LIFE SAFETY CODE (AND ANY AMENDMENTS); THE TOWN OF WOODSTOCK ZONING REGULATIONS; AND ALL OTHER REGULATIONS AND CODES.
 2. ALL WORK TO COMPLY WITH ADA, STATE, LOCAL, STATE & FEDERAL HANDICAPPED ACCESSIBILITY REQUIREMENTS.
- CONTRACT & CONTRACT DRAWINGS**
3. THE CONTRACT LIMIT HAS BEEN INDICATED ON THE DRAWINGS. IF NO LIMIT HAS BEEN INDICATED BY THE OWNER, ARCHITECT & GENERAL CONTRACTOR SHOULD REVIEW ON-SITE PRIOR TO CONSTRUCTION.
 4. THE CONTRACTOR SHALL FAMILIARIZE HIMSELF WITH THE CONTRACT DRAWINGS. ANY DISCREPANCIES SHALL BE BROUGHT TO THE ATTENTION OF THE ARCHITECT BEFORE PROCEEDING. THE CONTRACTOR SHALL BE SOLELY RESPONSIBLE FOR ANY AND ALL CONSTRUCTION MEANS, METHODS, SEQUENCES, PROCEDURES, SCHEDULING & SCHEDULING REQUIRED TO COMPLETE THE WORK OF THIS CONTRACT. PROVIDE ALL TEMPORARY PROTECTIVE & SHORING NECESSARY TO SAFELY MAINTAIN THE STRUCTURAL INTEGRITY OF NEW AND EXISTING CONSTRUCTION UNTIL ALL STRUCTURAL COMPONENTS AND SYSTEMS ARE INSTALLED & APPROVED BY THE OWNER OR ARCHITECT.
 5. COORDINATION: THE STRUCTURAL, MECHANICAL, AND ELECTRICAL DRAWINGS ARE SUPPLEMENTARY TO THE ARCHITECTURAL DRAWINGS. IT SHALL BE THE RESPONSIBILITY OF THE CONTRACTOR TO CHECK AND CORRECT ALL THE DRAWINGS BEFORE FABRICATION AND/OR INSTALLATION OF ANY WORK. CONTRACTOR SHALL IMMEDIATELY NOTIFY THE ARCHITECT OF ANY DISCREPANCIES OR ERRORS.
 6. ALL STRUCTURAL DRAWINGS SHALL BE USED IN CONJUNCTION WITH THE SITE, ARCHITECTURAL, MECHANICAL, PLUMBING, AND ELECTRICAL DRAWINGS AND SPECIFICATIONS. VERIFY LOCATION AND DIMENSIONS OF CHASES, INSETS, OPENINGS, SLEEVES, WAKES, WIPS, REVEALS, EXPANSIONS, AND CORRELATE PROJECT REQUIREMENTS SHOWN ON THE STRUCTURAL DRAWINGS. VERIFY AND COORDINATE ALL DIMENSIONS RELATED TO THIS PROJECT.
 7. UNLESS OTHERWISE INDICATED, DETAILS SHOWN ARE TO BE CONSIDERED TYPICAL FOR SIMILAR CONDITIONS.
 8. IF THERE EXISTS CONFLICTS BETWEEN THE WORK INDICATED IN ANY OF THE DRAWINGS AND/OR OR ANY CONFLICTS WITHIN THE SPECIFICATIONS, AND/OR CONFLICTS BETWEEN THE DRAWINGS AND SPECIFICATIONS, THE MORE DETAILED OR THE MORE ALTERNATIVES SHALL BE INCLUDED IN THE BID OR PROPOSAL.
 9. REFER TO THE SPECIFICATIONS IN THE PROJECT MANUAL FOR ADDITIONAL INFORMATION AND INSTRUCTIONS.
- LEGEND & PRECEDENCE**
10. LEGEND: ALL SYMBOLS AND ABBREVIATIONS USED ON THE DRAWINGS ARE CONSIDERED CONSTRUCTION STANDARDS. IF THE CONTRACTOR HAS ANY QUESTIONS REGARDING THE SAME OR THEIR EXACT MEANING, THE ARCHITECT SHALL BE NOTIFIED FOR CLARIFICATION.
 11. PRECEDENCE: DIMENSIONS SHALL HAVE PRECEDENCE OVER SCALE. LARGER SCALE DRAWINGS HAVE PRECEDENCE OVER SMALLER SCALE DRAWINGS. SPECIFICATIONS AND GENERAL NOTES HAVE PRECEDENCE OVER DRAWINGS.
- ADDITIONAL MISC. NOTES**
12. ACCESS PANELS: ALL EQUIPMENT SWITCHES AND VALVES THAT ARE CONCEALED MUST BE PROVIDED WITH ACCESS PANELS REGARDLESS WHETHER OR NOT THEY ARE INDICATED IN THE DRAWINGS.
 13. GLASS: ALL GLASS AND GLASS INSTALLATIONS TO CONFORM TO CANADIAN SAFETY COMMISSION PRODUCT SAFETY ACT AND ALL CODE REQUIREMENTS.
 14. NO NEW FACILITIES OR EQUIPMENT INTENDED FOR THE PERMANENT INSTALLATION MAY BE USED FOR TEMPORARY PURPOSES UNLESS THE CONTRACT DOCUMENTS SPECIFICALLY SPECIFY THAT USE.
 15. ALL ROUGH OPENINGS SHALL BE FIELD VERIFIED PRIOR TO MANUFACTURING OR ORDERING OF ALL DOOR, WINDOW, EQUIPMENT OR OTHER BUILDING PRODUCTS.
 16. FIRE EXTINGUISHERS SHALL BE INSTALLED IN ACCORDANCE WITH NFPA 10, STANDARDS FOR PORTABLE FIRE EXTINGUISHERS.
 17. EMERGENCY LIGHTING TO BE PROVIDED IN ACCORDANCE WITH NFPA.
 18. ENTIRE BUILDING TO BE SPRINKLERED IN ACCORDANCE WITH NFPA 13, DRAWINGS, DESIGN AND SPEC. TO BE PROVIDED PRIOR TO INSTALLATION.

PROJECT NAME & ADDRESS:
PLYMOUTH ENTERPRISE CENTER
Grafton County Economic Development Council
Plymouth, New Hampshire

A 4.3

BUILDING SECTIONS

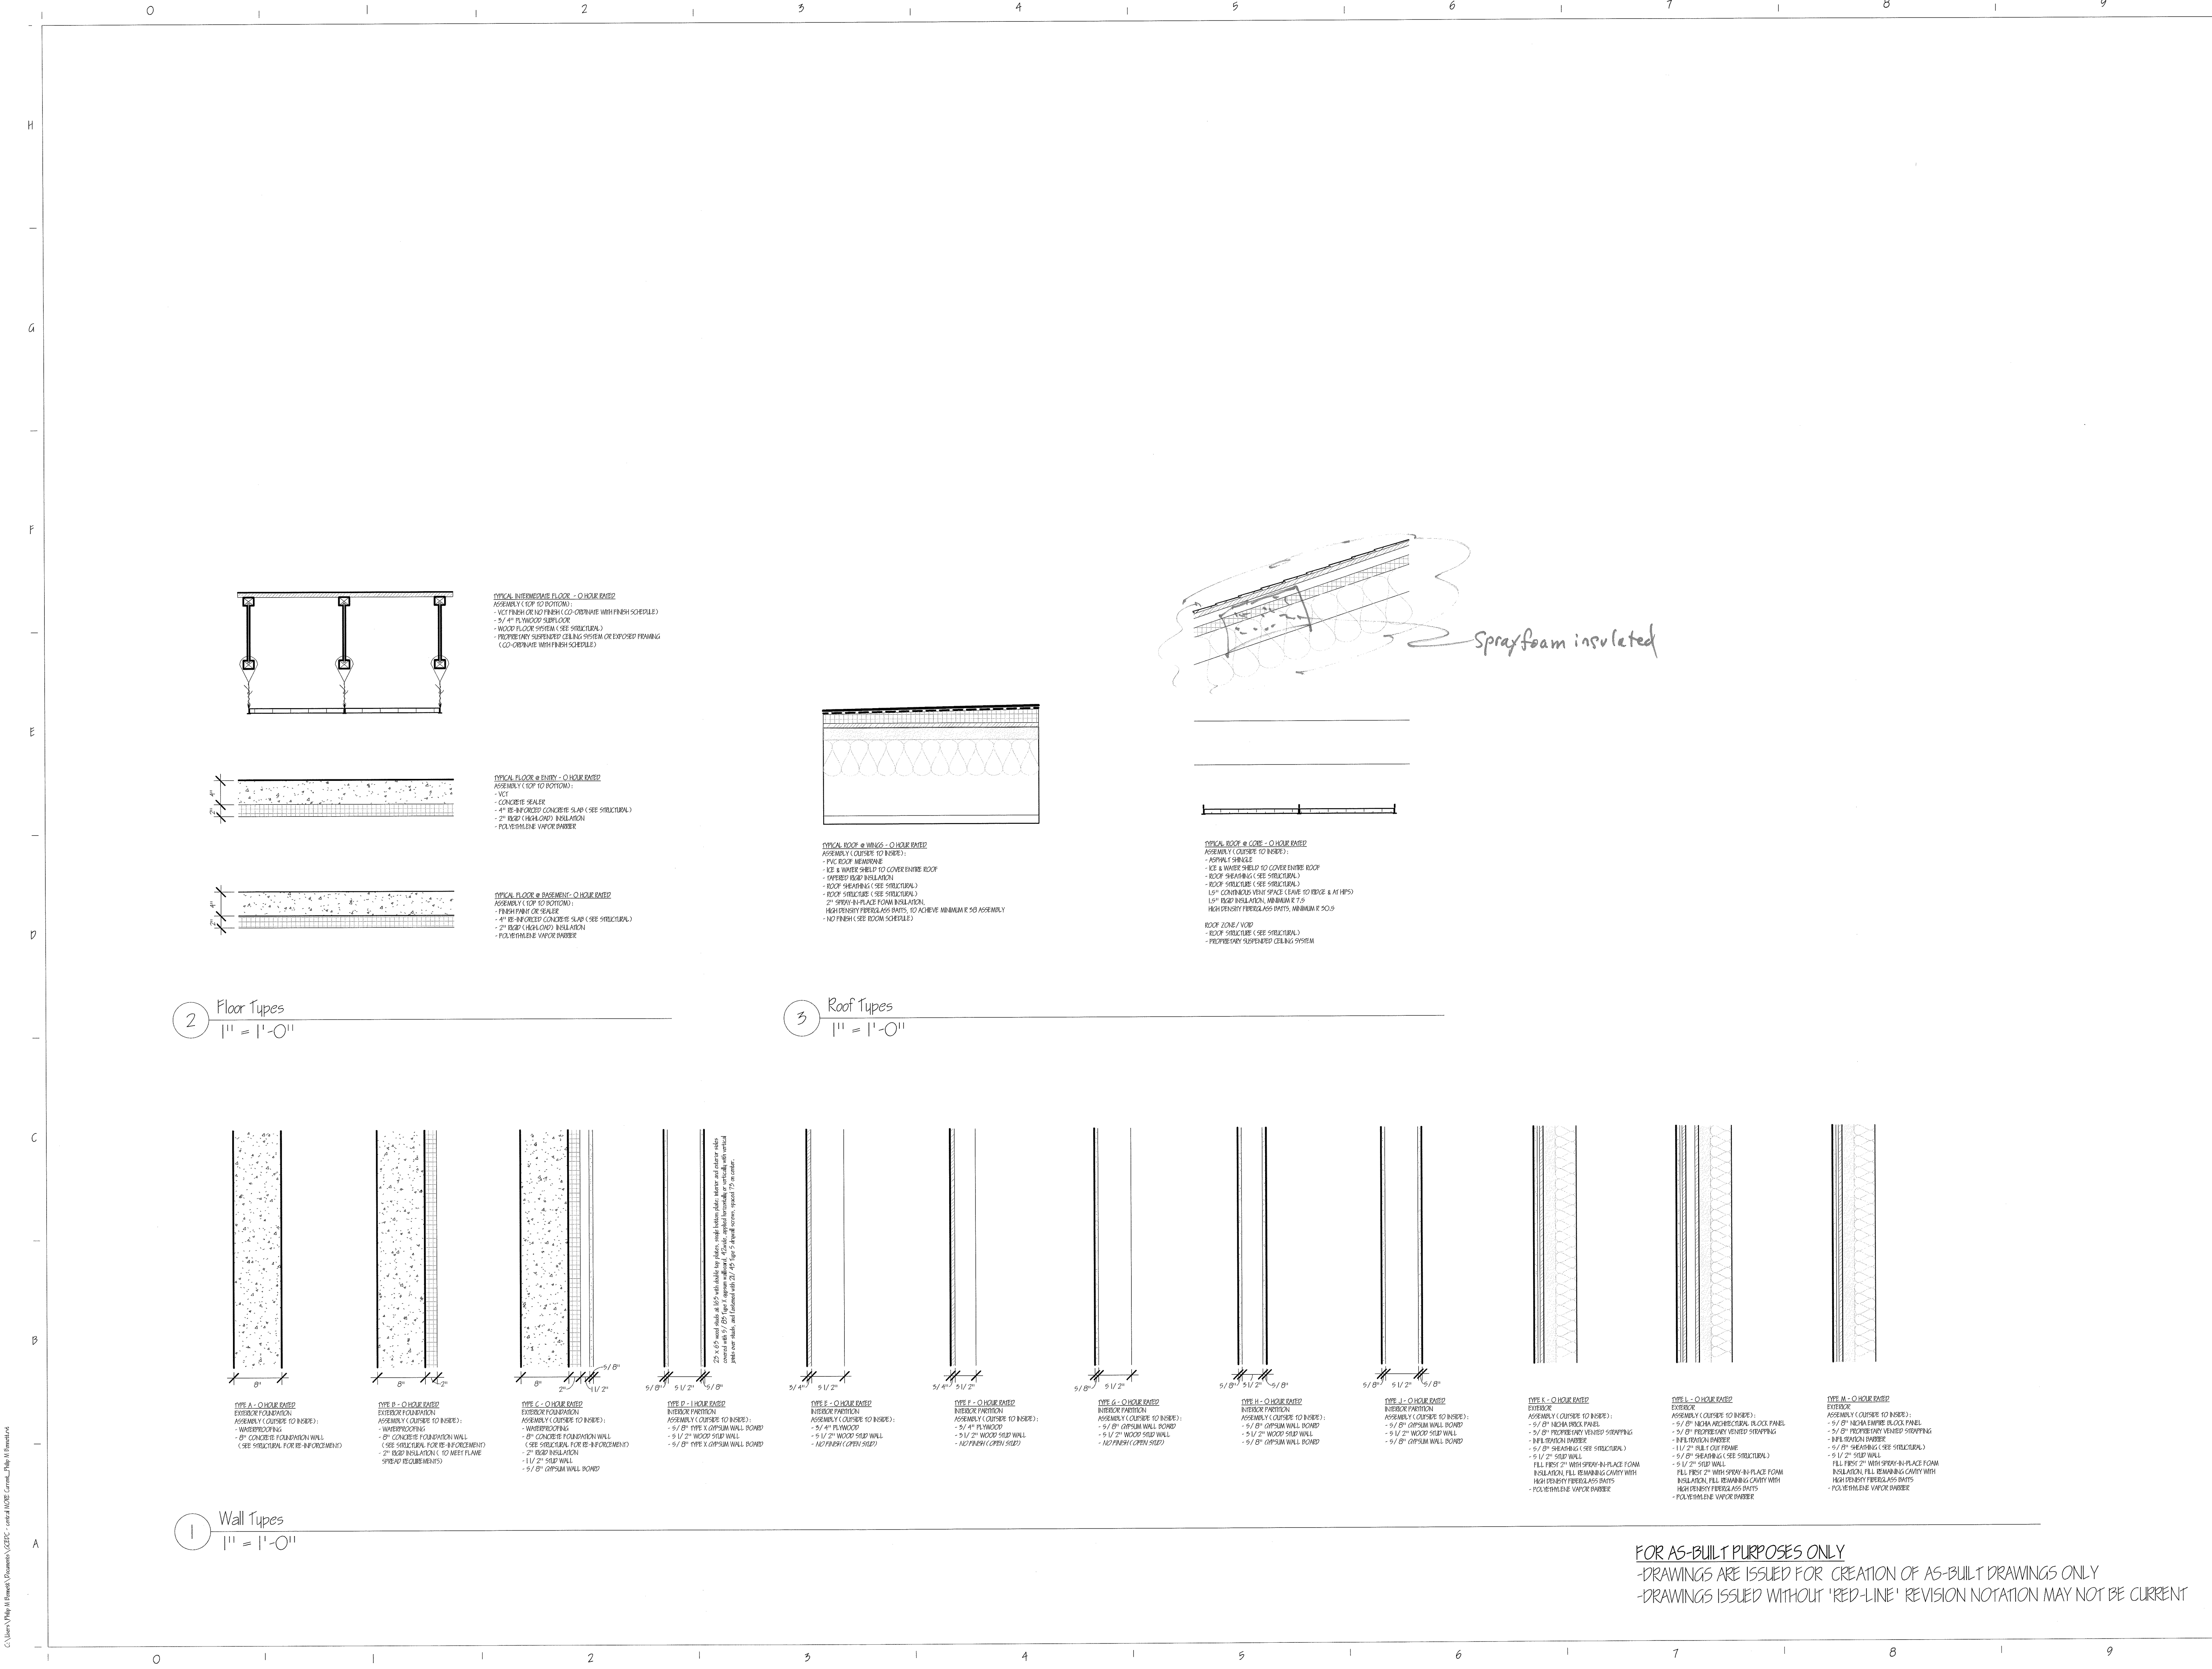


GENERAL NOTES:

Copyright 2019 Alba Group

PROJECT NAME & ADDRESS:
PLYMOUTH ENTERPRISE CENTER
 Gratton County Economic Development Council
 Plymouth, New Hampshire


WALL / FLOOR / ROOF TYPES A 5.0

FOR AS-BUILT PURPOSES ONLY
 -DRAWINGS ARE ISSUED FOR CREATION OF AS-BUILT DRAWINGS ONLY
 -DRAWINGS ISSUED WITHOUT 'RED-LINE' REVISION NOTATION MAY NOT BE CURRENT

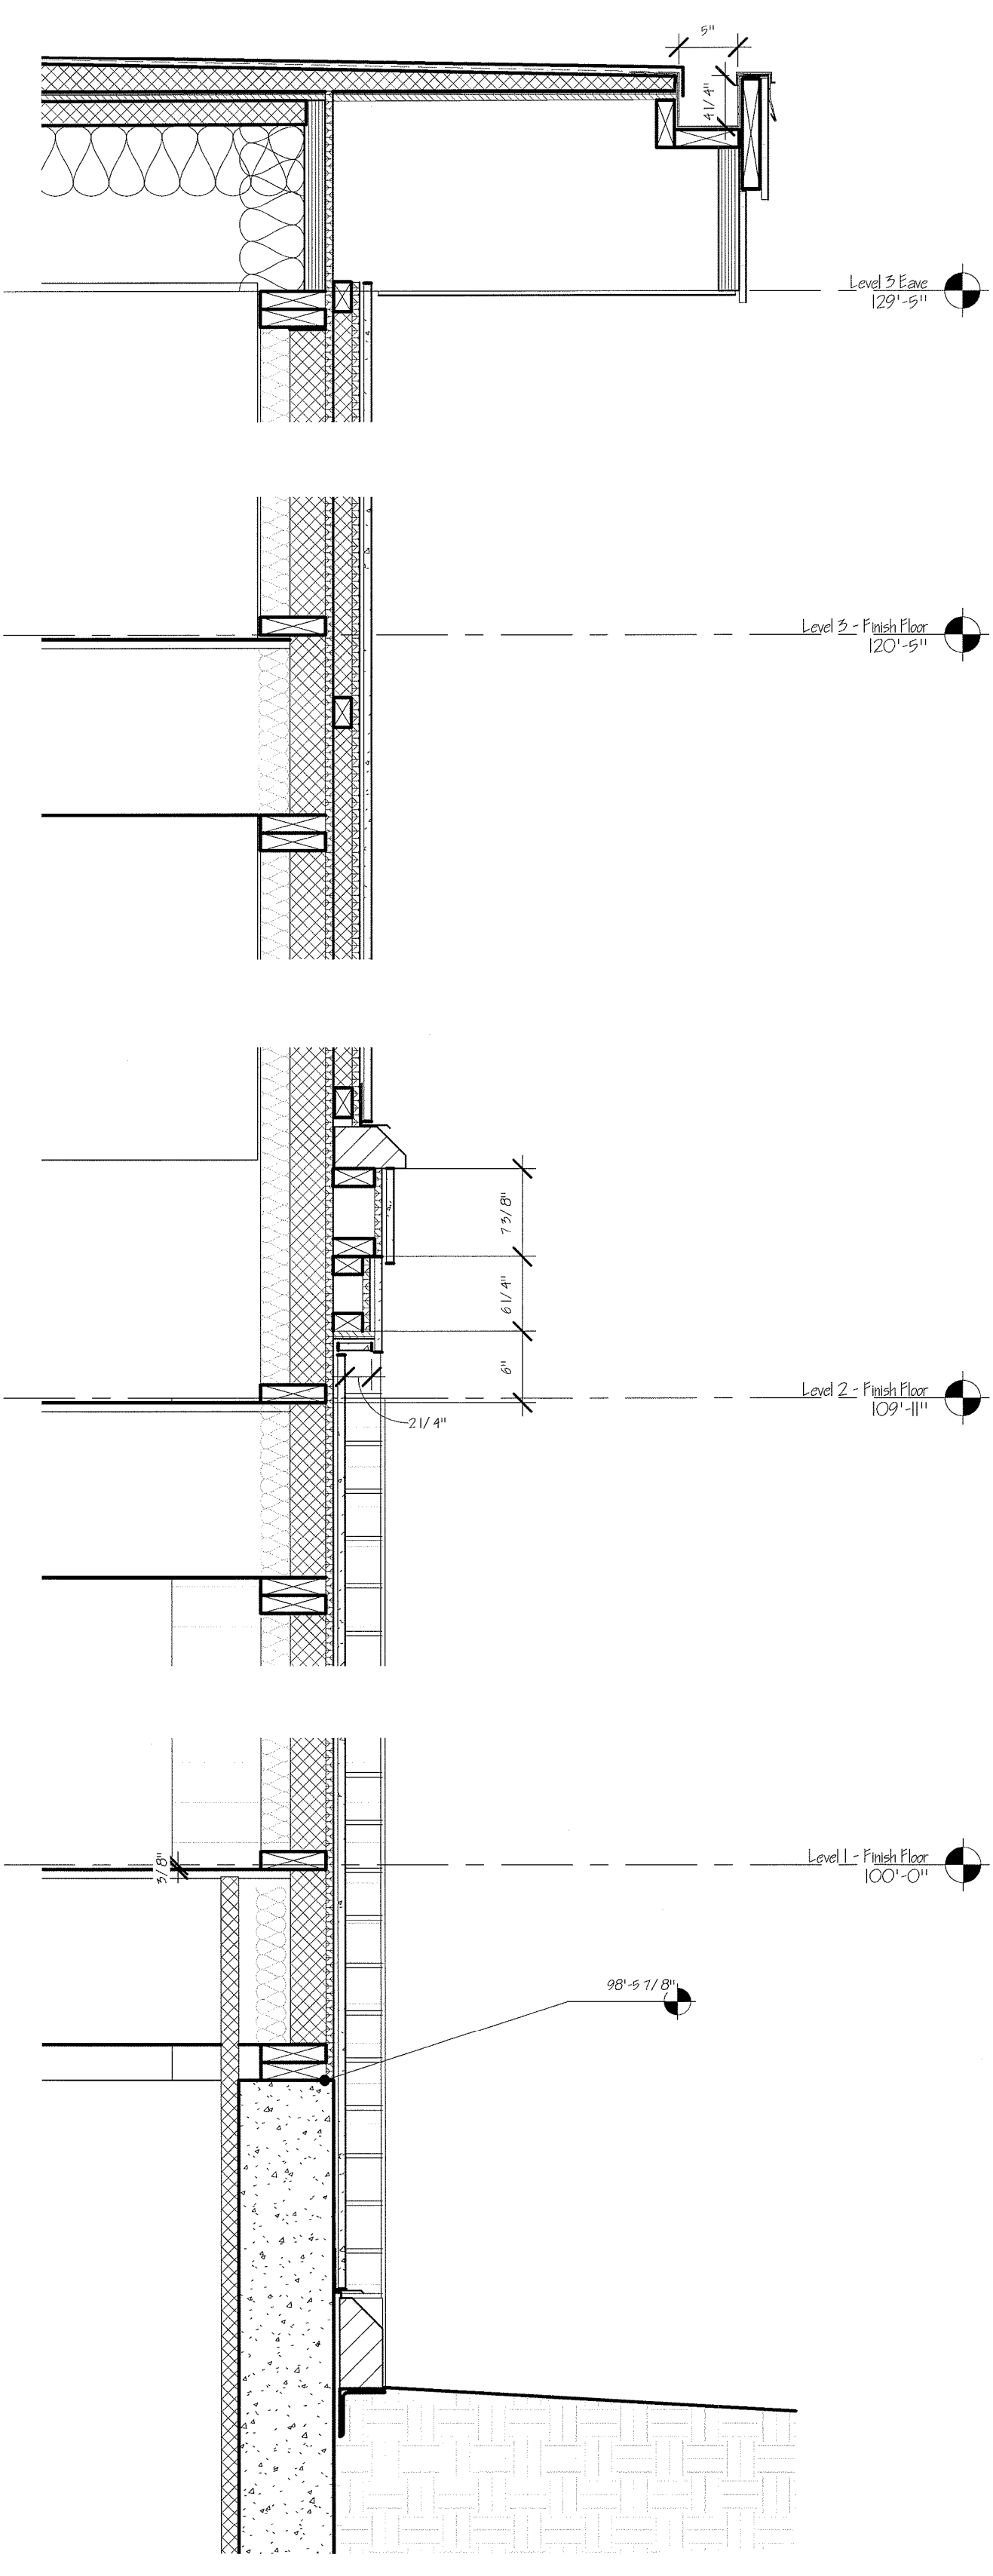


1 EAST BUMP-OUT WALL SECTION
1" = 1'-0"

2 TYPICAL EAST WALL SECTION
1" = 1'-0"

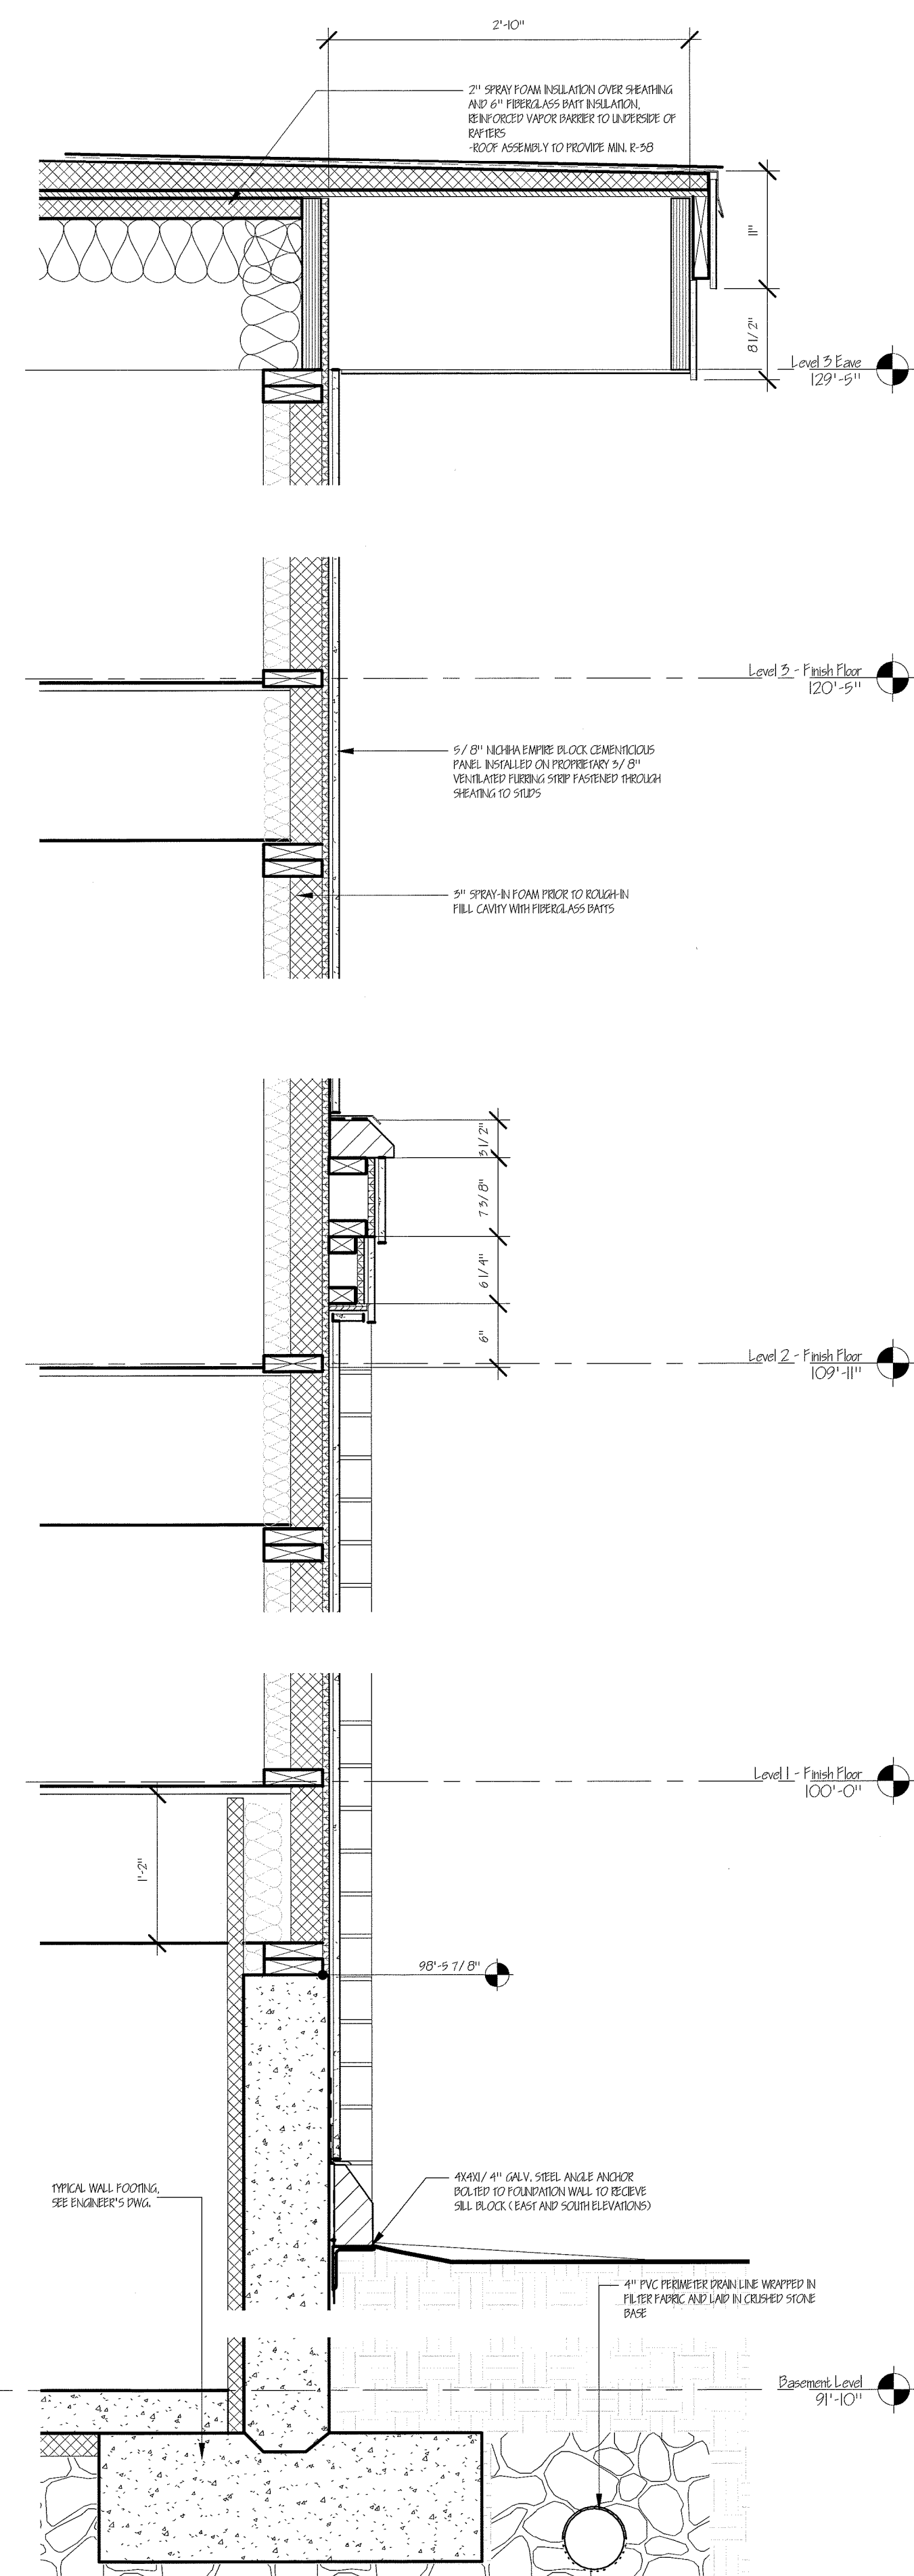

3 WEST WALL SECTION AT BUMP-OUT
1" = 1'-0"

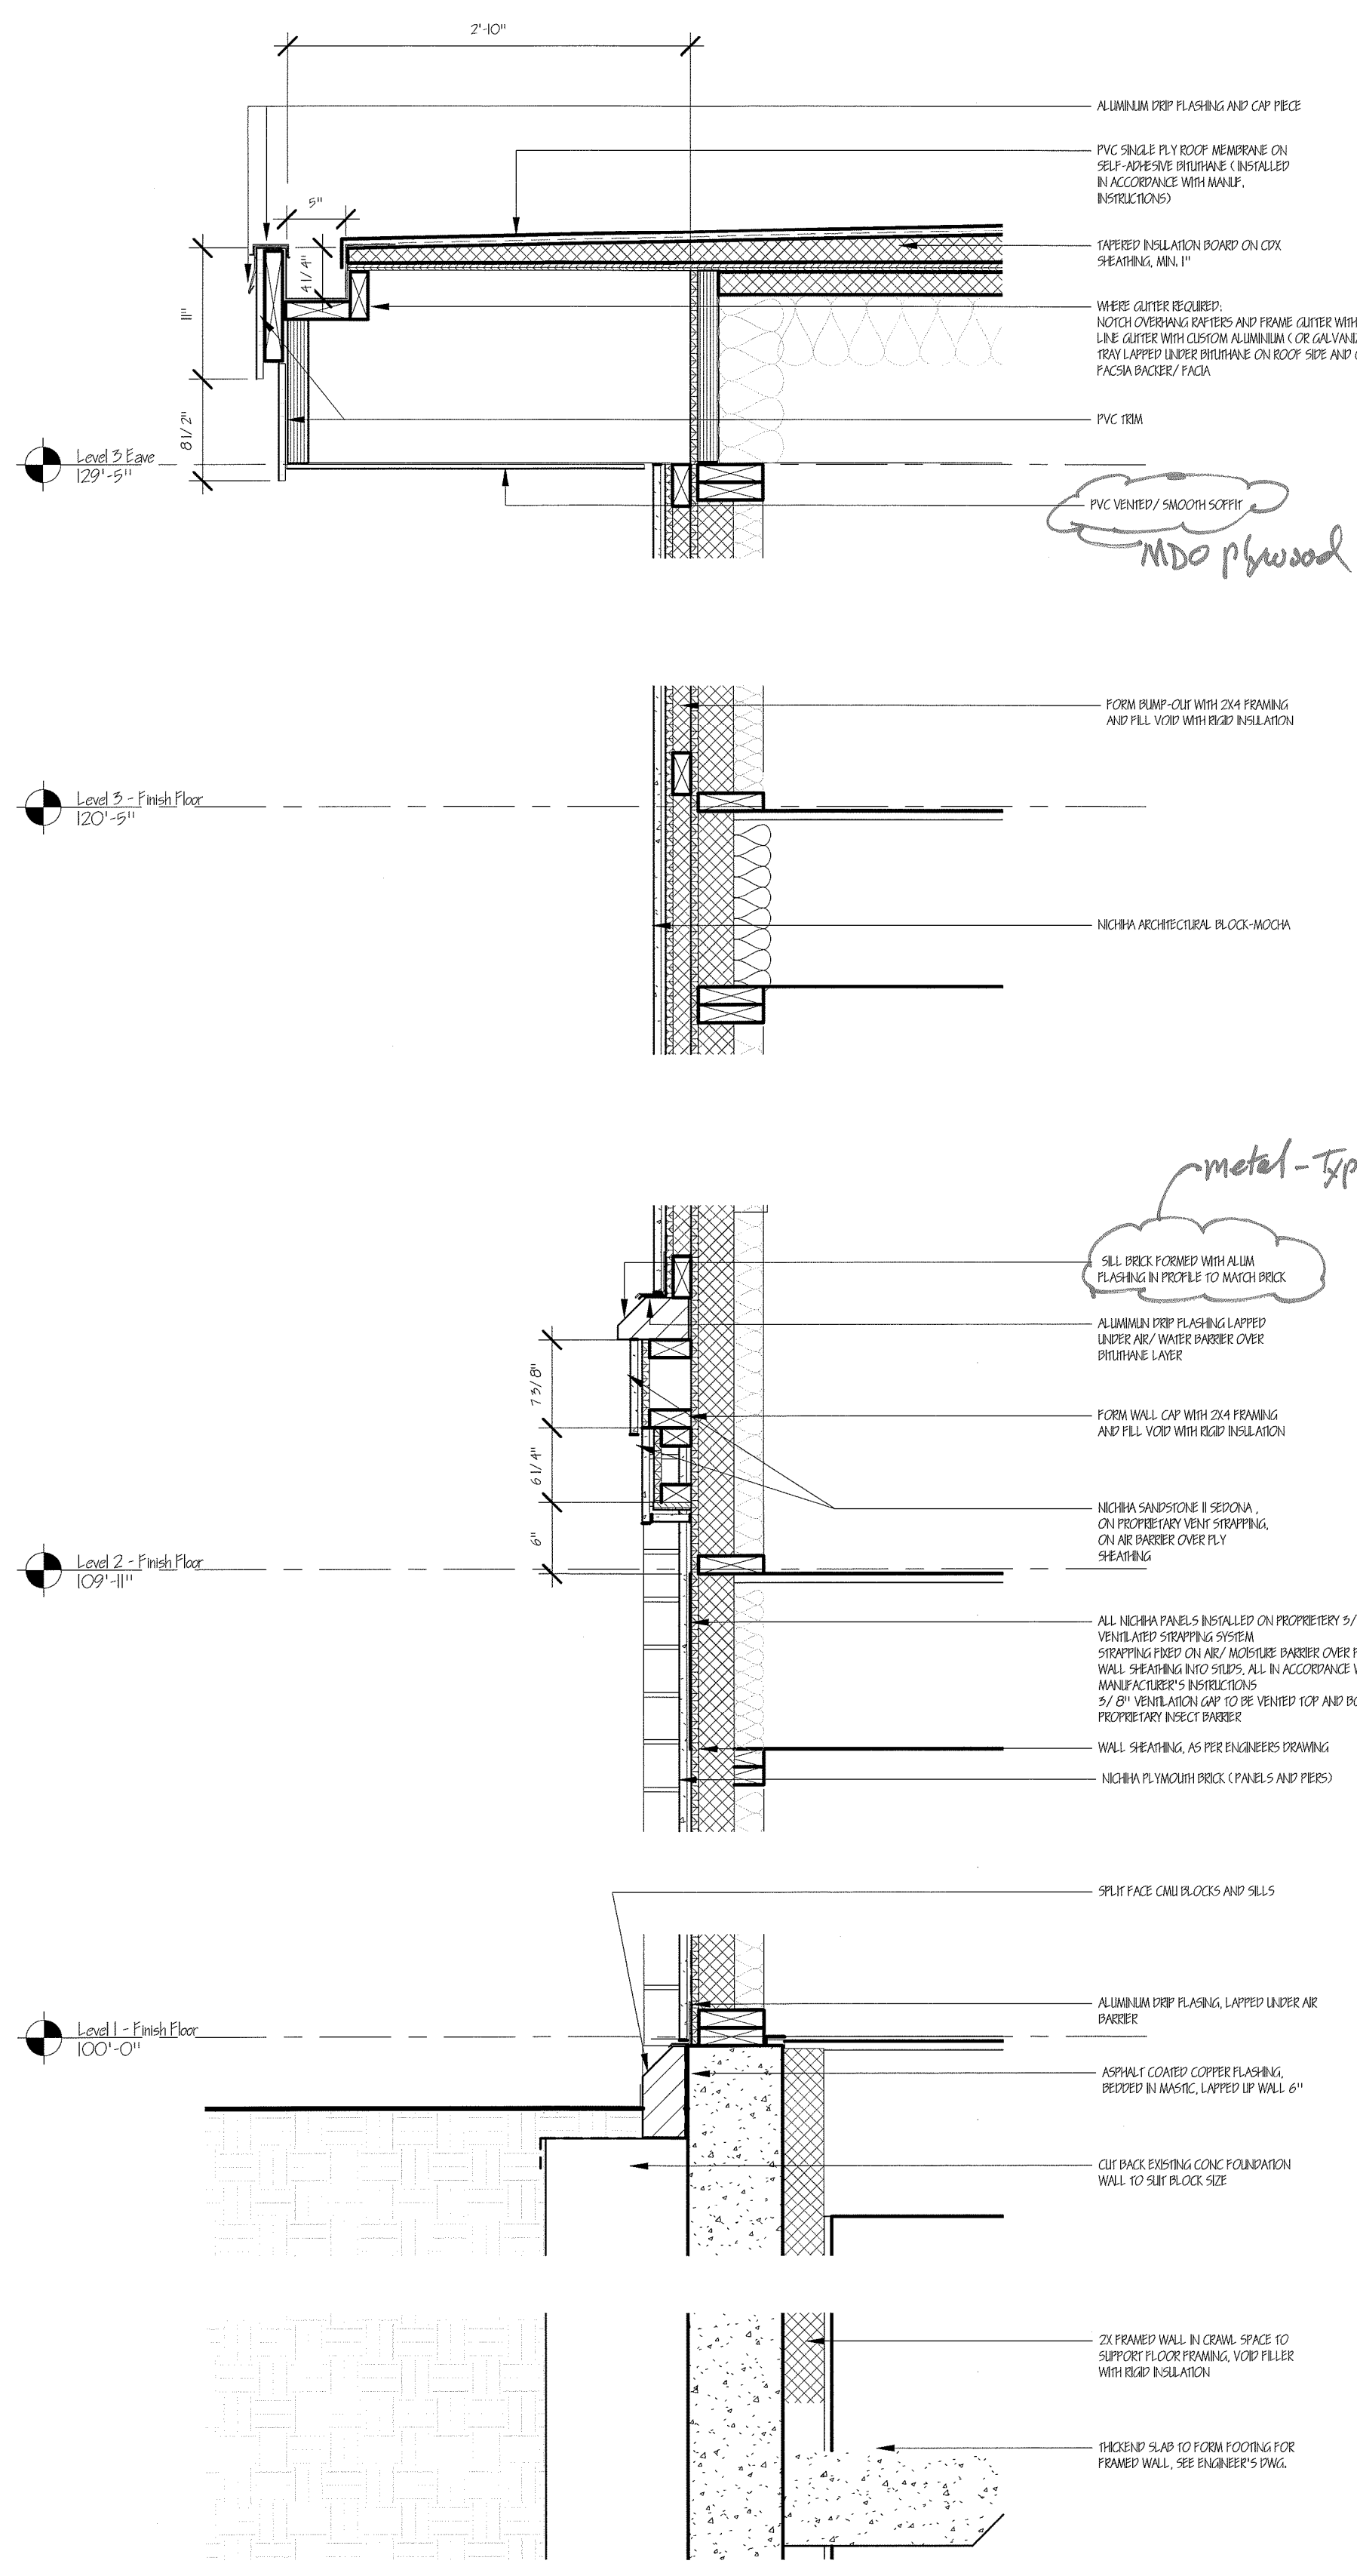


FOR AS-BUILT PURPOSES ONLY
-DRAWINGS ARE ISSUED FOR CREATION OF AS-BUILT DRAWINGS ONLY
-DRAWINGS ISSUED WITHOUT 'RED-LINE' REVISION NOTATION MAY NOT BE CURRENT

GENERAL NOTES:

PROJECT NAME & ADDRESS:
PLYMOUTH ENTERPRISE CENTER
Cranton County Economic Development Council
Plymouth, New Hampshire

WALL SECTIONS
A 5.1

C:\Users\j\OneDrive\Documents\2025\03262 - 03262\03262 - 03262.dwg

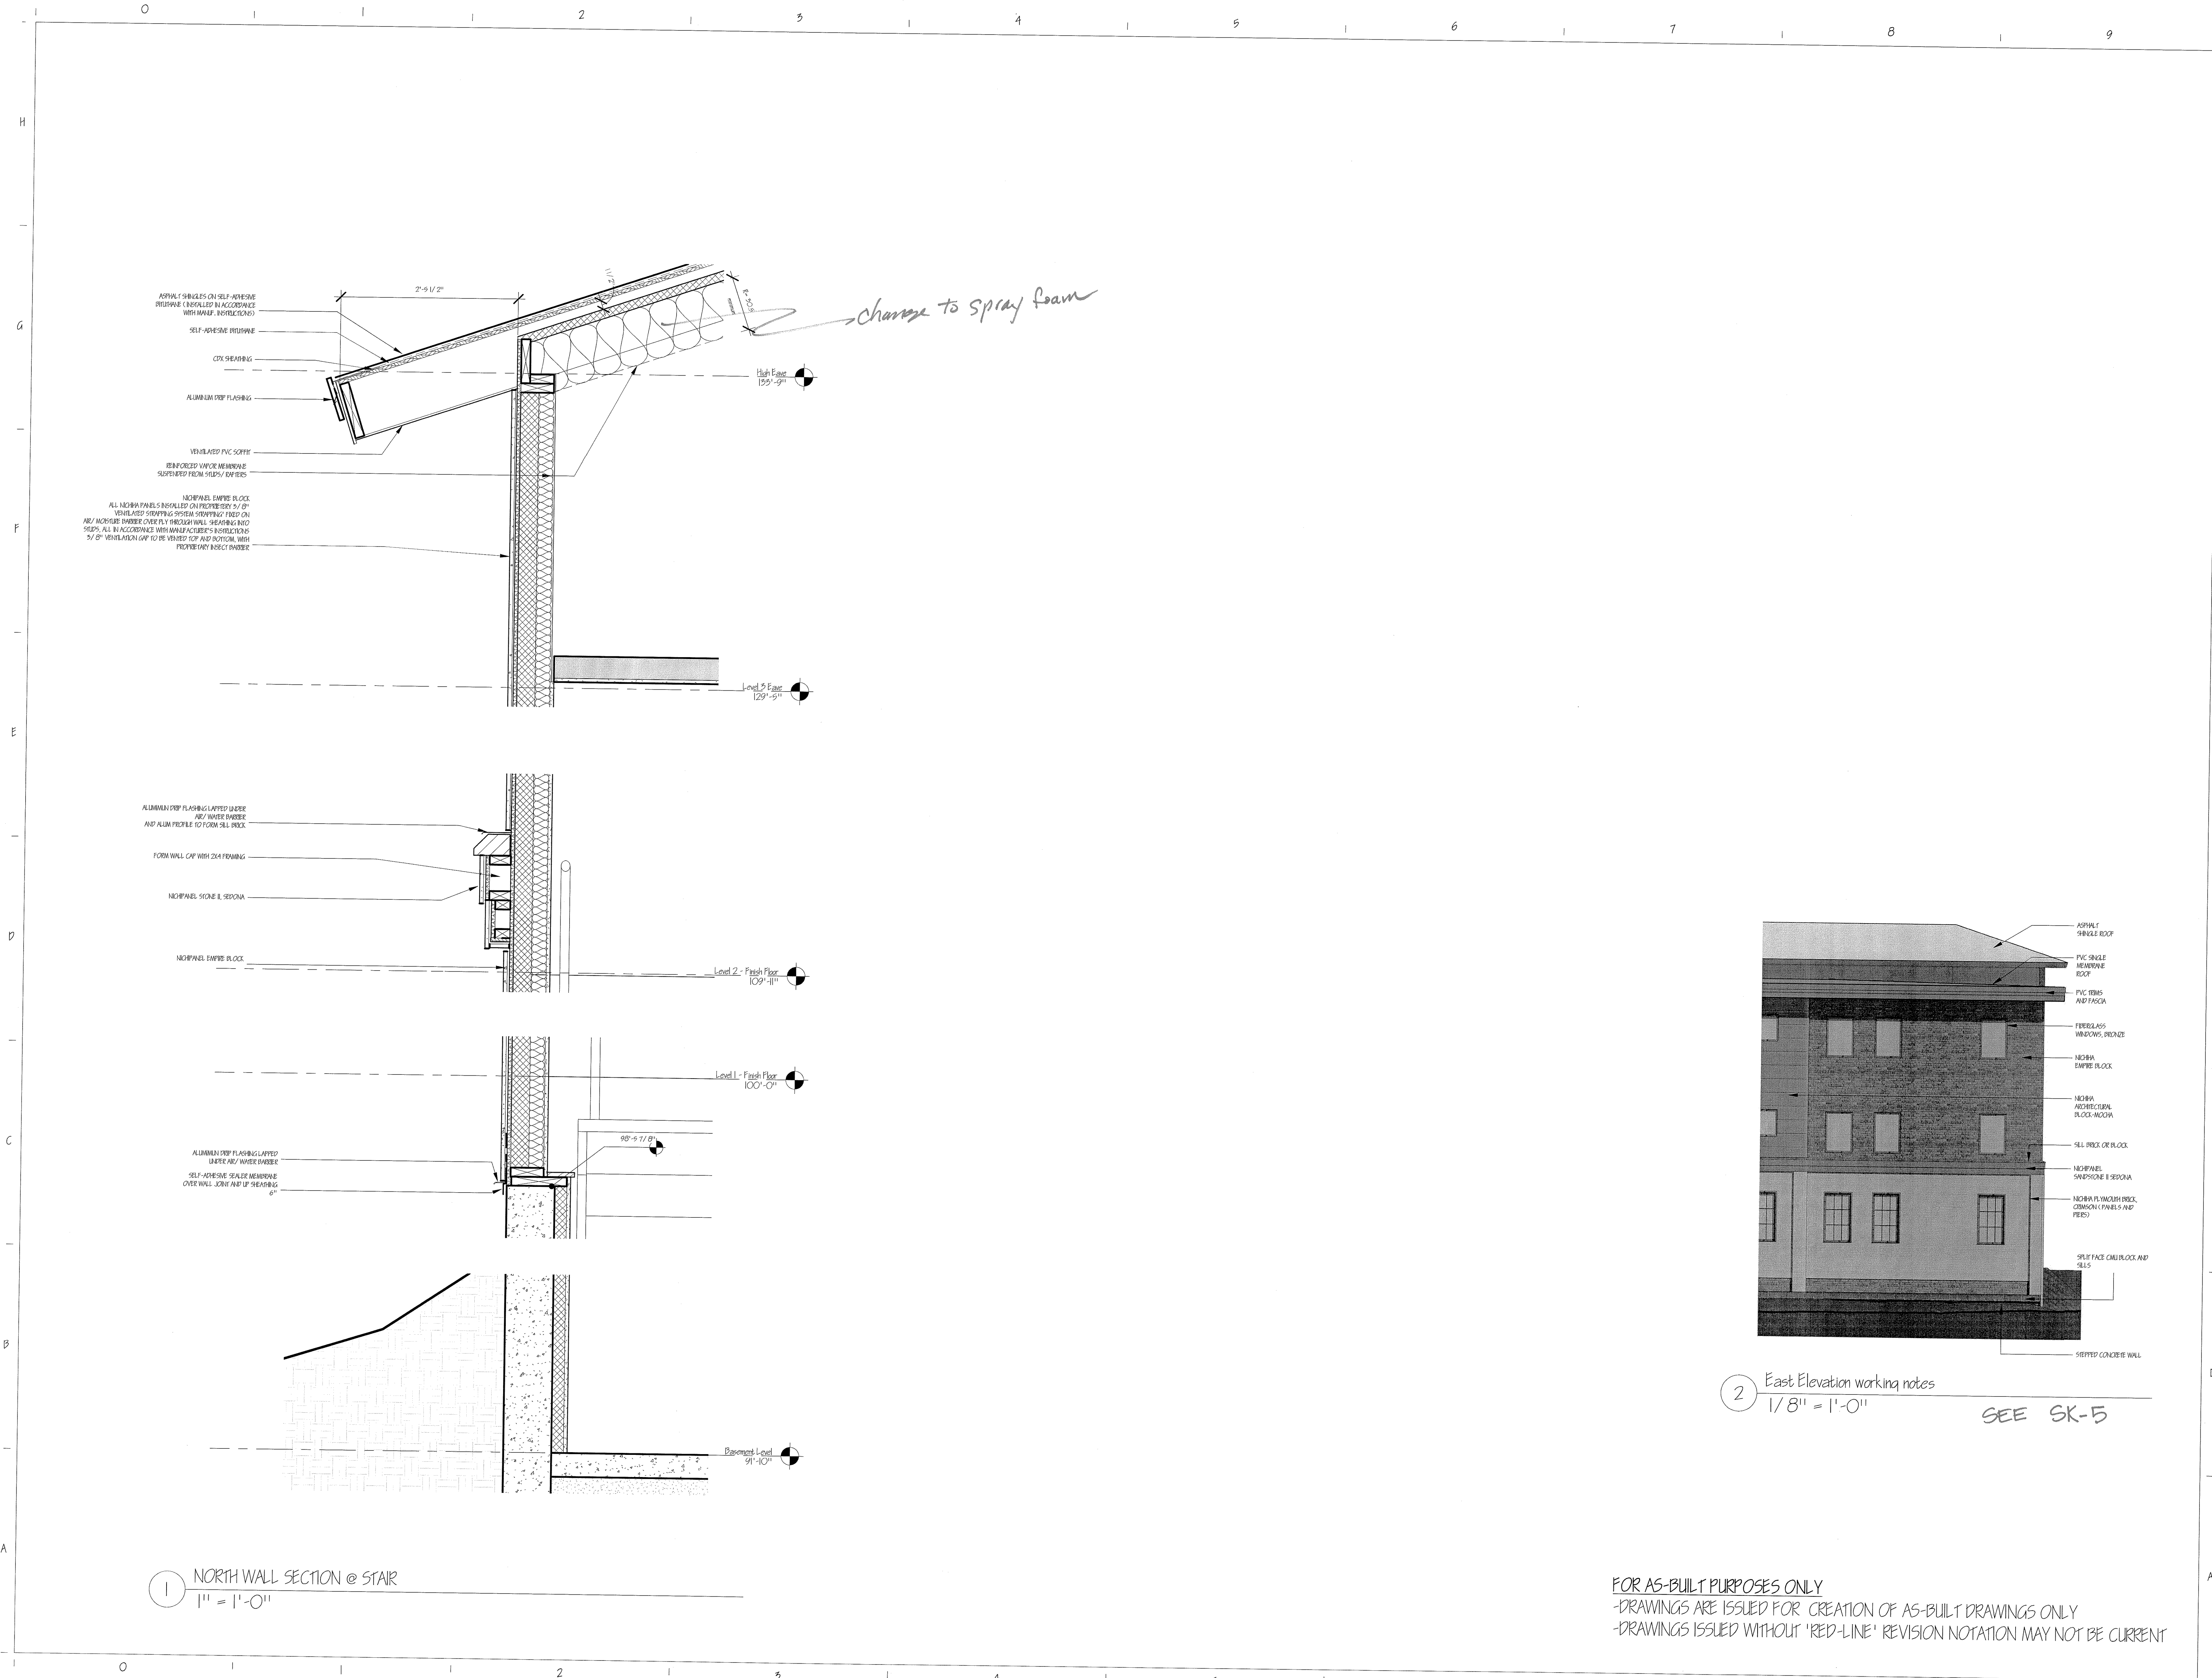

1 NORTH WALL SECTION @ STAIR
1/8" = 1'-0"


2 East Elevation working notes
1/8" = 1'-0" SEE SK-5

FOR AS-BUILT PURPOSES ONLY
 -DRAWINGS ARE ISSUED FOR CREATION OF AS-BUILT DRAWINGS ONLY
 -DRAWINGS ISSUED WITHOUT 'RED-LINE' REVISION NOTATION MAY NOT BE CURRENT

GENERAL NOTES:


PROJECT NAME & ADDRESS:
 PLYMOUTH ENTERPRISE CENTER
 Greater County Economic Development Council
 Plymouth, New Hampshire

WALL SECTIONS
 A 5.2

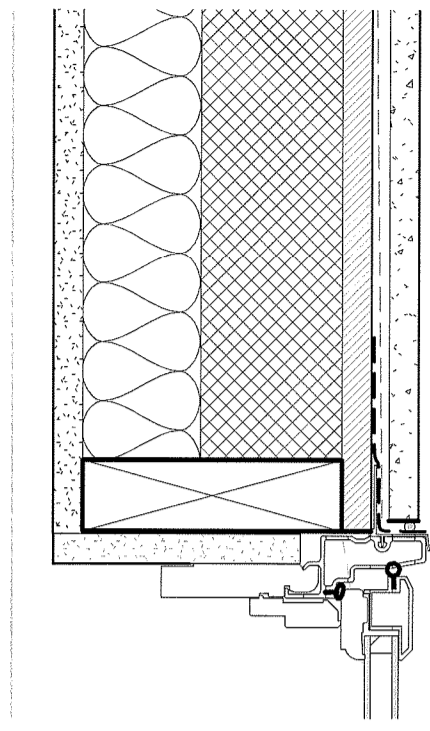


1 Window Jamb Typical
3" = 1'-0"

TYPICAL EXTERIOR WALL BUILD-UP (INTERIOR TO EXTERIOR):
 - 1/2" SHEETROCK FOR FINISH (SEE FINISH SCHEDULE FOR LOCATION)
 - 1/2" GYPSUM BOARD
 - 2" U-27 FIBERGLASS BATT INSULATION (AT THE ROUGH AND 1/2" FROM FINISH WALL) FROM TO ROUGH AND 1/2" FROM FINISH WALL SHEATHING (SEE ENG. DRAWINGS)
 - WEATHER RESISTIVE SHEATHING (WRS) (SEE ENG. DRAWINGS)
 - 2" U-27 FIBERGLASS BATT INSULATION (AT THE ROUGH AND 1/2" FROM FINISH WALL) FROM TO ROUGH AND 1/2" FROM FINISH WALL SHEATHING (SEE ENG. DRAWINGS)
 - 1/2" GYPSUM BOARD
 - 1/2" SHEETROCK FOR FINISH (SEE FINISH SCHEDULE FOR LOCATION)

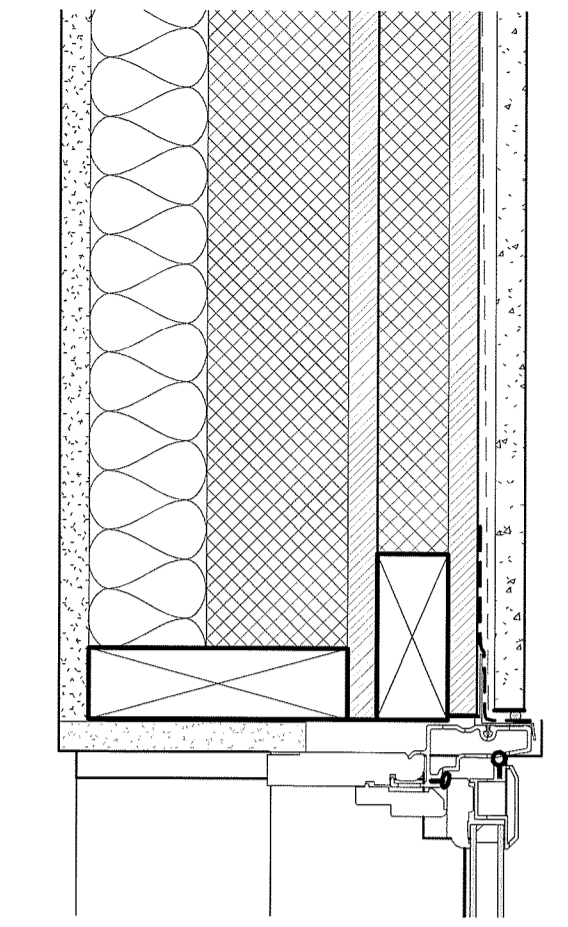


3 Window Jamb Bumpout
3" = 1'-0"

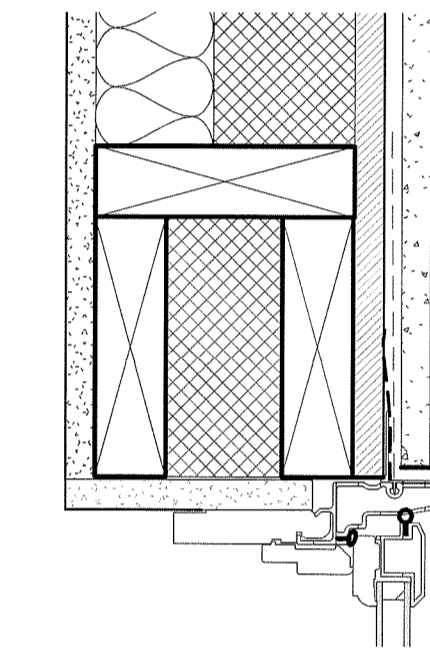


2 WINDOW HEAD AND SILL TYPICAL
3" = 1'-0"


TYPICAL OPENING DETAILS:
 - 2" U-27 FIBERGLASS BATT INSULATION (AT THE ROUGH AND 1/2" FROM FINISH WALL) FROM TO ROUGH AND 1/2" FROM FINISH WALL SHEATHING (SEE ENG. DRAWINGS)
 - WEATHER RESISTIVE SHEATHING (WRS) (SEE ENG. DRAWINGS)
 - 2" U-27 FIBERGLASS BATT INSULATION (AT THE ROUGH AND 1/2" FROM FINISH WALL) FROM TO ROUGH AND 1/2" FROM FINISH WALL SHEATHING (SEE ENG. DRAWINGS)
 - 1/2" GYPSUM BOARD
 - 1/2" SHEETROCK FOR FINISH (SEE FINISH SCHEDULE FOR LOCATION)

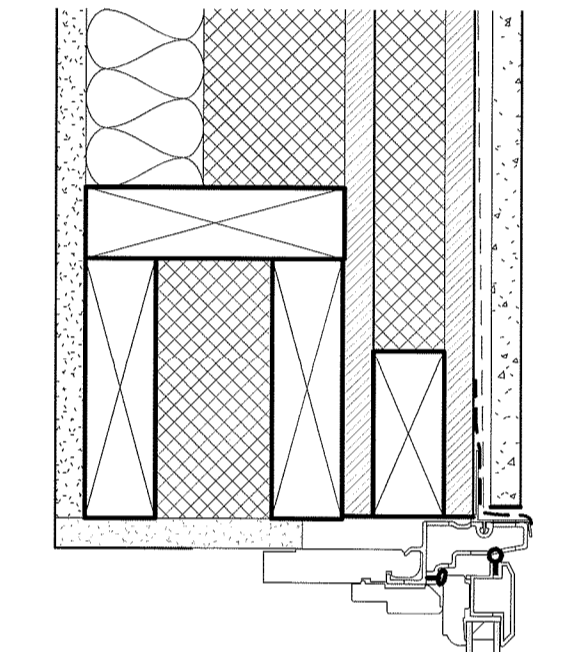


4 WINDOW HEAD AND SILL BUMP-OUT
3" = 1'-0"

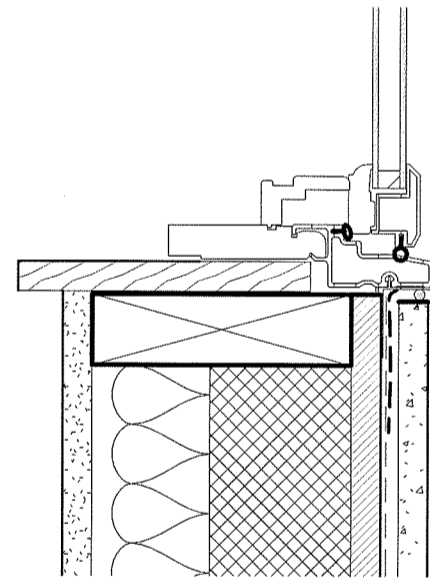


2 WINDOW HEAD AND SILL TYPICAL
3" = 1'-0"

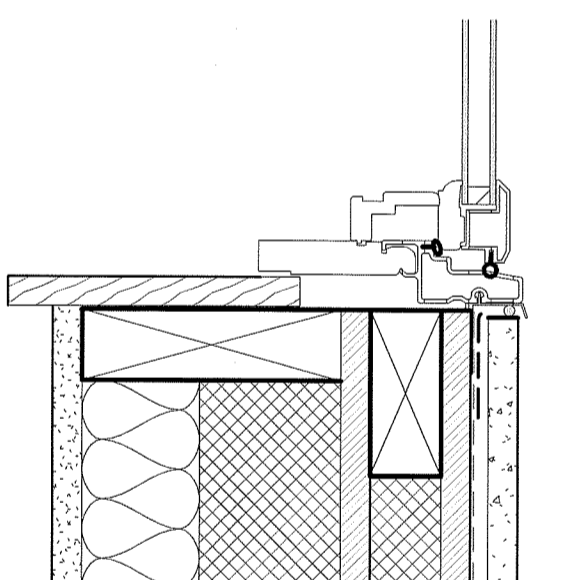

4 WINDOW HEAD AND SILL BUMP-OUT
3" = 1'-0"

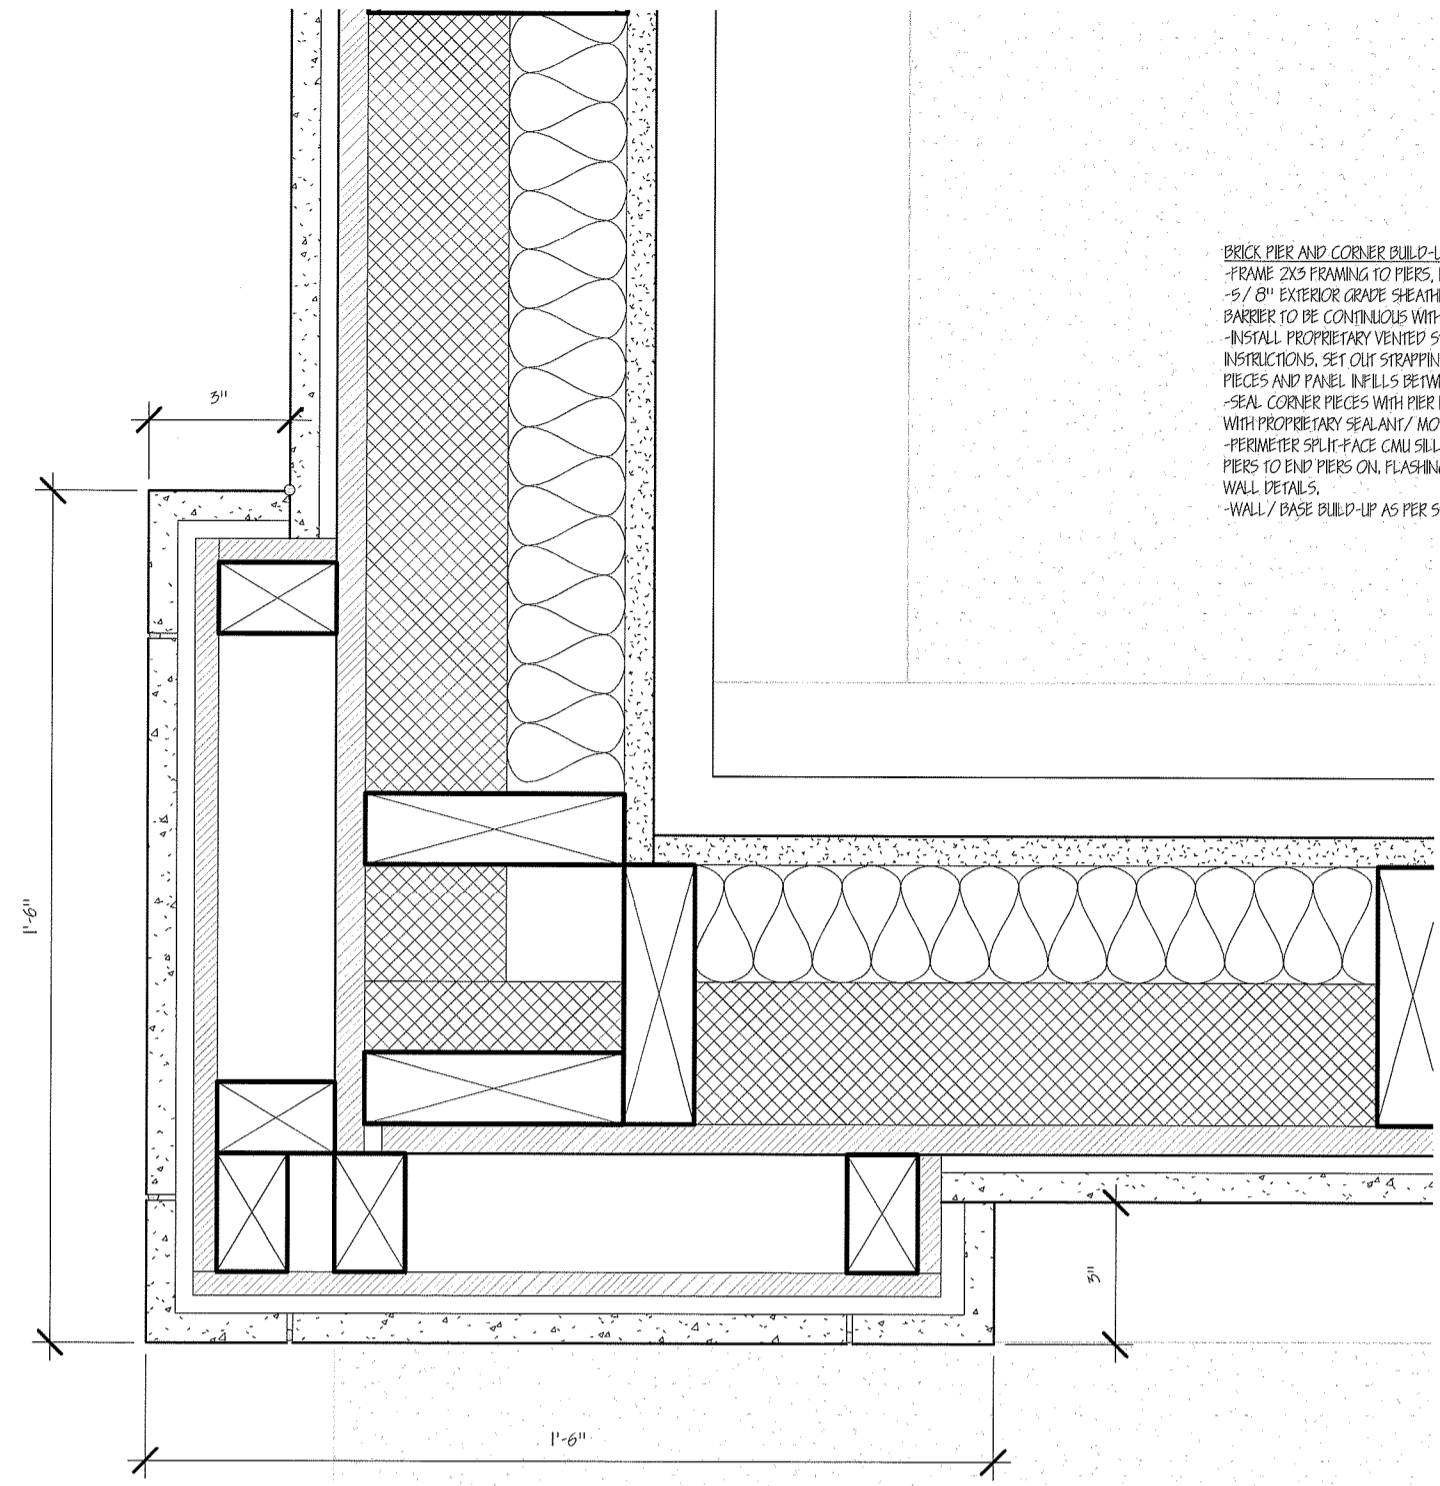


5 Typical Masonry Detail @ Corner
3" = 1'-0"

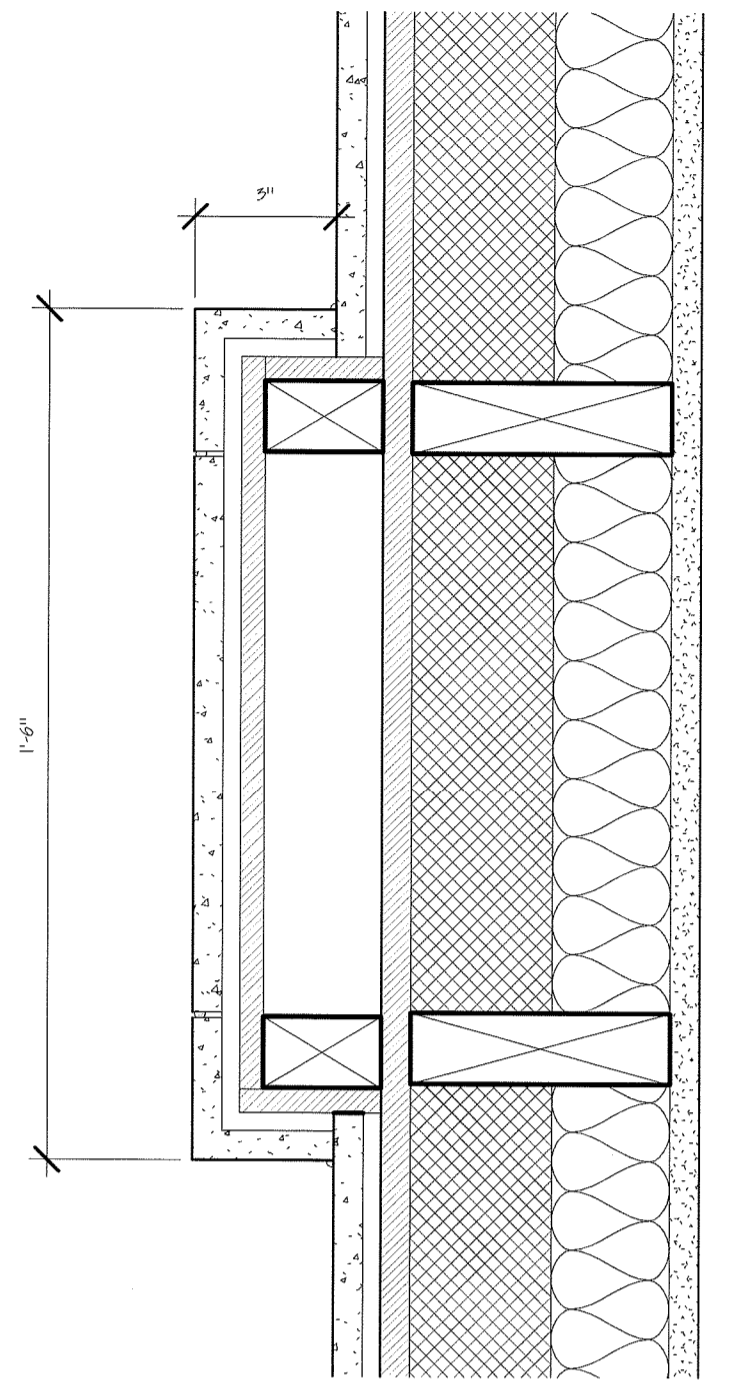

6 Typical Masonry Detail @ Pier
3" = 1'-0"

BRICK PIECE AND CORNER BUILD-UP:
 - 1/2" U-27 FIBERGLASS BATT INSULATION (AT THE ROUGH AND 1/2" FROM FINISH WALL) FROM TO ROUGH AND 1/2" FROM FINISH WALL SHEATHING (SEE ENG. DRAWINGS)
 - WEATHER RESISTIVE SHEATHING (WRS) (SEE ENG. DRAWINGS)
 - 2" U-27 FIBERGLASS BATT INSULATION (AT THE ROUGH AND 1/2" FROM FINISH WALL) FROM TO ROUGH AND 1/2" FROM FINISH WALL SHEATHING (SEE ENG. DRAWINGS)
 - 1/2" GYPSUM BOARD
 - 1/2" SHEETROCK FOR FINISH (SEE FINISH SCHEDULE FOR LOCATION)

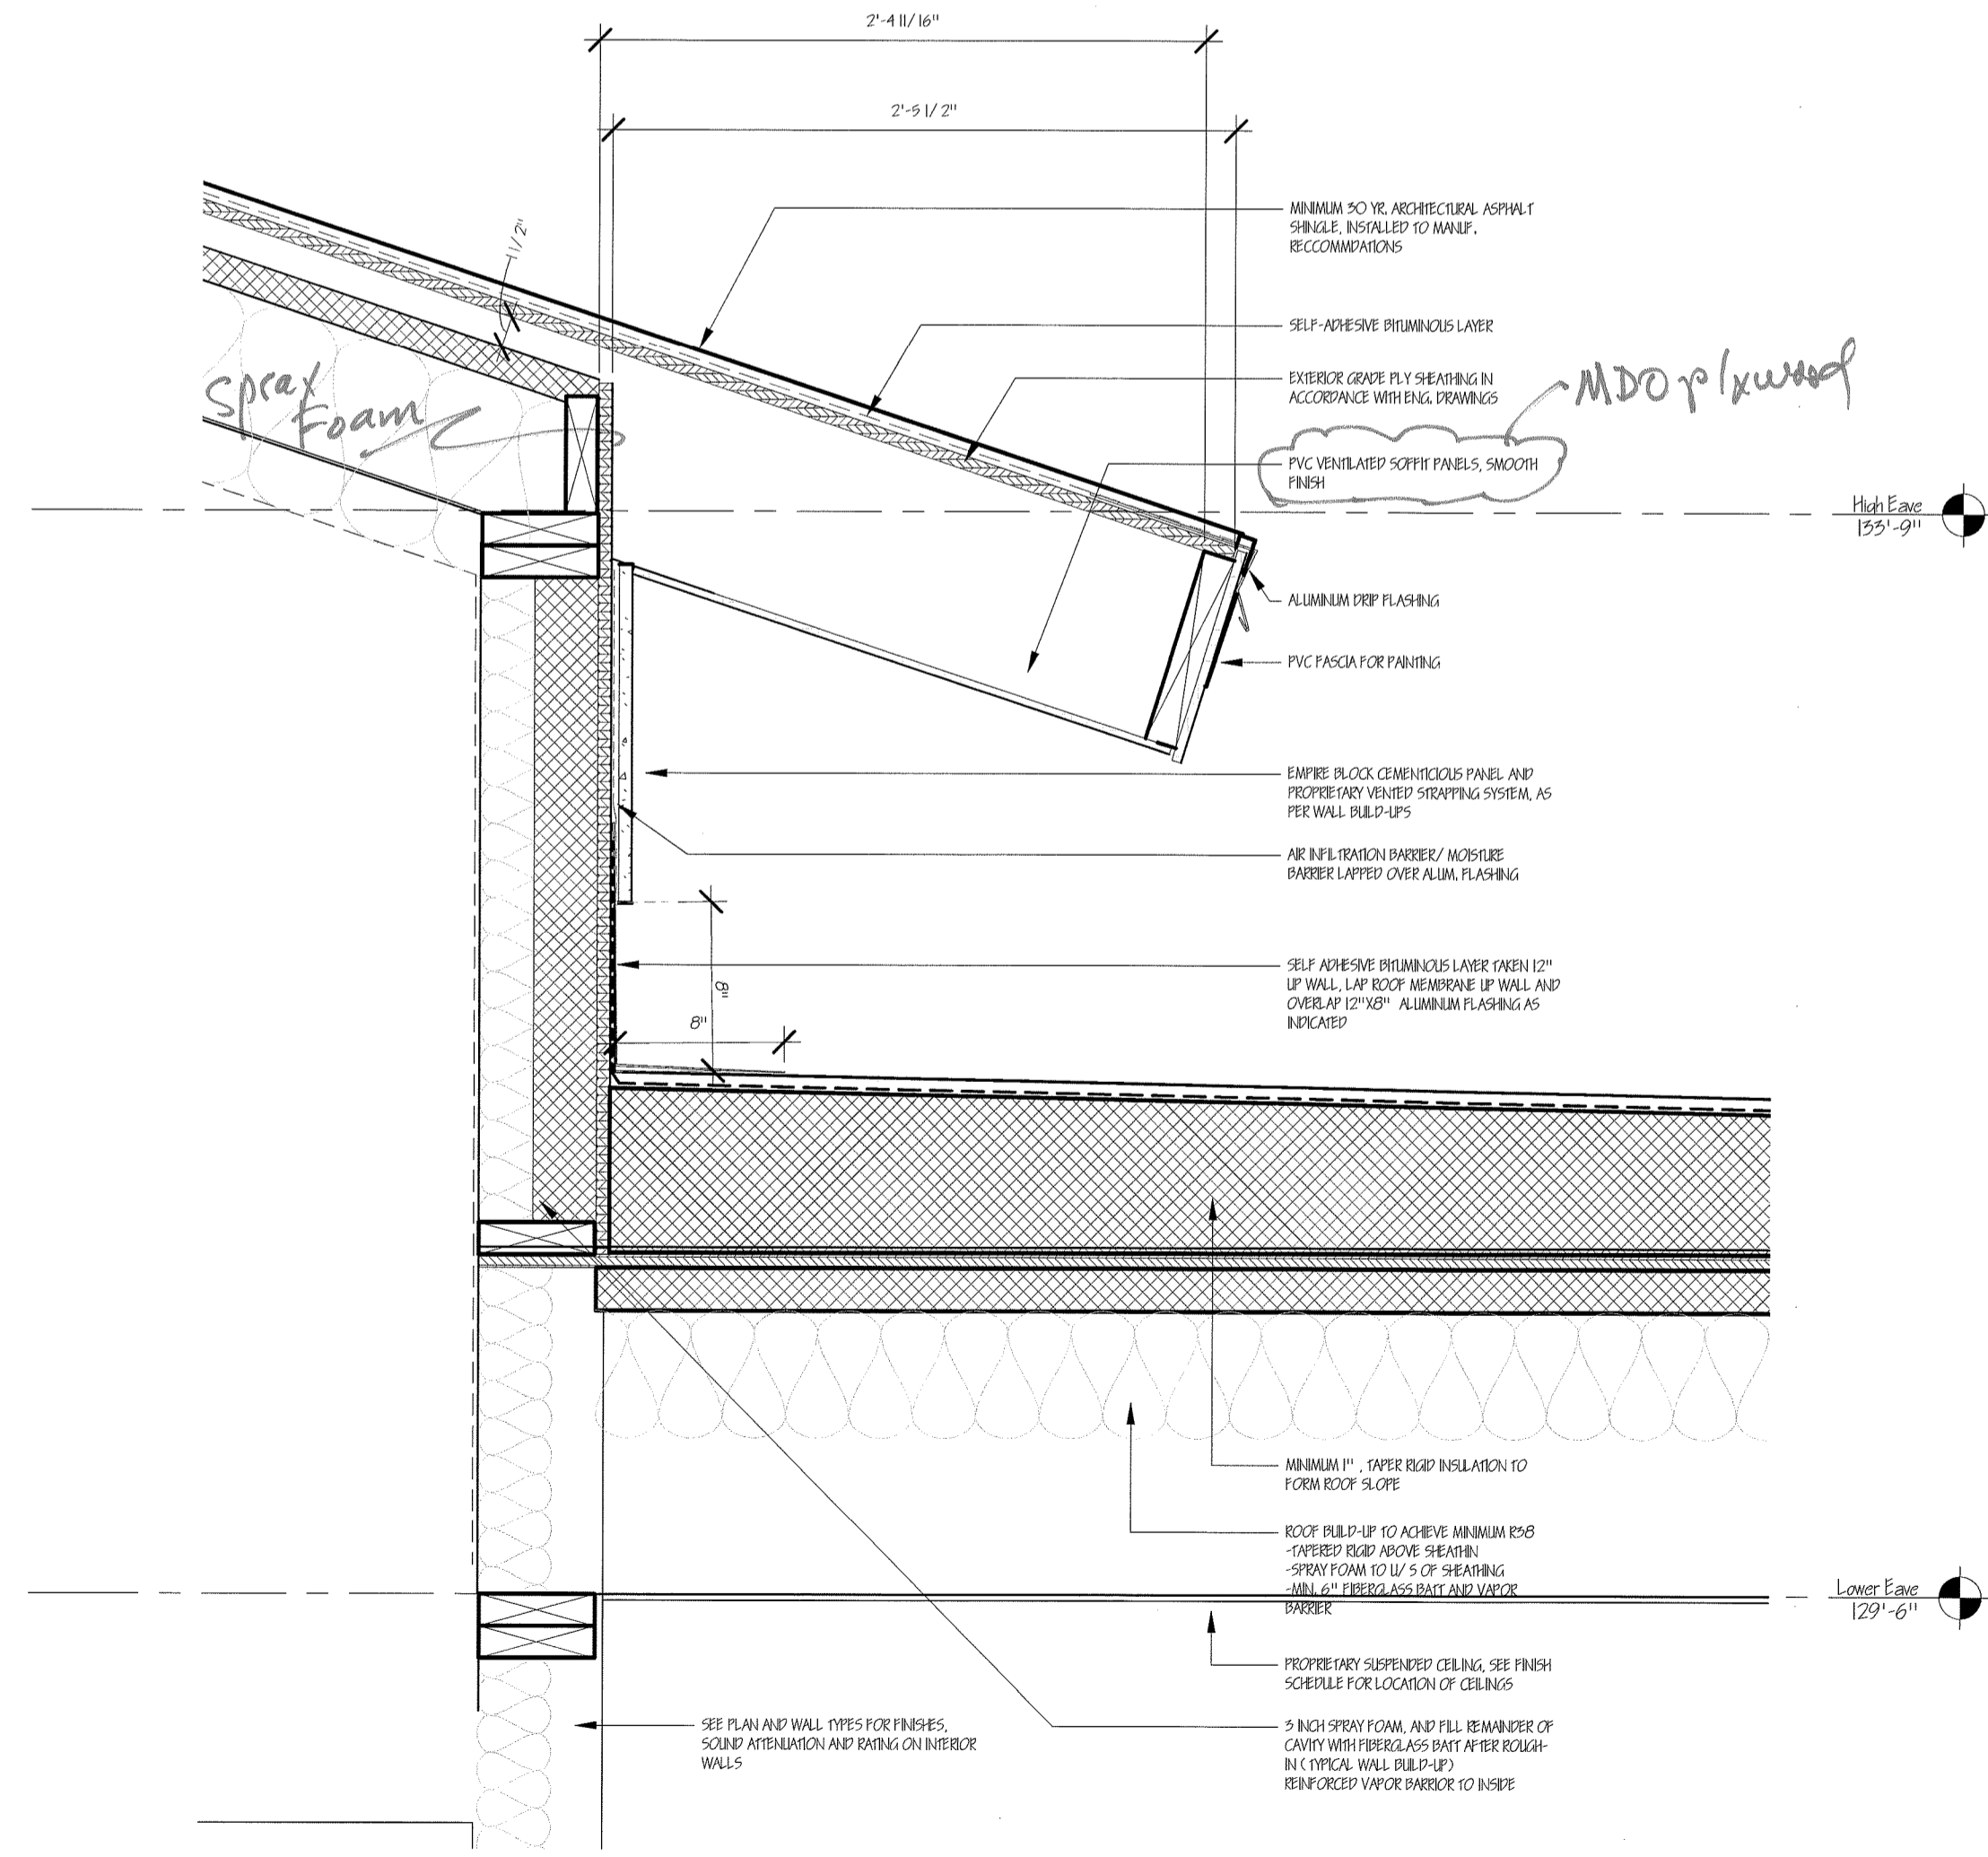

7 CORE ROOF/WALL JUNCTION
1 1/2" = 1'-0"

MINIMUM 30 YR ARCHITECTURAL ASPHALT SHINGLE, INSTALLED TO MANUFACTURER'S RECOMMENDATIONS
 SELF-ADHESIVE PRISMALCUT LAMINATE
 EXTERIOR GRADE FLY SHEATHING IN ACCORDANCE WITH ENG. DRAWINGS
 PVC INSULATED SOFFIT PANELS, SMOOTH FINISH
 ALUMINUM EXP. FLASHING
 PVC FLASHING FOR FABRICATING
 EMPIRE BLOCK CEMENTitious PANEL AND PROPRIETARY WEATHER SHIELDING SYSTEM, AS PER WALL BUILD-UPS
 AIR INFLATION BARRIER/MEMBRANE BARRIER OVER ALUM. FLASHING
 SELF-ADHESIVE PRISMALCUT LAMINATE OVER 1/2" UP WALL, LAP ROCK MEMBRANE IF WALL AND OVER 4" (2" MIN. ALUMINUM FLASHING AS INDICATED)
 MINIMUM 1" SPRAY FOAM BARRIER TO FORM ROOF SLATE
 ROOF BUILD-UP TO ACHIEVE MINIMUM R-10 OVER ROOF ABOVE SHEATHING
 SPRAY FOAM TO 1/2" OF SHEATHING
 AIR INFLATION BARRIER/MEMBRANE
 PROPRIETARY SUSPENDED CEILING, SEE FINISH SCHEDULE FOR LOCATION OF CEILING
 2" INS. OPTICORAL AIR-CELL BARRIER OF CARRY WITH FIBERGLASS BATT AT THE ROUGH IN TYPICAL WALL BUILD-UP
 REINFORCED VAPOR BARRIER TO INSIDE


FOR AS-BUILT PURPOSES ONLY
 - DRAWINGS ARE ISSUED FOR CREATION OF AS-BUILT DRAWINGS ONLY
 - DRAWINGS ISSUED WITHOUT 'RED-LINE' REVISION NOTATION MAY NOT BE CURRENT

GENERAL NOTES:

PROJECT NAME & ADDRESS:
 PLYMOUTH ENTERPRISE CENTER
 Grafton County Economic Development Council
 Plymouth, New Hampshire

EXTERIOR DETAILS
 A6.1

C:\Users\jlp\OneDrive\Documents\GD25 - central MOBE Central Park 8 Rev.mxd

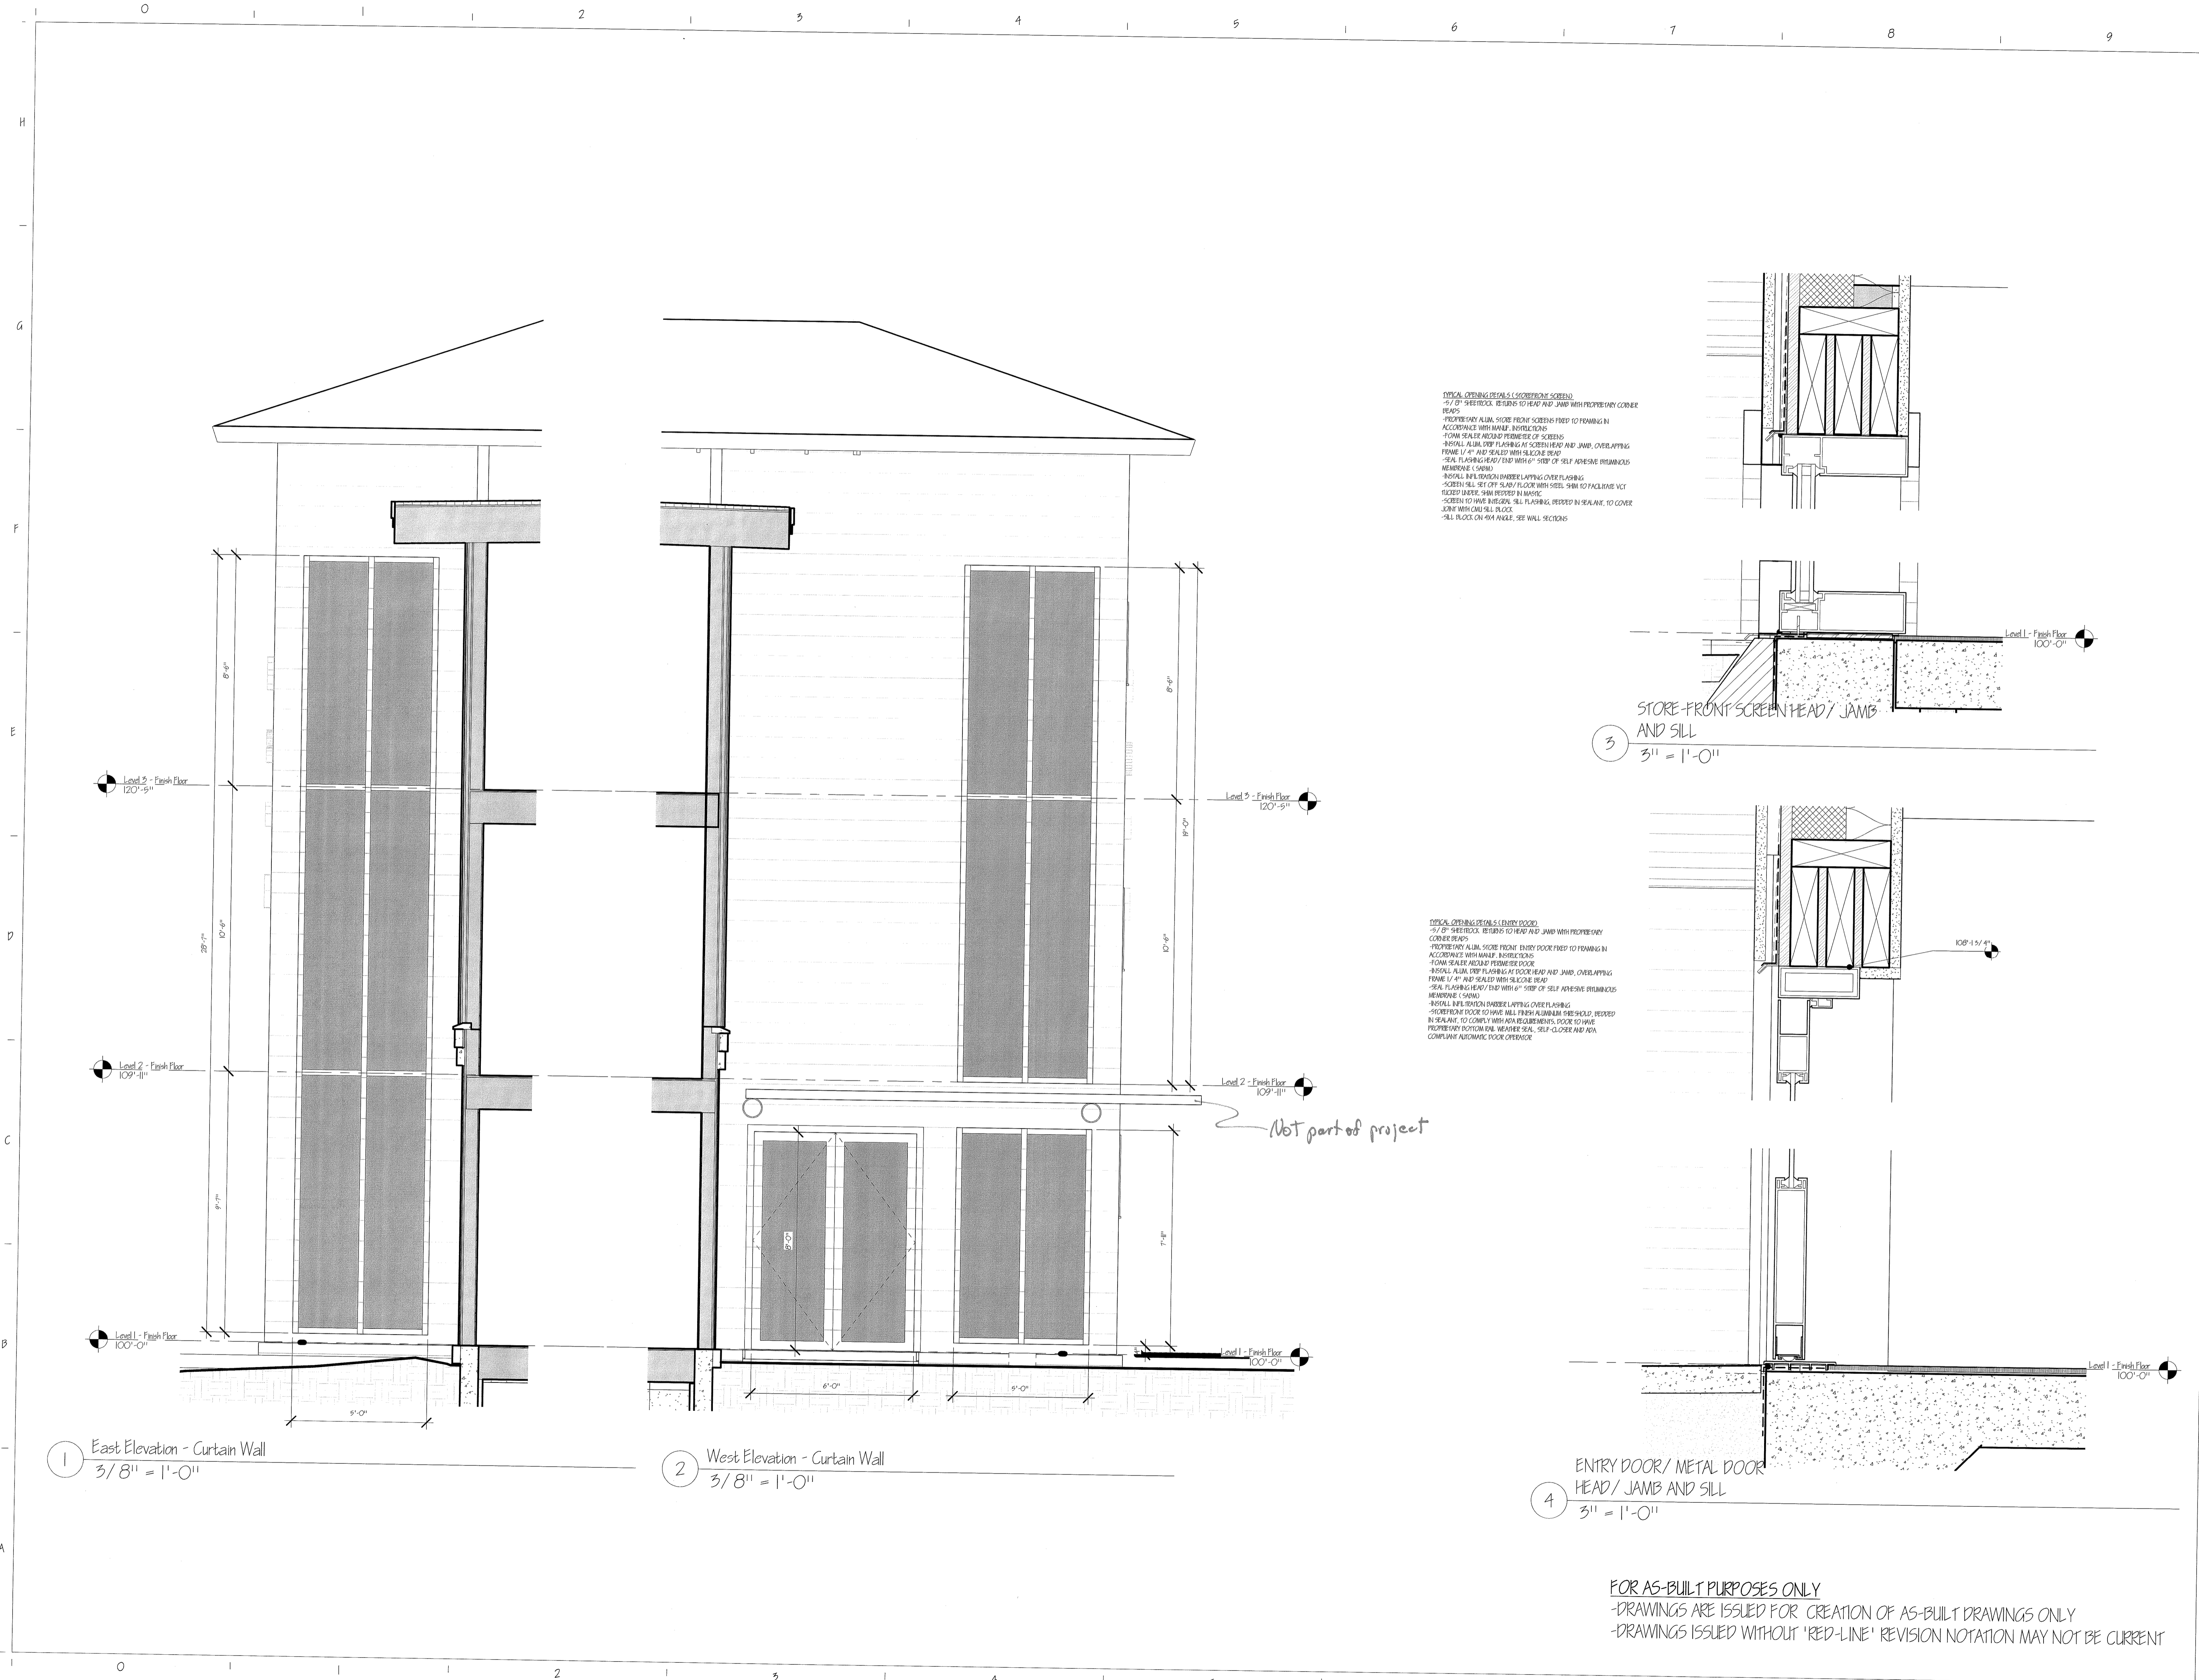

TYPICAL OPENING DETAILS (SCREEN/FRONT SCREEN)
 - 7/8" SHEETROCK. ISOLATE TO HEAD AND JAMB WITH PROPRIETARY CORNER TRIMS
 - PROPRIETARY ALUM. STORE FRONT SCREENS FIXED TO FRAMING IN ACCORDANCE WITH MANUF. INSTRUCTIONS
 - FORM SEALER INSIDE PERIMETER OF SCREENS
 - INSTALL ALUM. Drip FLASHING AT SCREEN HEAD AND JAMB, OVERLAPPING FRAME 1/4" AND SEALED WITH SILICONE BEAD
 - SEAL FLASHING HEAD/ JAMB WITH 6" STRIP OF SELF ADHESIVE PREMANUKS MEMBRANE (SAND)
 - INSTALL INSULATION UNDER LAPPING OVER FLASHING
 - SCREENS ALL SET OFF SLAB/ FLOOR WITH STEEL RIM TO FACILITATE VET
 - SCREENS TO HAVE INTEGRAL, SELF ADHESIVE, BEADED IN RELIEF, TO COVER SLAB WITH ONE FULL BLOCK
 - ALL BLOCKS ON 45° ANGLE. SEE WALL SECTIONS

TYPICAL OPENING DETAILS (ENTRY DOOR)
 - 7/8" SHEETROCK. ISOLATE TO HEAD AND JAMB WITH PROPRIETARY CORNER TRIMS
 - PROPRIETARY ALUM. STORE FRONT ENTRY DOOR FIXED TO FRAMING IN ACCORDANCE WITH MANUF. INSTRUCTIONS
 - FORM SEALER INSIDE PERIMETER OF DOOR
 - INSTALL ALUM. Drip FLASHING AT DOOR HEAD AND JAMB, OVERLAPPING FRAME 1/4" AND SEALED WITH SILICONE BEAD
 - SEAL FLASHING HEAD/ JAMB WITH 6" STRIP OF SELF ADHESIVE PREMANUKS MEMBRANE (SAND)
 - INSTALL INSULATION UNDER LAPPING OVER FLASHING
 - STORE FRONT DOOR TO HAVE FULL FINISH ALUMINUM SHROULD, BEDED IN RELIEF, TO COVER WITH AN INSULATED, FOAM TO HAVE PROPRIETARY BOTTOM SEAL, SELF-CLOSING AND ADA COMPLIANT AUTOMATIC DOOR OPERATOR

Not part of project


FOR AS-BUILT PURPOSES ONLY
 -DRAWINGS ARE ISSUED FOR CREATION OF AS-BUILT DRAWINGS ONLY
 -DRAWINGS ISSUED WITHOUT "RED-LINE" REVISION NOTATION MAY NOT BE CURRENT

GENERAL NOTES:

PROJECT NAME & ADDRESS:
 PLYMOUTH ENTERPRISE CENTER
 Grafton County Economic Development Council
 Plymouth, New Hampshire


EXTERIOR DETAILS

A6.2

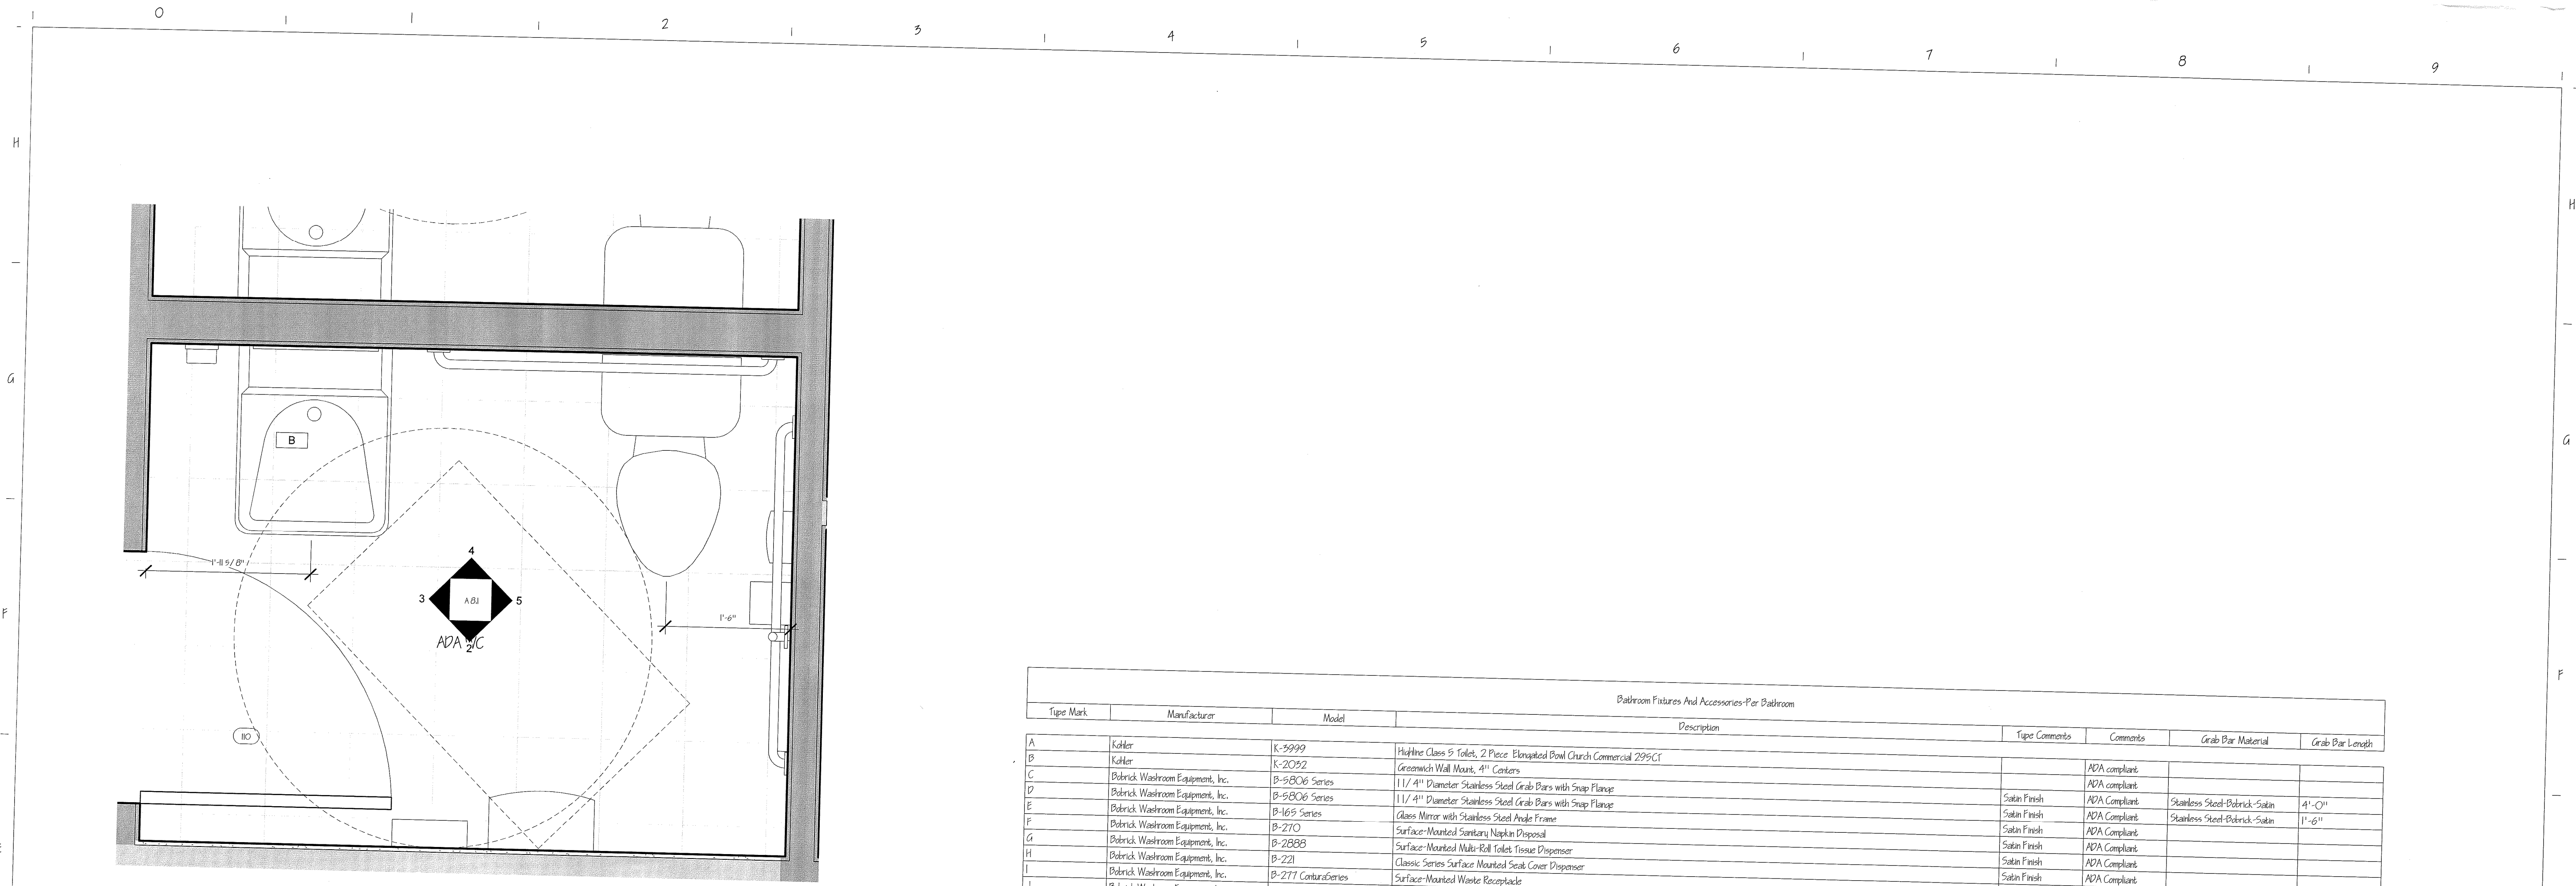


1 TYPICAL BATHROOM LAYOUT
1" = 1'-0"


Type Mark	Manufacturer	Model	Description	Type Comments	Comments	Grab Bar Material	Grab Bar Length
A	Kohler	K-9999	Highline Class 5 Toilet, 2 Piece, Elongated, Pool Church Commercial 299C1				
B	Kohler	K-2092	Greenwich Wall Mount, 4" Centers		ADA Compliant		
C	Patrick Washroom Equipment, Inc.	B-9806 Series	11/4" Diameter Stainless Steel Grab Bars with Snap Flange		ADA Compliant		
D	Patrick Washroom Equipment, Inc.	B-9806 Series	11/4" Diameter Stainless Steel Grab Bars with Snap Flange	Satin Finish	ADA Compliant	Stainless Steel Patrick-Satin	4'-0"
E	Patrick Washroom Equipment, Inc.	B-169 Series	Glass Mirror with Stainless Steel Ankle Frame	Satin Finish	ADA Compliant	Stainless Steel Patrick-Satin	1'-6"
F	Patrick Washroom Equipment, Inc.	B-270	Surface-Mounted Sanitary Napkin Dispenser	Satin Finish	ADA Compliant		
G	Patrick Washroom Equipment, Inc.	B-2888	Surface-Mounted Multi-Roll Toilet Tissue Dispenser	Satin Finish	ADA Compliant		
H	Patrick Washroom Equipment, Inc.	B-221	Classic Series Surface-Mounted Sink Cover Dispenser	Satin Finish	ADA Compliant		
I	Patrick Washroom Equipment, Inc.	B-277 ContourSeries	Surface-Mounted Waste Receptacle	Satin Finish	ADA Compliant		
J	Patrick Washroom Equipment, Inc.	B-262 ClassicSeries	Surface-Mounted Paper Towel Dispenser	Satin Finish	ADA Compliant		
K	Patrick Washroom Equipment, Inc.	B-2111	Classic Series Surface-Mounted Soap Dispenser	Satin Finish	ADA Compliant		

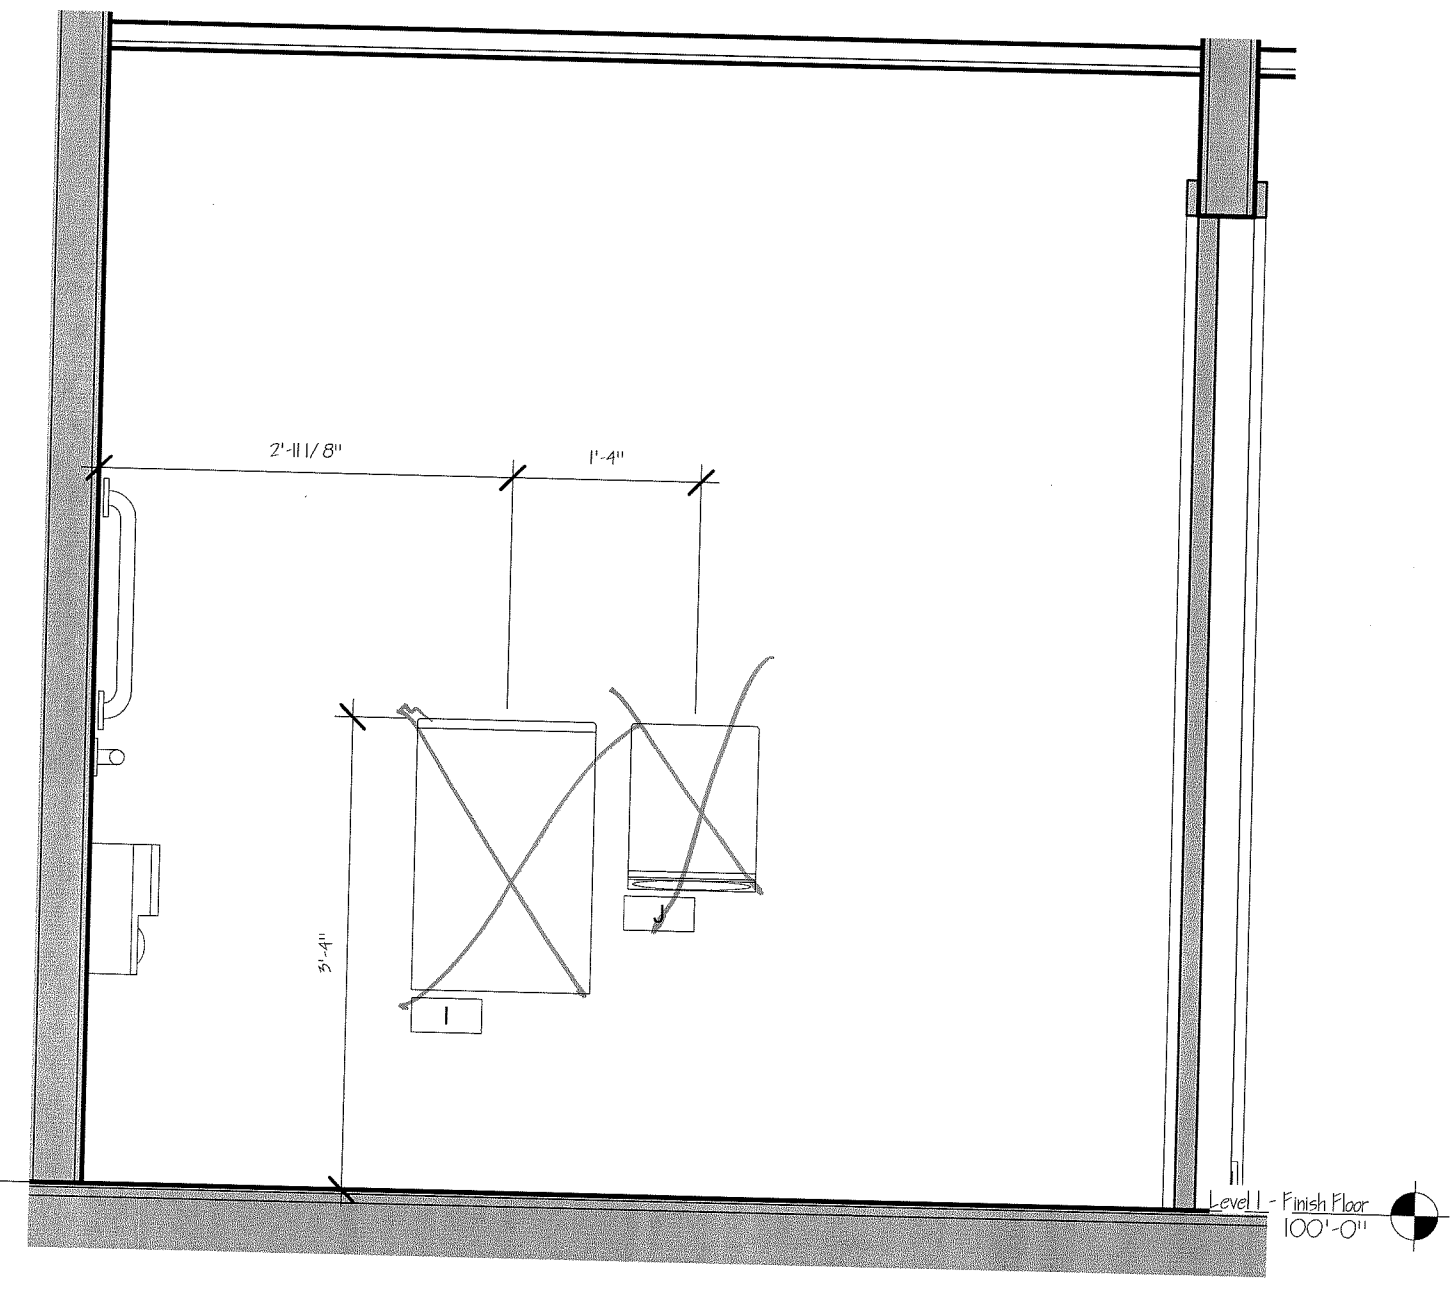


2 ADA TOILET 1
3/4" = 1'-0"

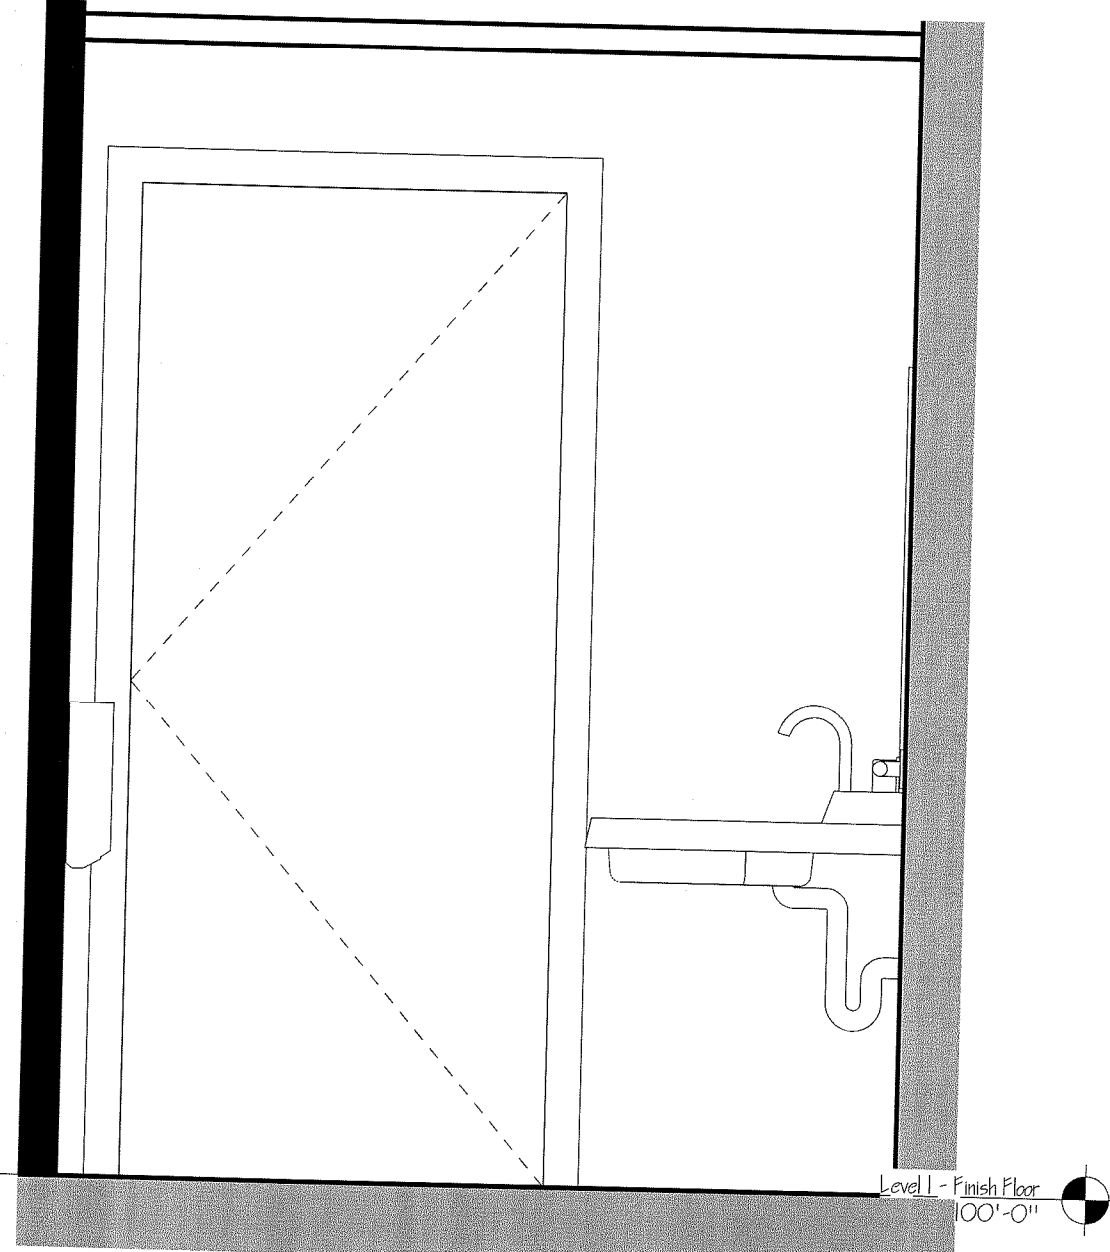

3 ADA TOILET 2
3/4" = 1'-0"

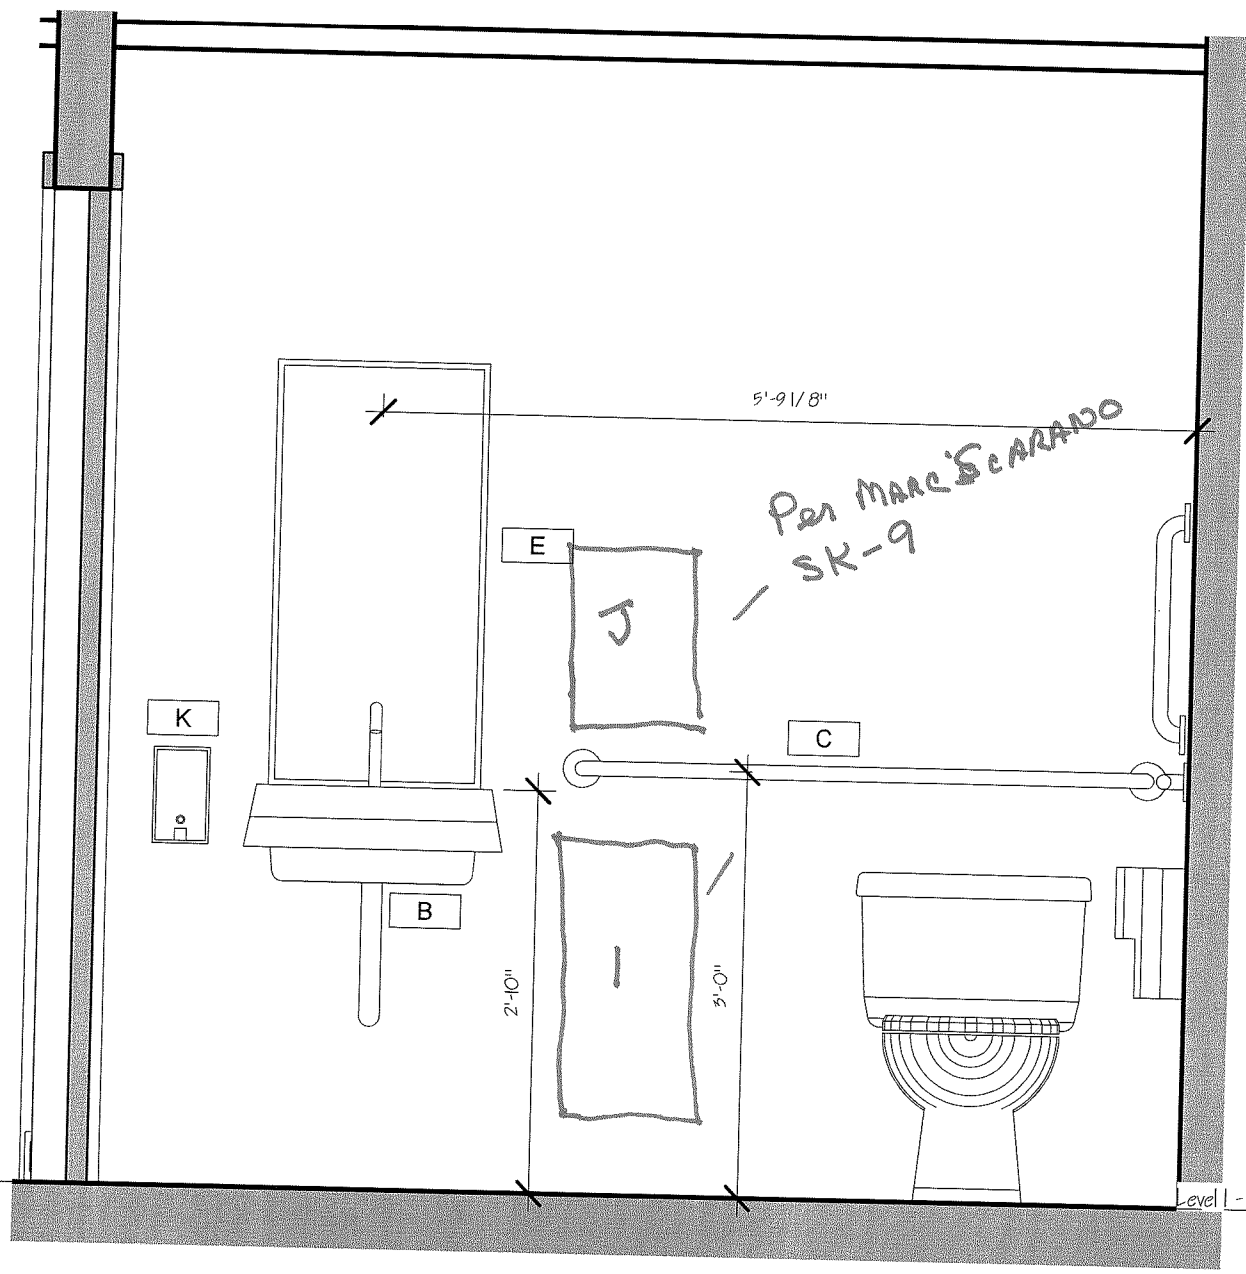

4 ADA TOILET 3
3/4" = 1'-0"

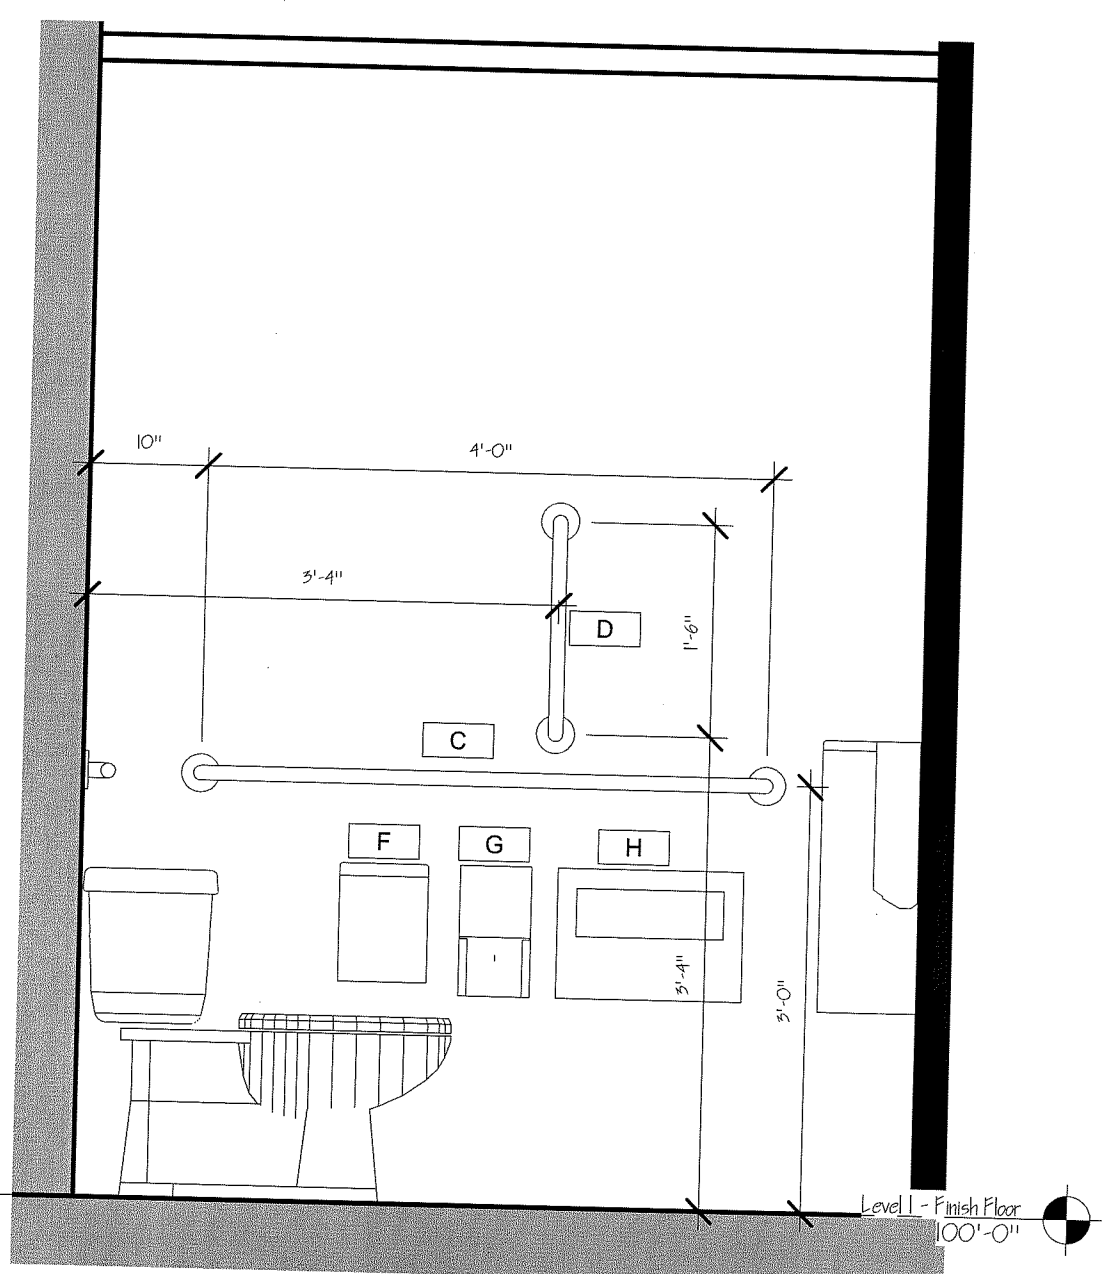

5 ADA TOILET 4
3/4" = 1'-0"

FOR AS-BUILT PURPOSES ONLY
-DRAWINGS ARE ISSUED FOR CREATION OF AS-BUILT DRAWINGS ONLY
-DRAWINGS ISSUED WITHOUT 'RED-LINE' REVISION NOTATION MAY NOT BE CURRENT


GENERAL NOTES

PROJECT NAME & ADDRESS:
PLYMOUTH ENTERPRISE CENTER
Grafton County Economic Development Council
Plymouth, New Hampshire

INTERIOR DETAILS - BATHROOMS A 8.1


C:\Users\jlp\OneDrive\Documents\03262 - Central Middle School\Central Middle School.dwg

1 Kitchen Layout
1/2" = 1'-0"

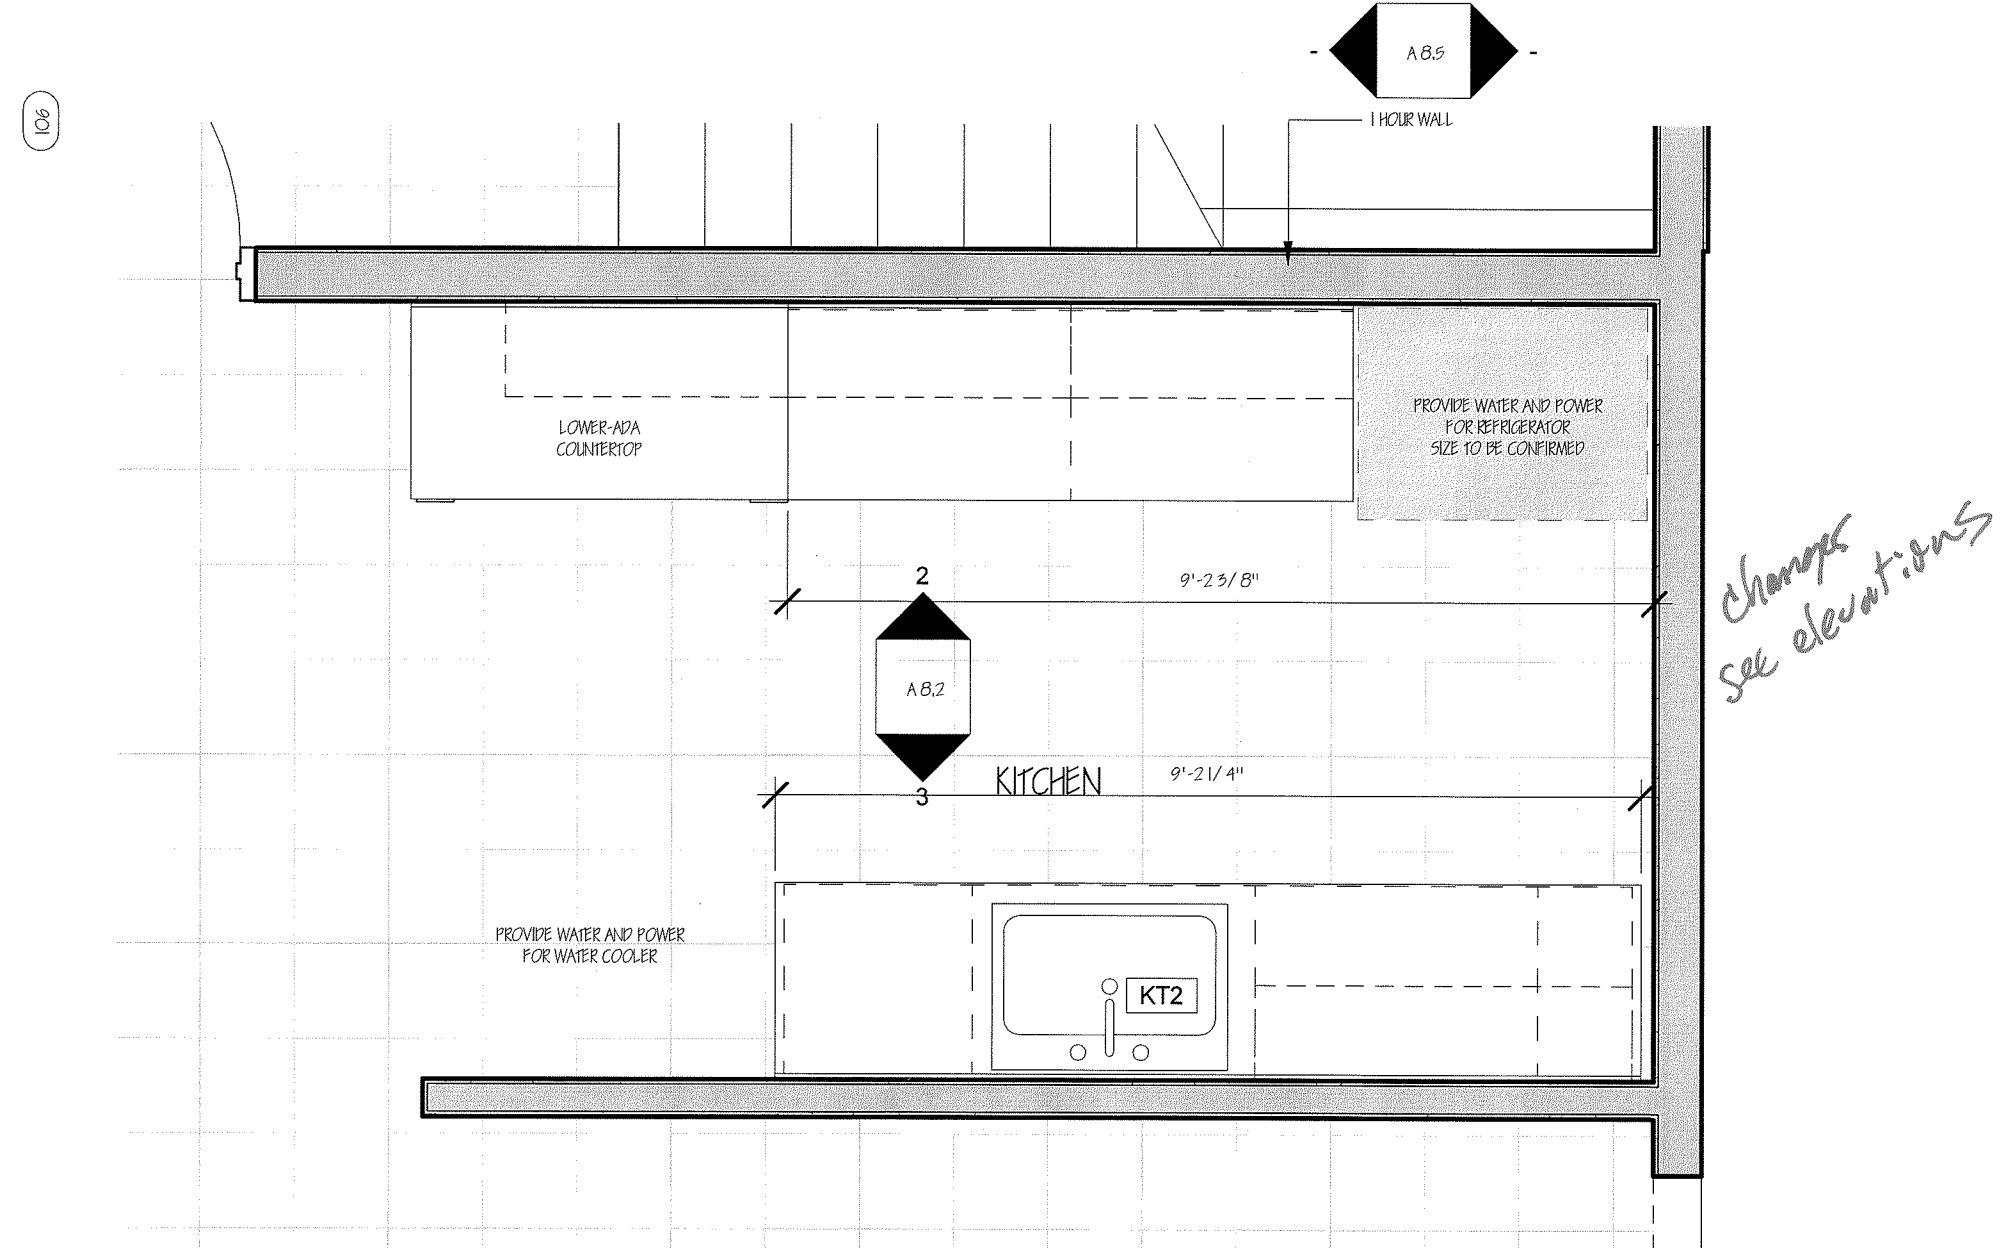


KITCHEN FIXTURES			
Type Mark	Manufacturer	Model	Comments
KT2	Dalton	Z2	Stainless Steel Z2 Glass Top Mount


5 KITCHEN/FOUNTAIN
1/2" = 1'-0"

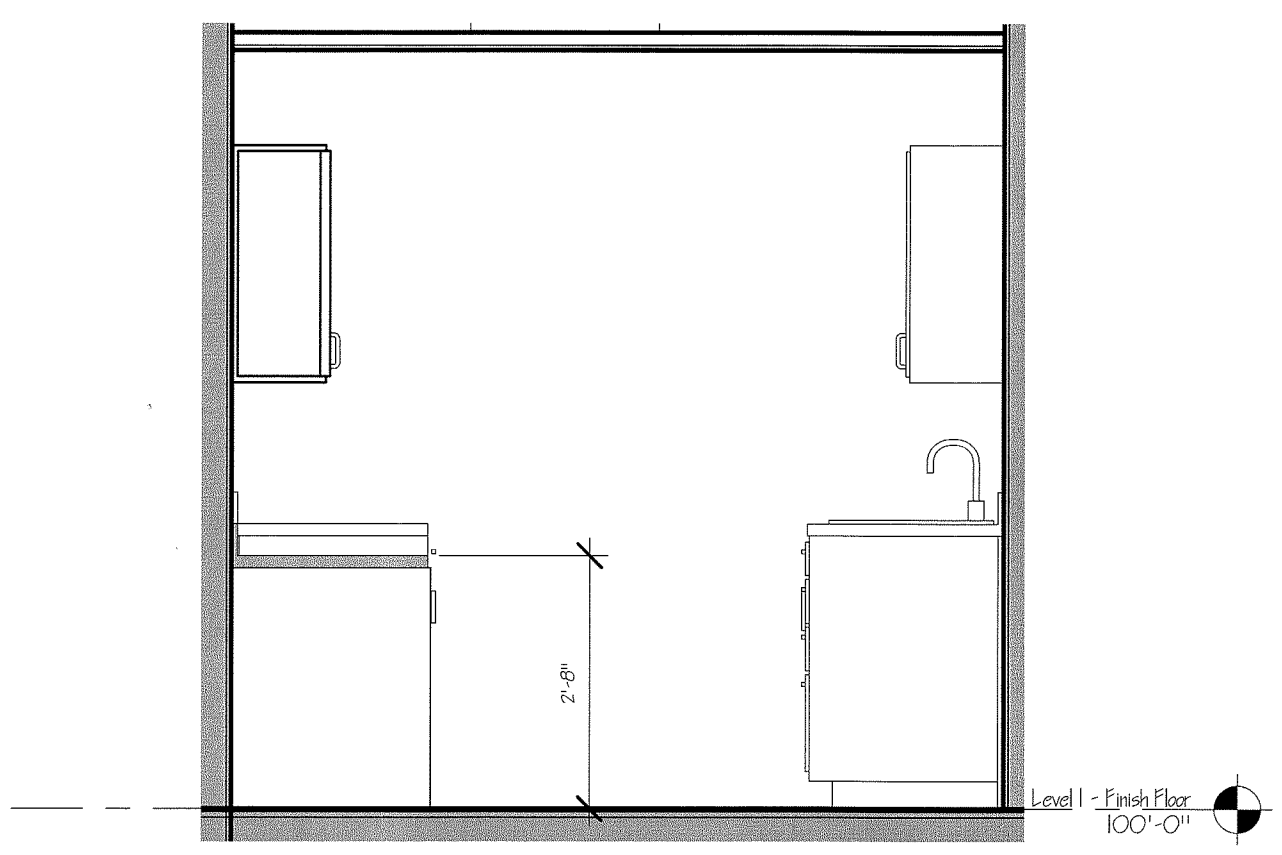

3 KITCHEN SOUTH WALL
1/2" = 1'-0"

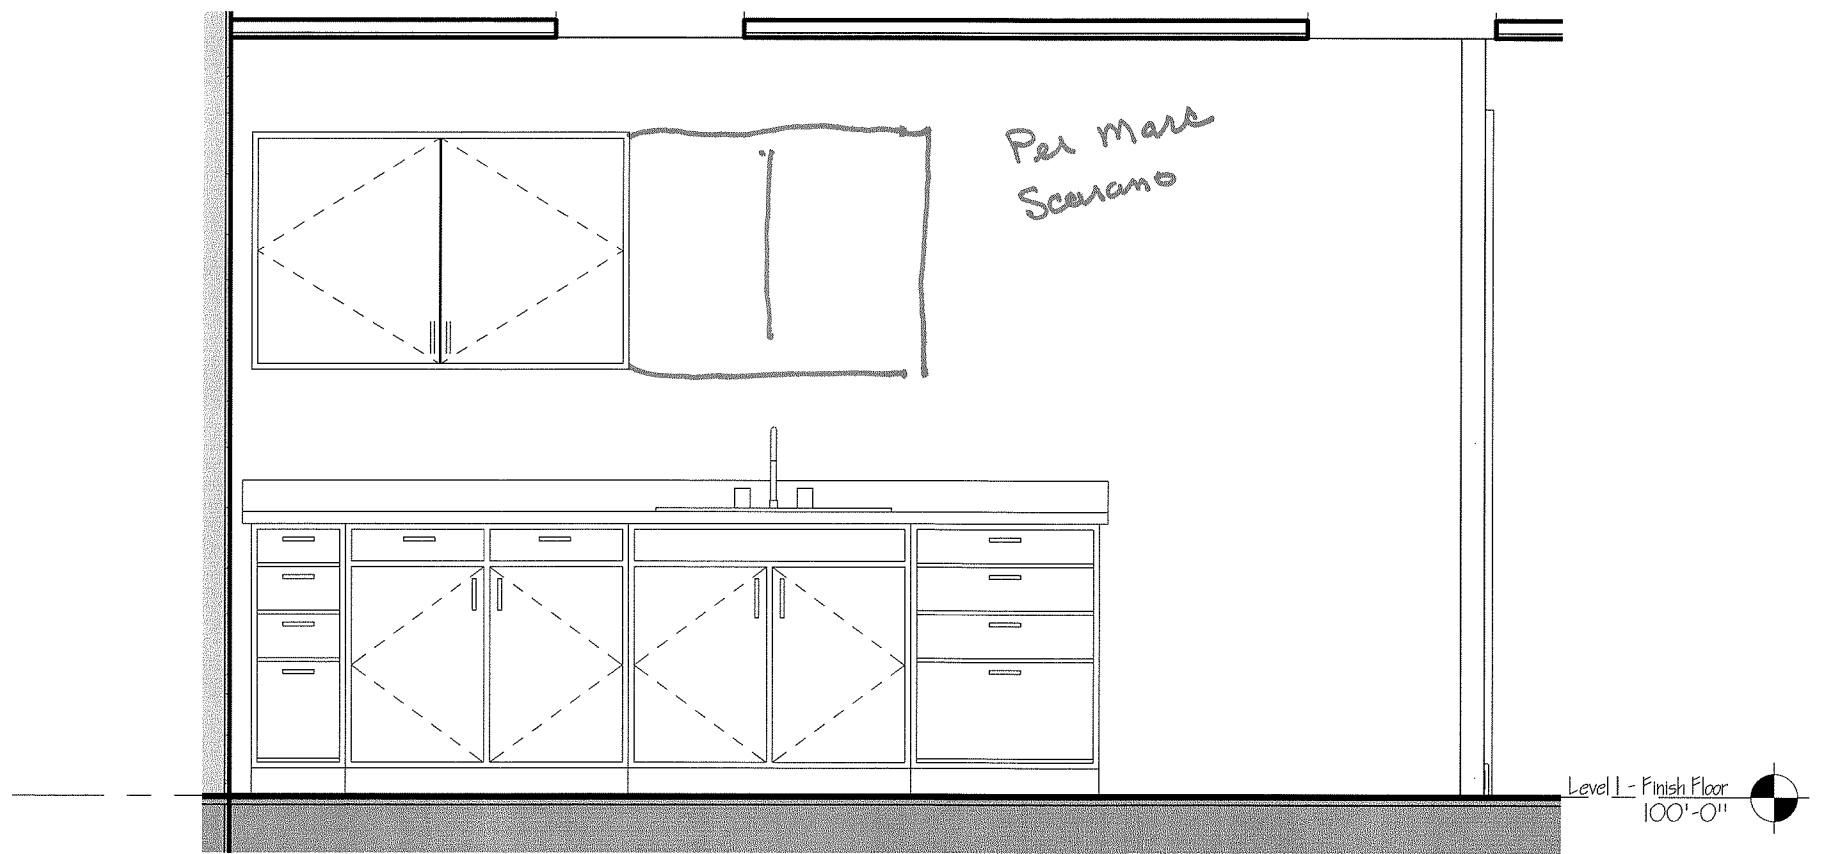

2 KITCHEN NORTH WALL
1/2" = 1'-0"

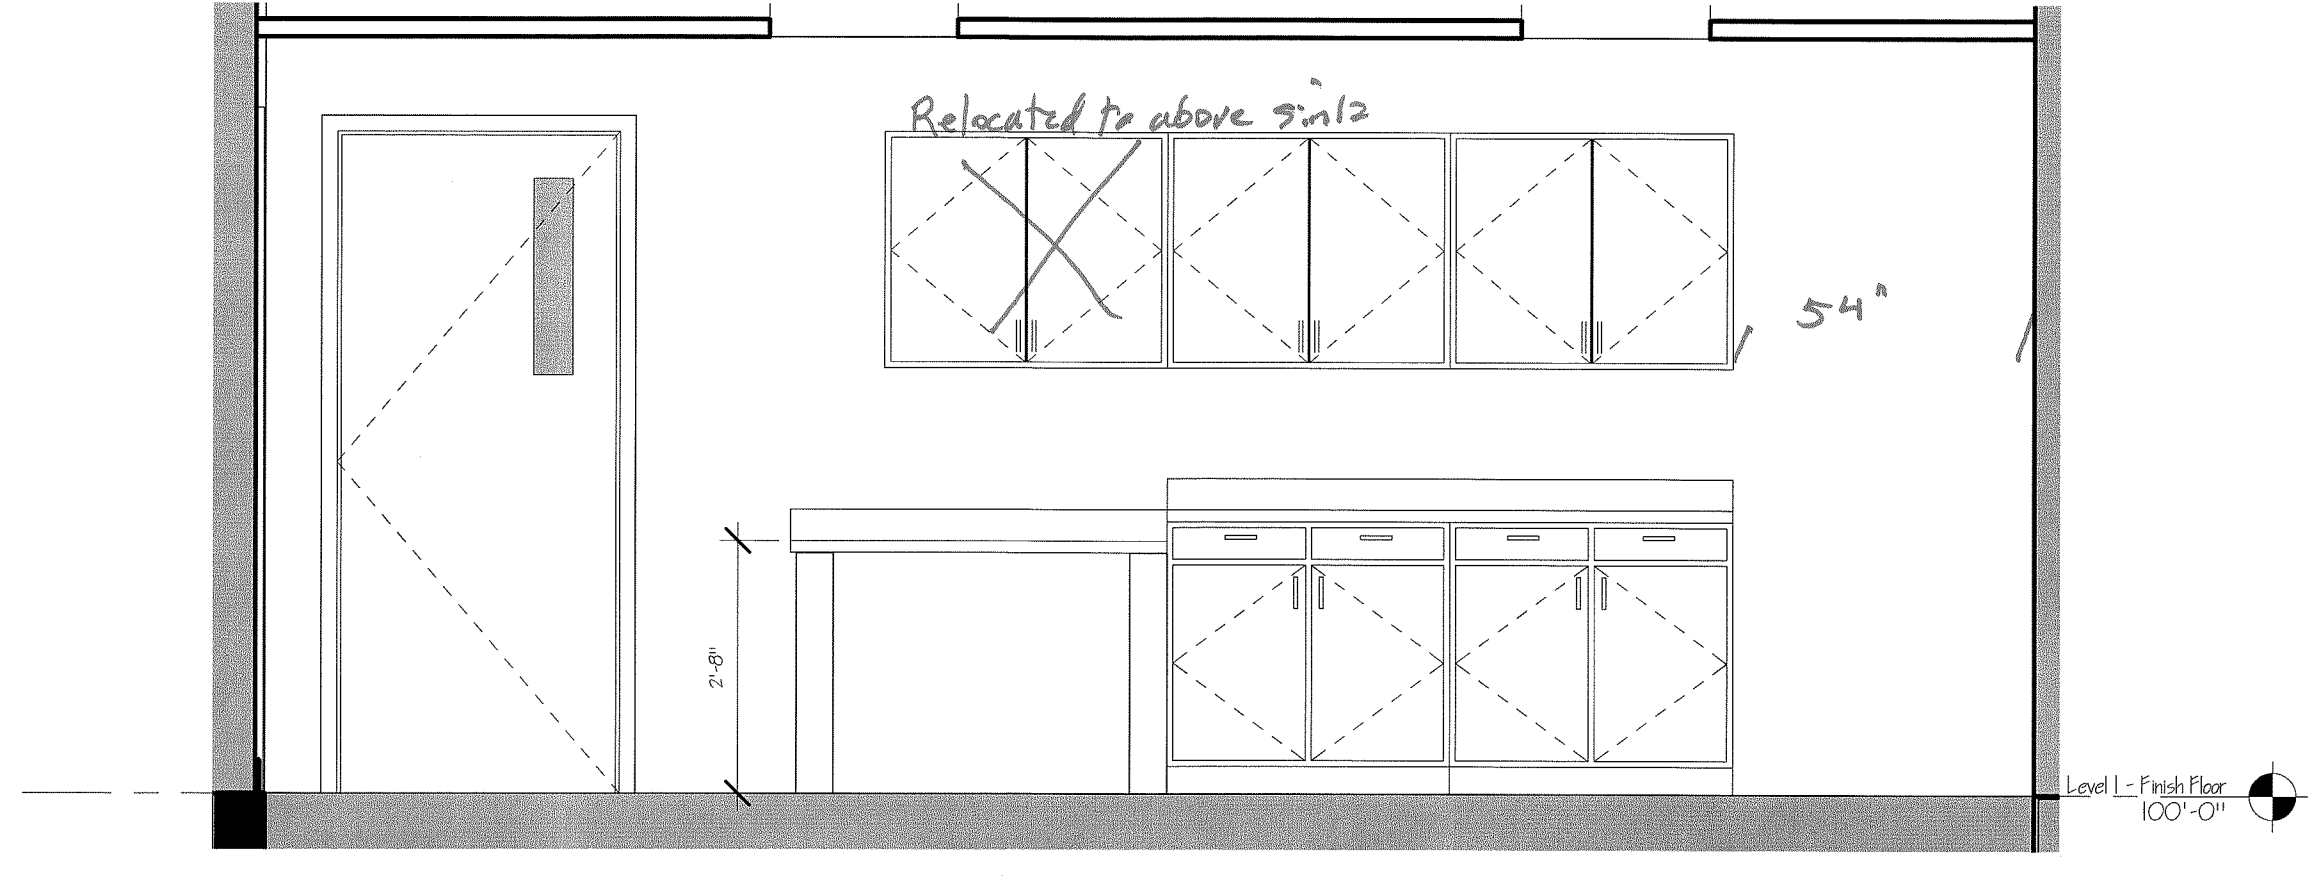


FOR AS-BUILT PURPOSES ONLY
-DRAWINGS ARE ISSUED FOR CREATION OF AS-BUILT DRAWINGS ONLY
-DRAWINGS ISSUED WITHOUT 'RED-LINE' REVISION NOTATION MAY NOT BE CURRENT


GENERAL NOTES:

PROJECT NAME & ADDRESS:
PLYMOUTH ENTERPRISE CENTER
Grafton County Economic Development Council
Plymouth, New Hampshire


INTERIOR DETAILS - KITCHEN A.8.2

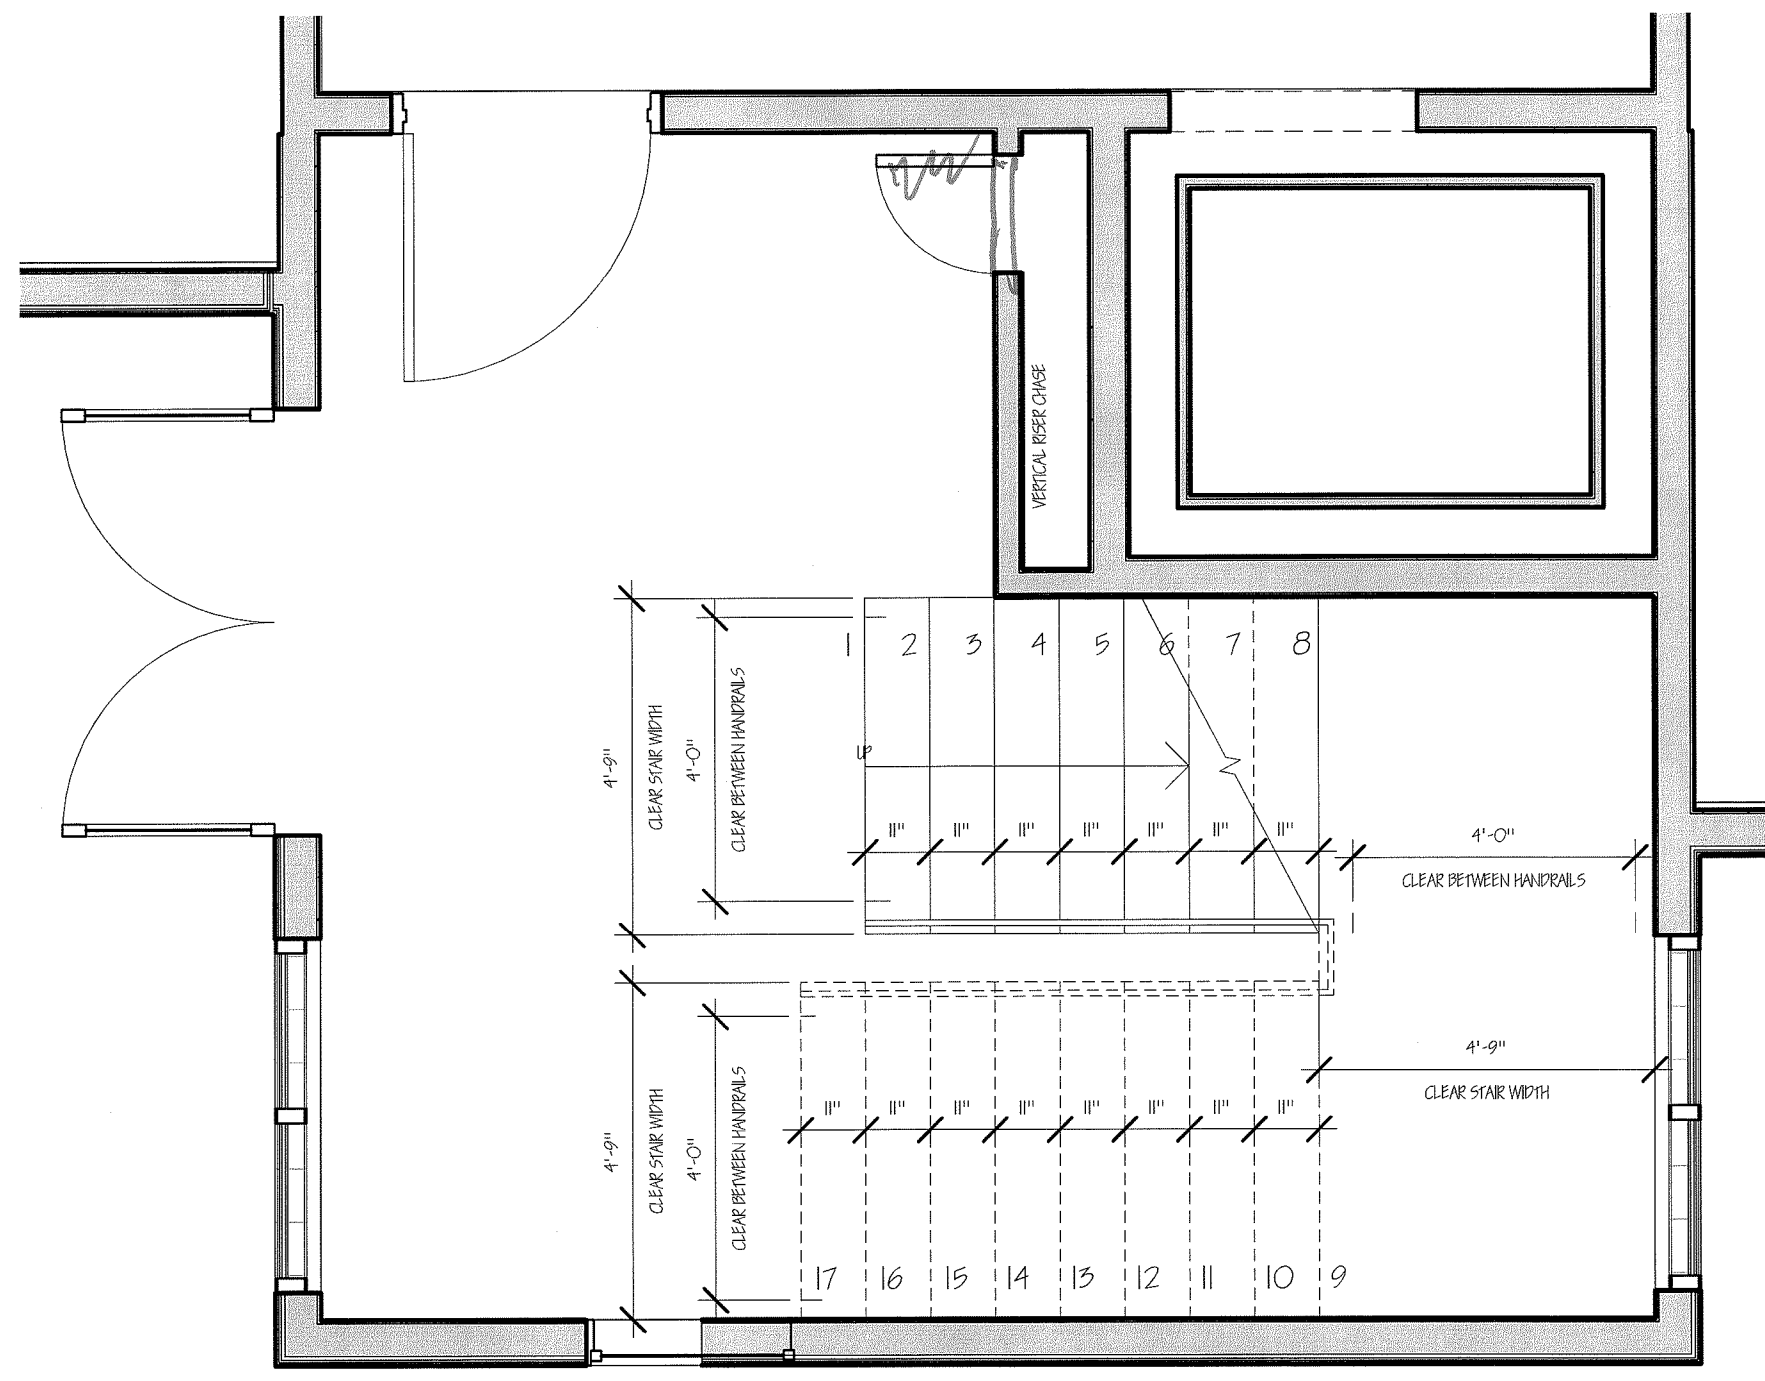

1 Stair 1 - Level 1
3/8" = 1'-0"

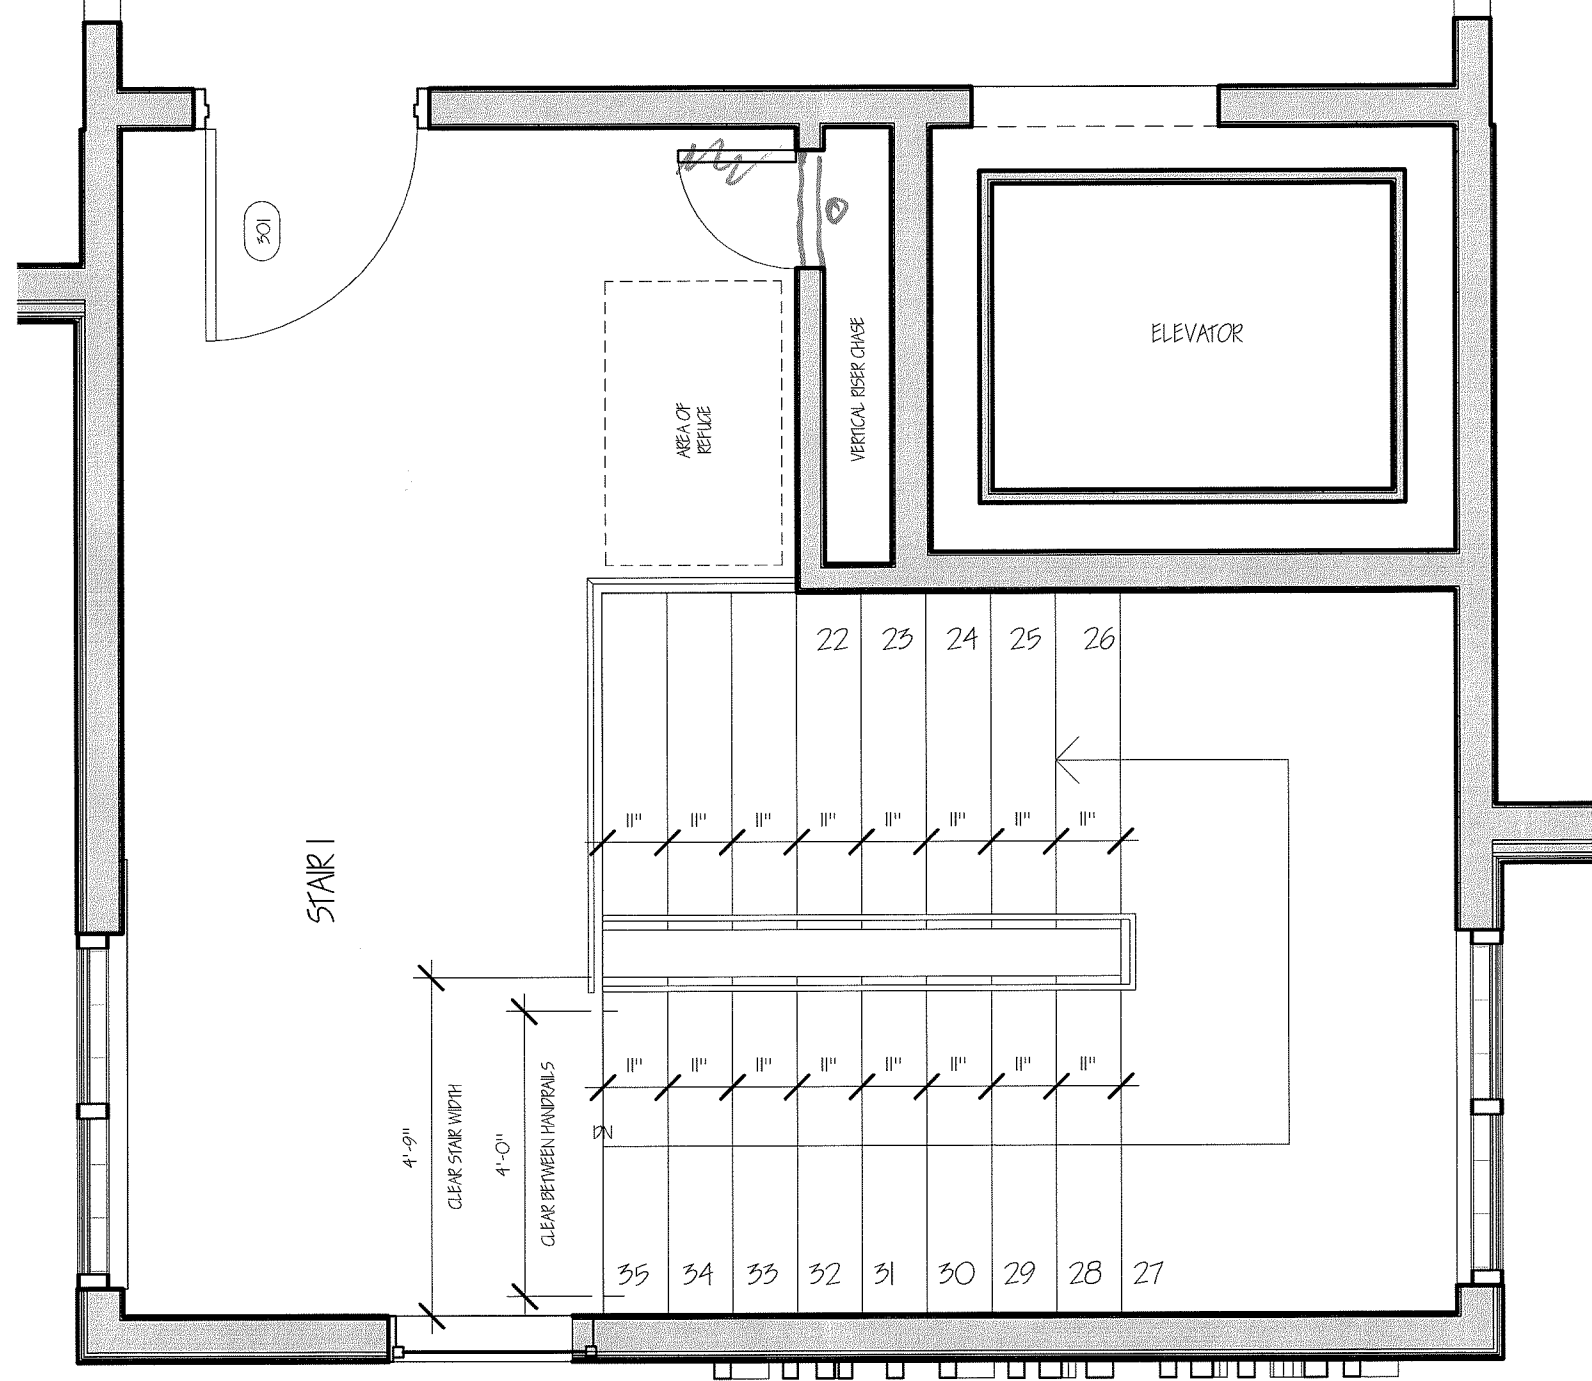

3 Stair 1 - Level 3
3/8" = 1'-0"

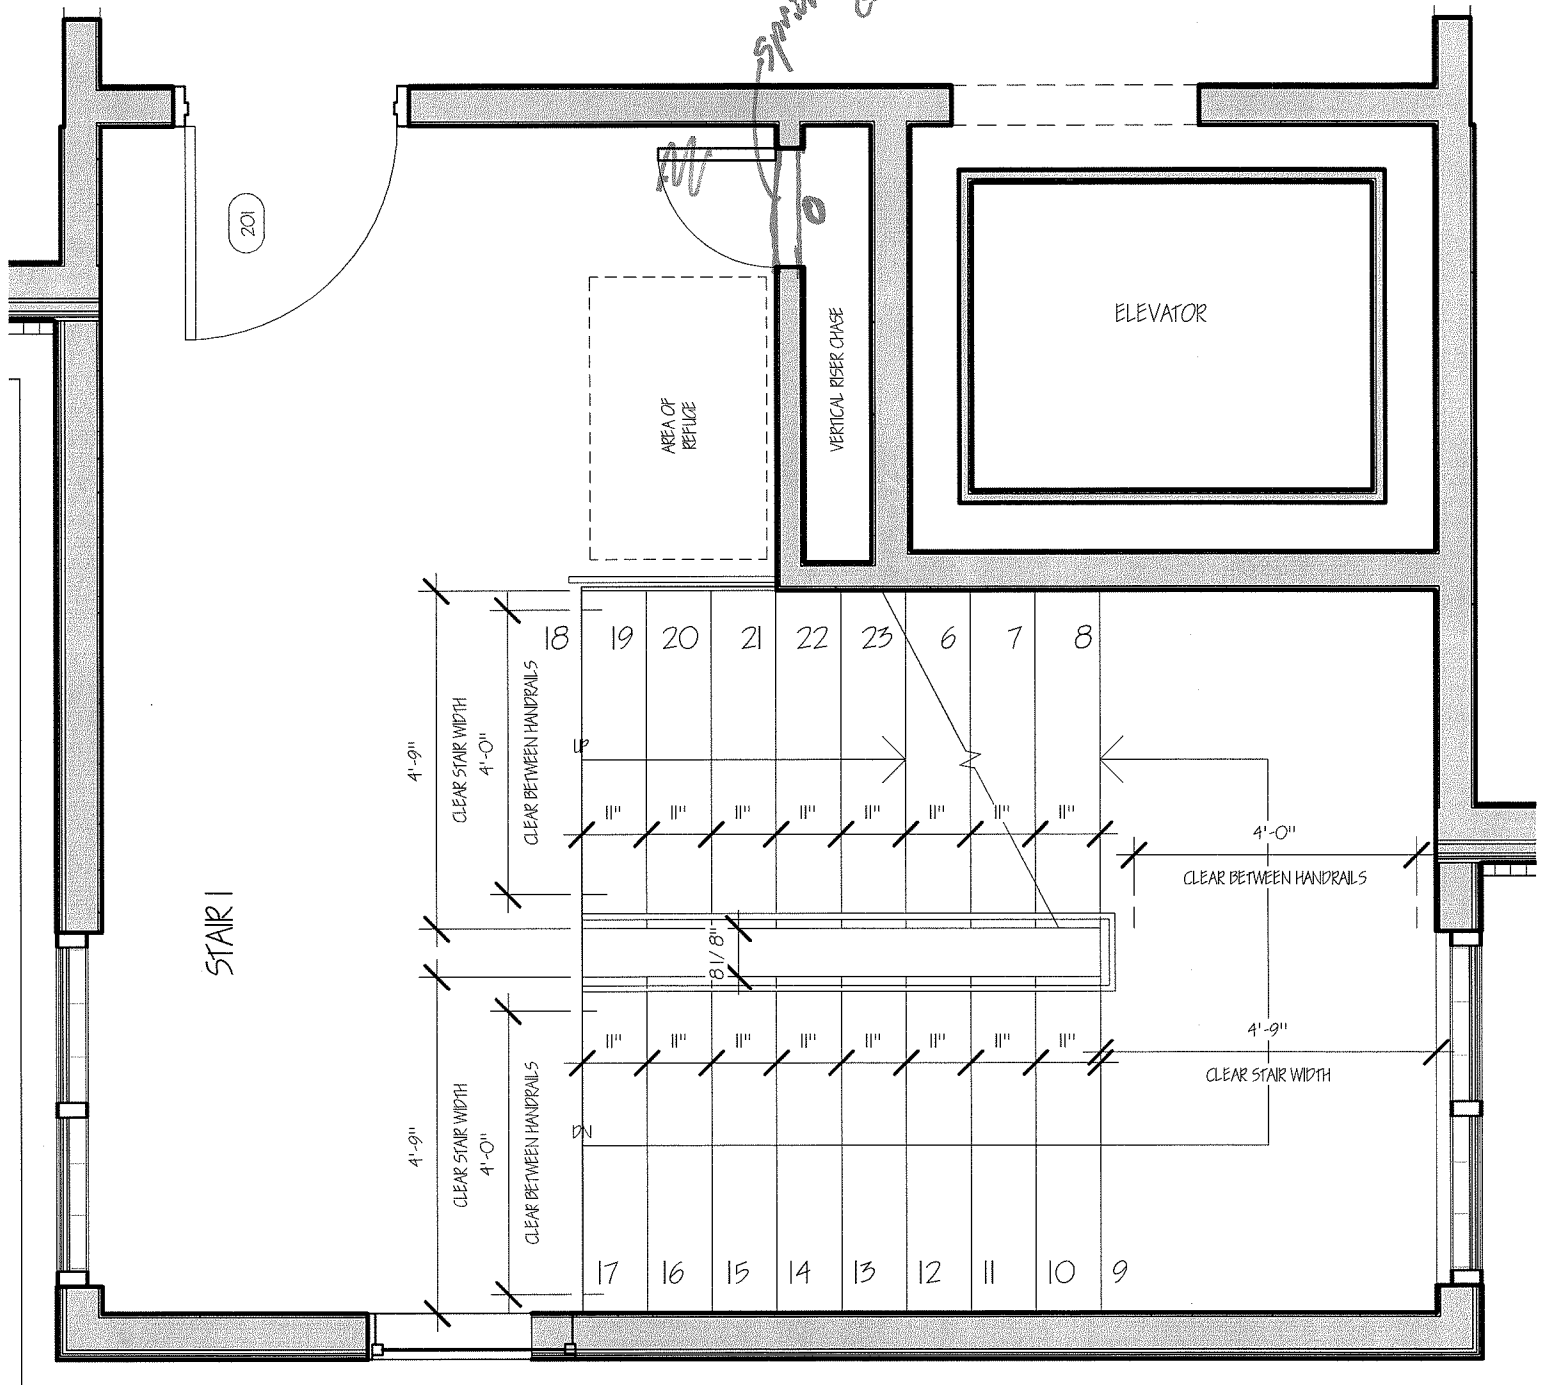

2 Stair 1 - Level 2
3/8" = 1'-0"

50% HANDRAIL IN ACCORDANCE WITH IBC 1021.5
MINIMUM CLEARANCE 11'-0"


FOR AS-BUILT PURPOSES ONLY
-DRAWINGS ARE ISSUED FOR CREATION OF AS-BUILT DRAWINGS ONLY
-DRAWINGS ISSUED WITHOUT 'RED-LINE' REVISION NOTATION MAY NOT BE CURRENT

GENERAL NOTES:

PROJECT NAME & ADDRESS:
PLYMOUTH ENTERPRISE CENTER
Creation County Economic Development Council
Plymouth, New Hampshire

INTERIOR DETAILS - STAIR 1
A8.3

C:\Users\jpl\p\Projects\070113\070113.dwg - 07/01/13 10:00 AM - 10/11/13

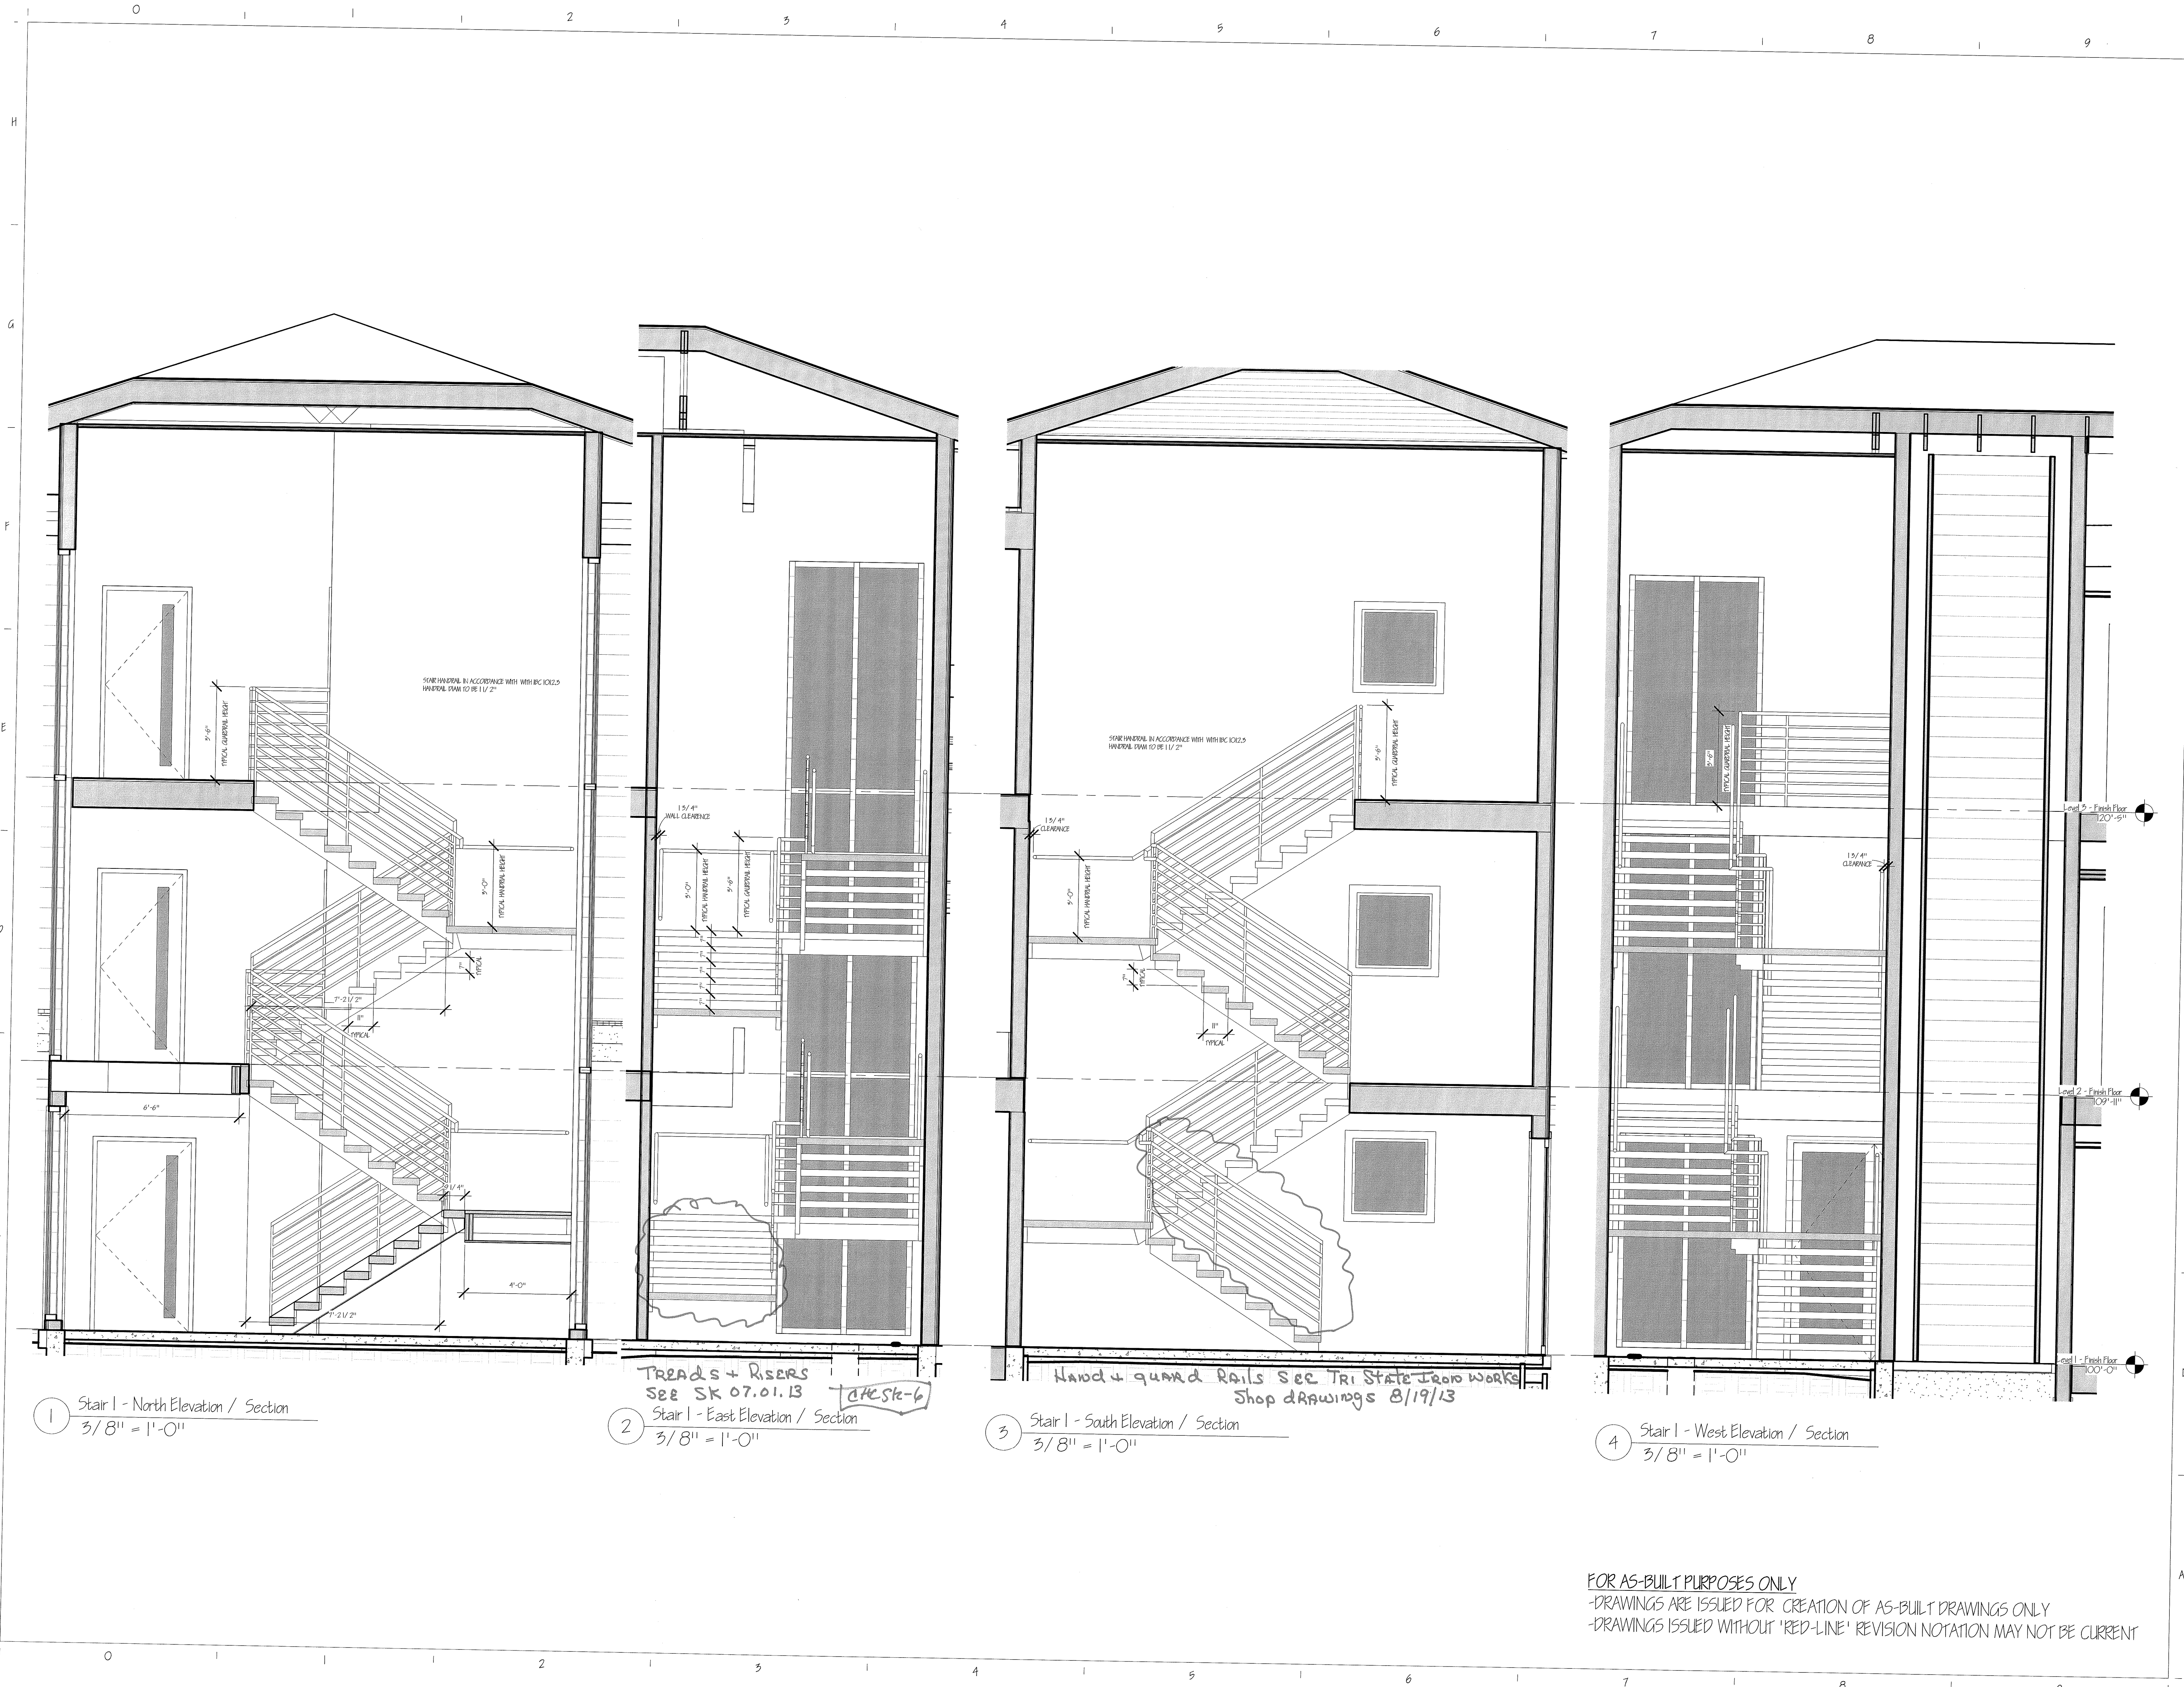

1 Stair 1 - North Elevation / Section
3/8" = 1'-0"

2 TREADS + RISERS SEE SK 07.01.13
Stair 1 - East Elevation / Section
3/8" = 1'-0" *atc sk-6*

3 Stair 1 - South Elevation / Section
3/8" = 1'-0"

4 Stair 1 - West Elevation / Section
3/8" = 1'-0"


Hand + Guard RAILS SEE Tri State Iron Works Shop drawings 8/19/13

FOR AS-BUILT PURPOSES ONLY
-DRAWINGS ARE ISSUED FOR CREATION OF AS-BUILT DRAWINGS ONLY
-DRAWINGS ISSUED WITHOUT 'RED-LINE' REVISION NOTATION MAY NOT BE CURRENT


GENERAL NOTES:

PROJECT NAME & ADDRESS:
PLYMOUTH ENTERPRISE CENTER
Grafton County Economic Development Council
Plymouth, New Hampshire


INTERIOR DETAILS - STAIR 1
A 8.4

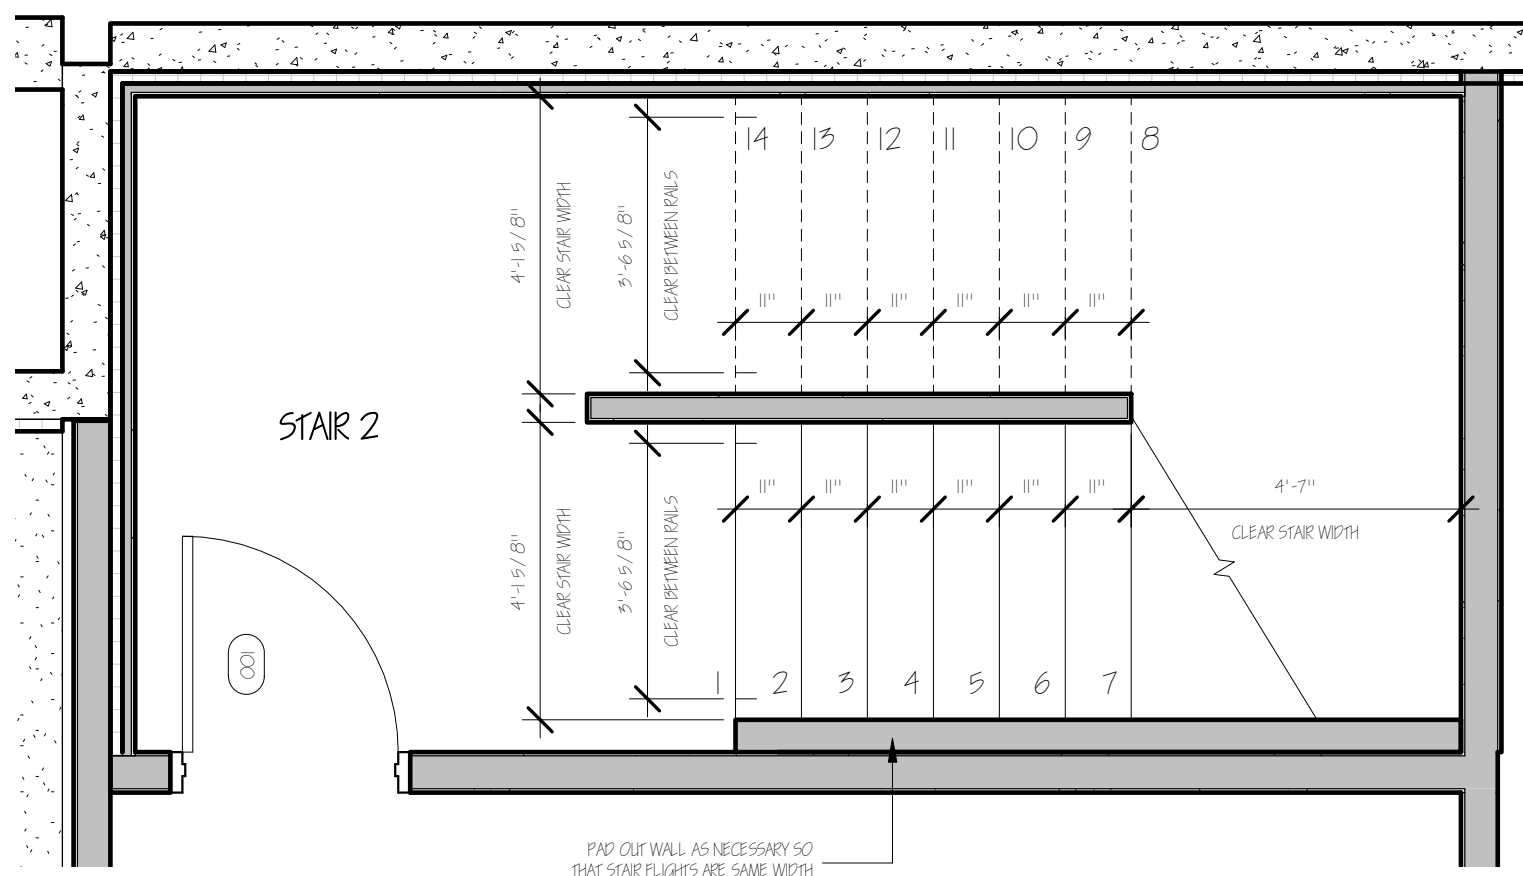


1 Stair 2 - Basement Level
 3/8" = 1'-0"

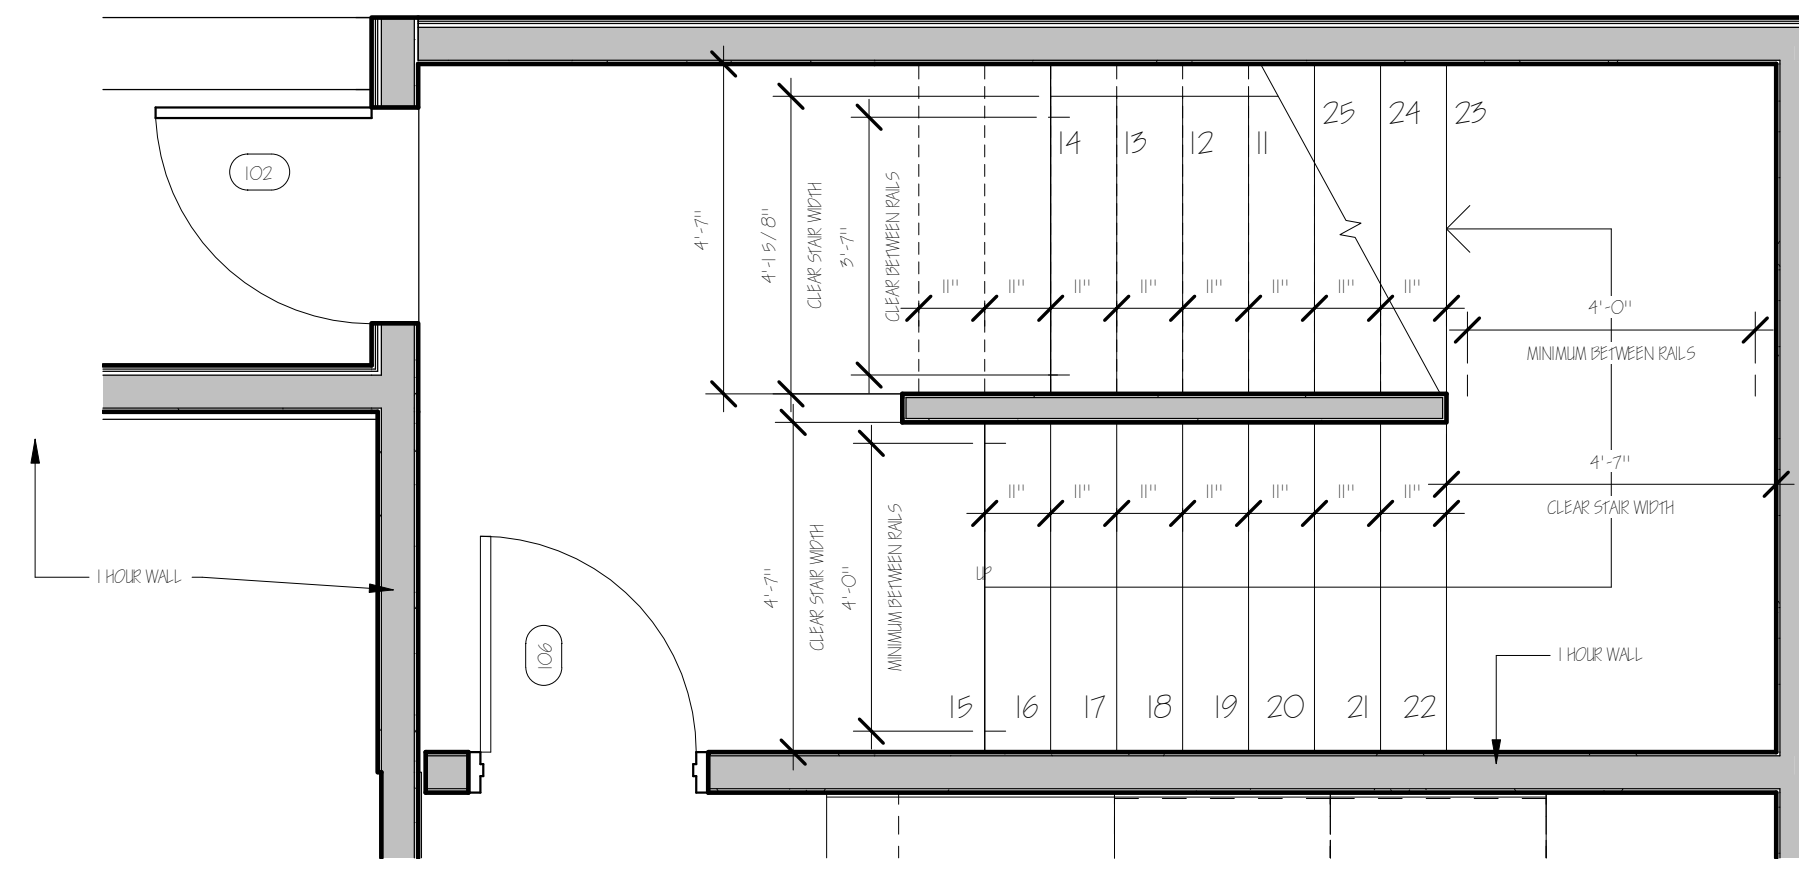


2 Stair 2 - Level 1
 3/8" = 1'-0"

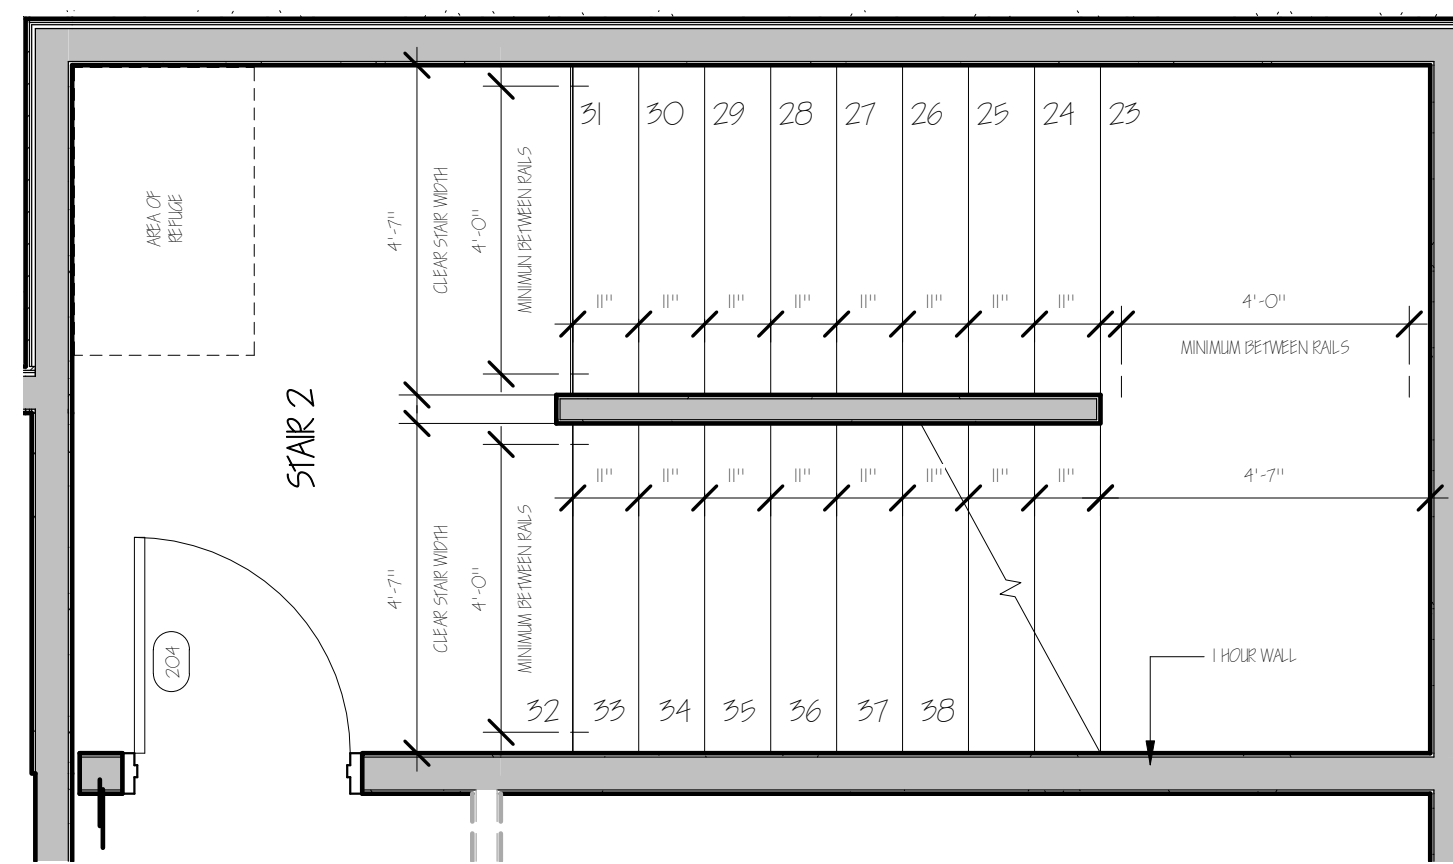

3 Stair 2 - Level 2
 3/8" = 1'-0"

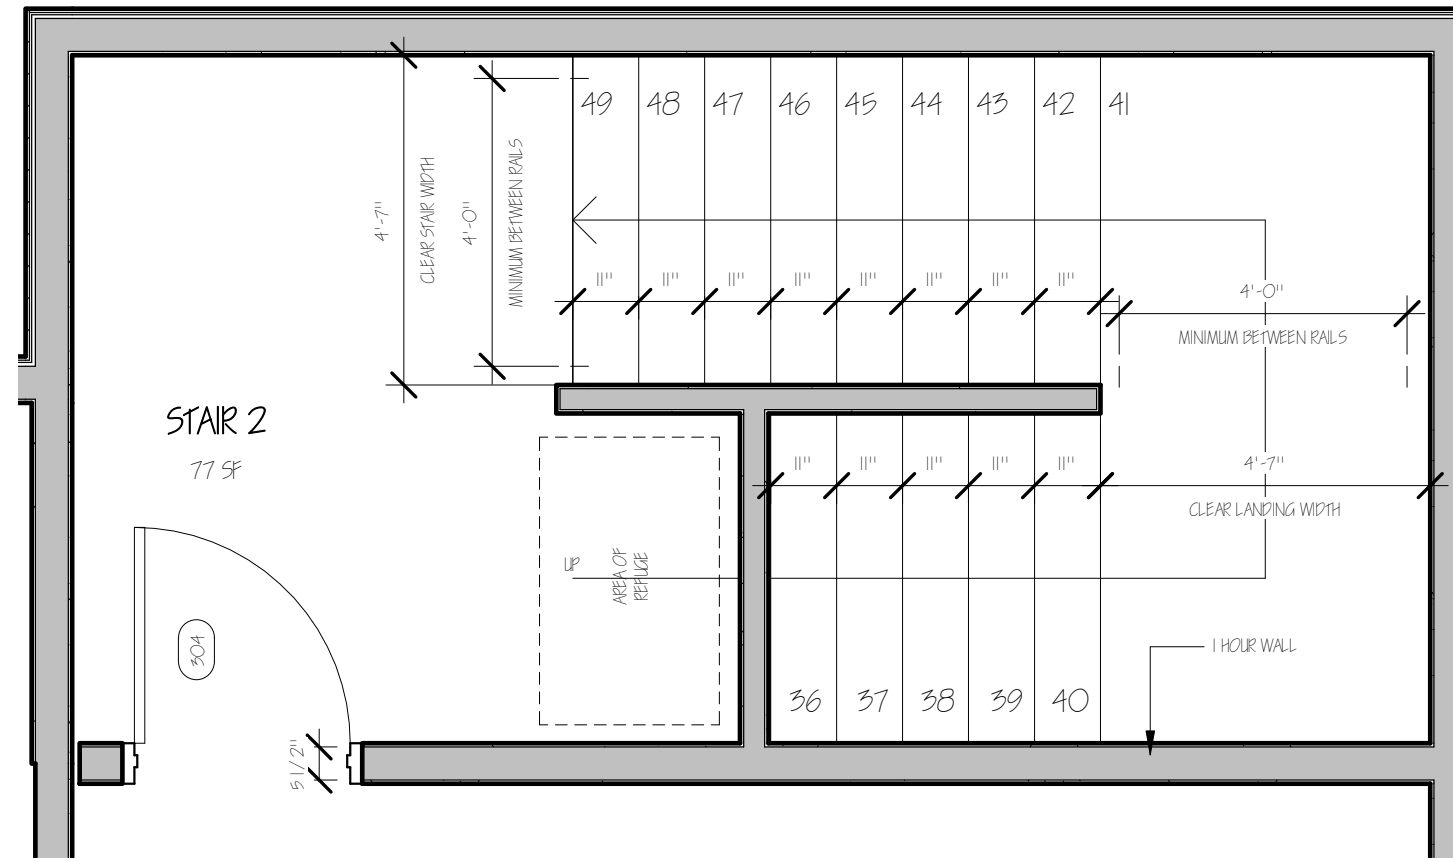

4 Stair 2 - Level 3
 3/8" = 1'-0"

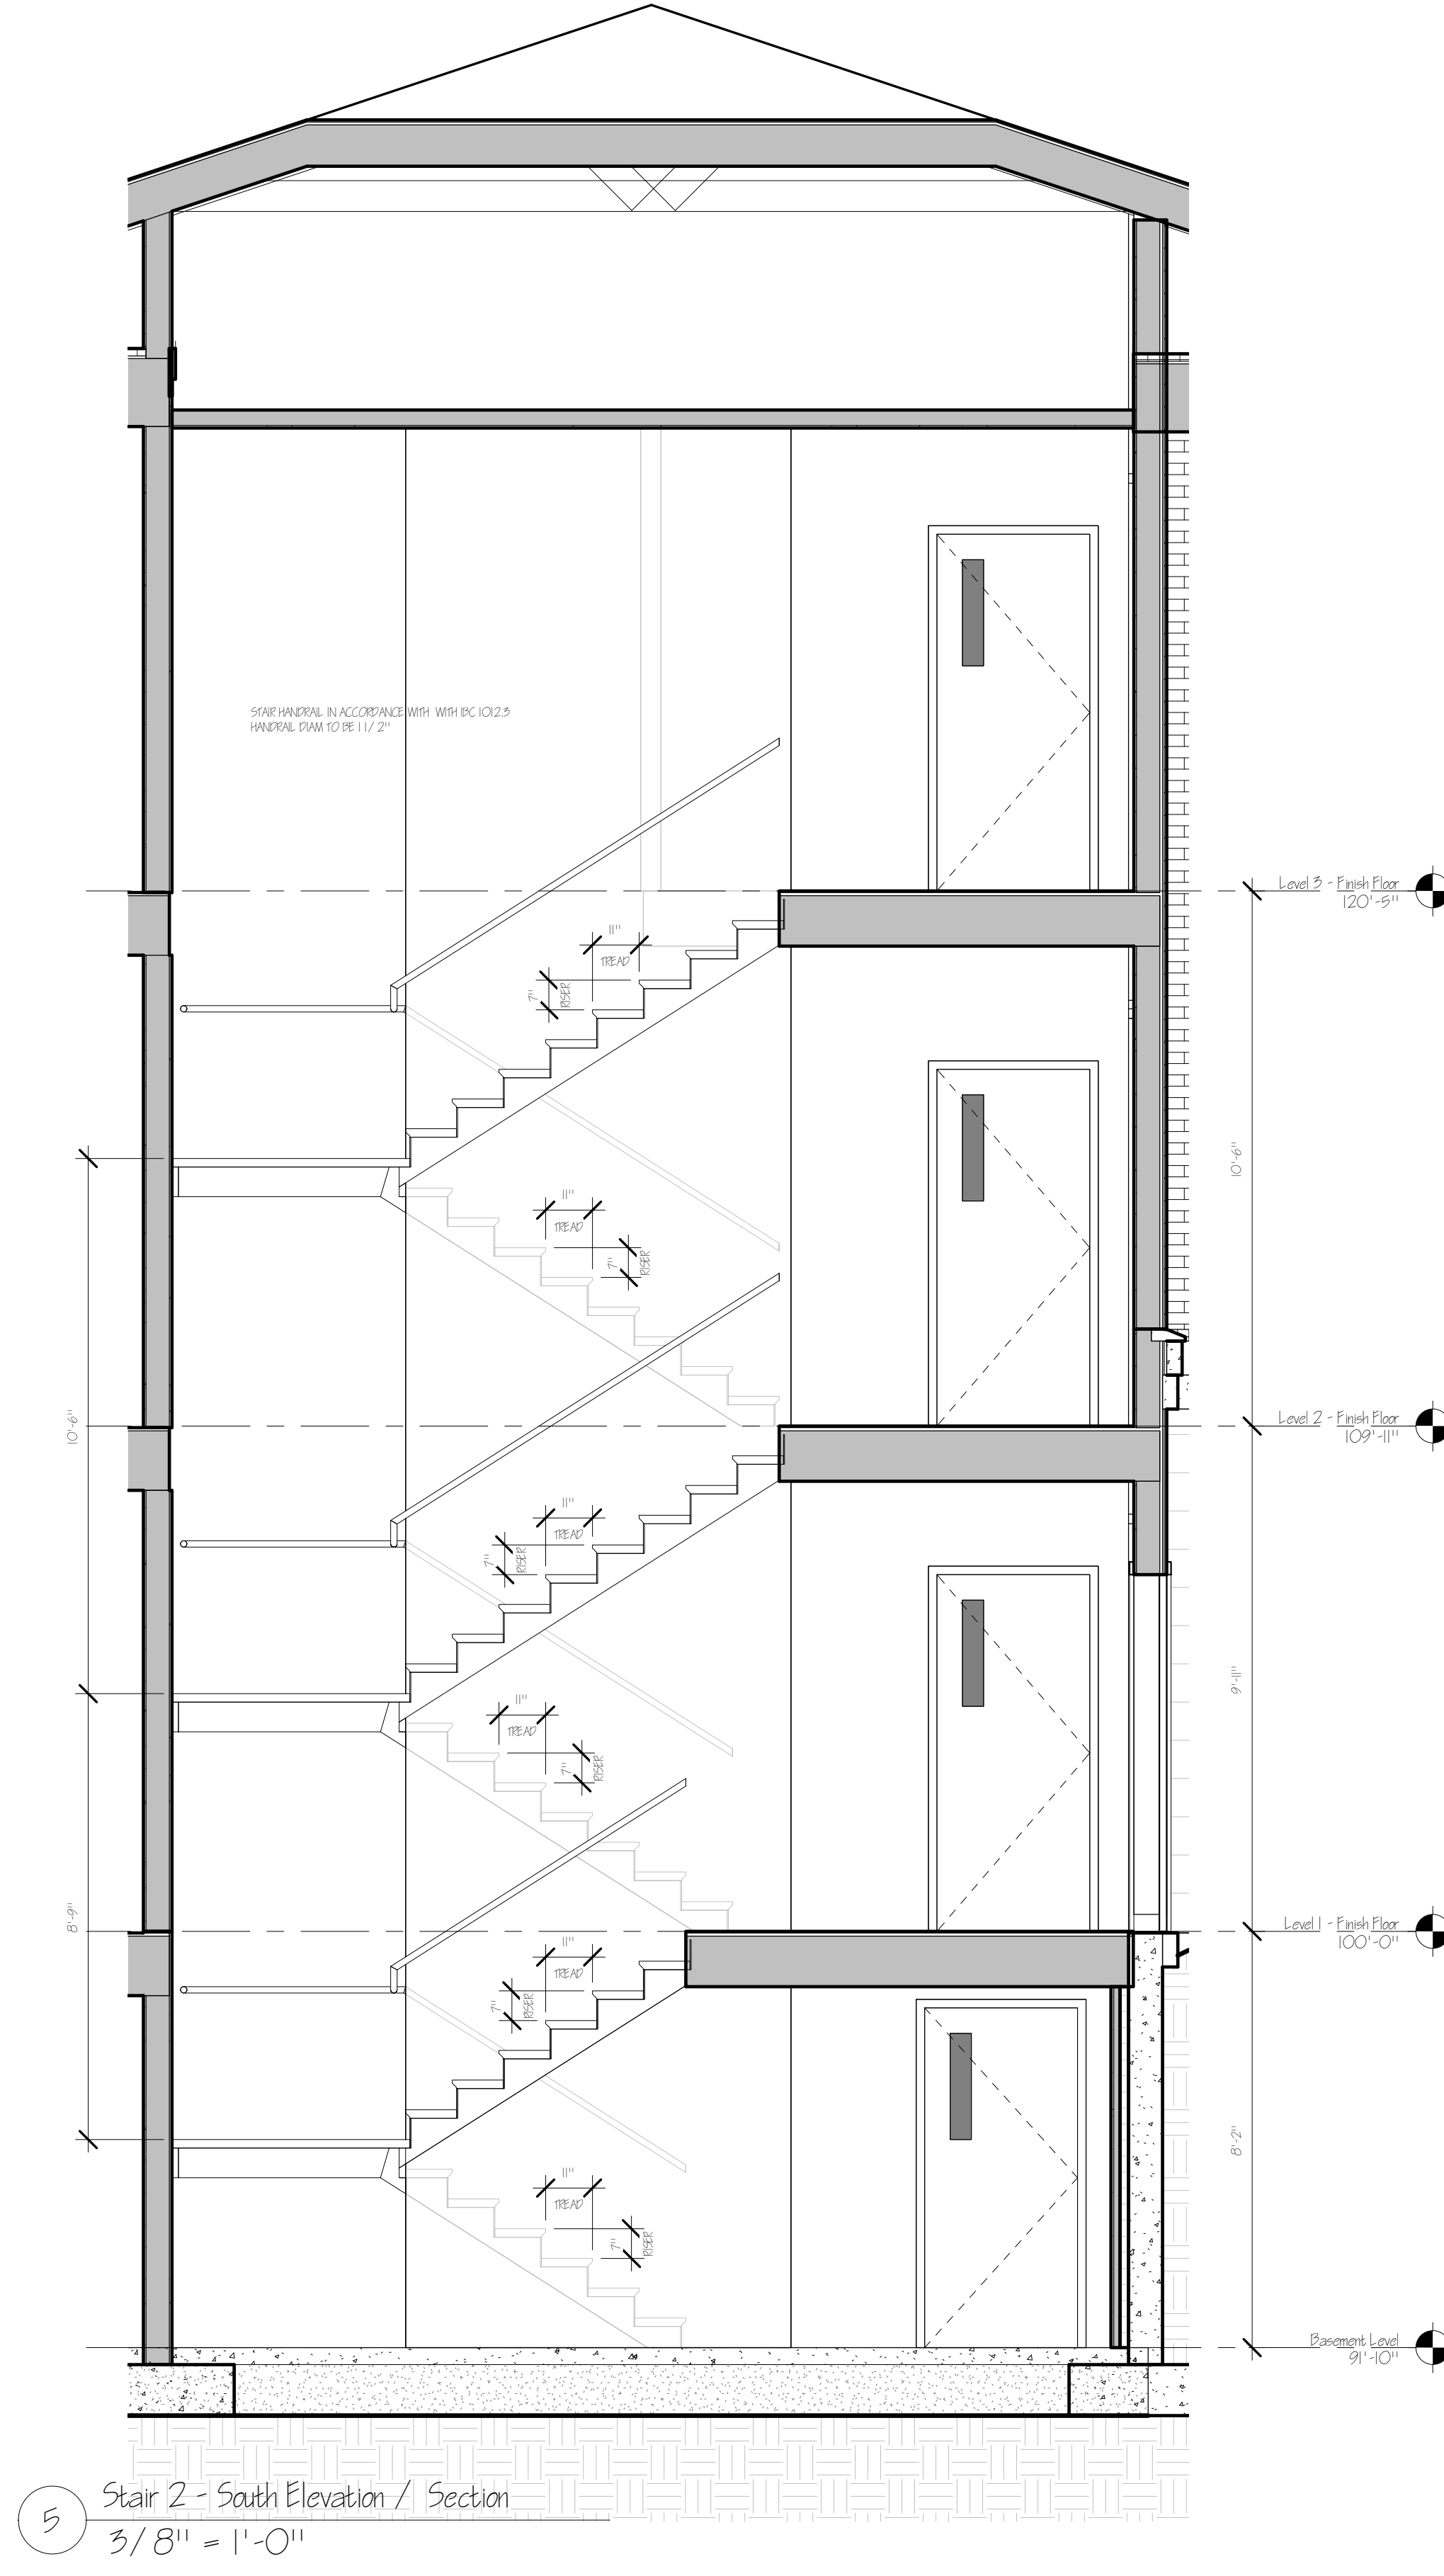

FOR AS-BUILT PURPOSES ONLY
 -DRAWINGS ARE ISSUED FOR CREATION OF AS-BUILT DRAWINGS ONLY
 -DRAWINGS ISSUED WITHOUT 'RED-LINE' REVISION NOTATION MAY NOT BE CURRENT

GENERAL NOTES:

PROJECT NAME & ADDRESS:
PLYMOUTH ENTERPRISE CENTER
 Grafton County Economic Development Council
 Plymouth, New Hampshire

INTERIOR DETAILS - STAIR 2 A.B.5

GENERAL NOTES:

Copyright 2013 Alba General

PROJECT NAME & ADDRESS:
 PLYMOUTH ENTERPRISE CENTER
 Gratton Grants Economic Development Council
 Plymouth, New Hampshire

SCHEDULES
 A 9.1

FOR AS-BUILT PURPOSES ONLY
 -DRAWINGS ARE ISSUED FOR CREATION OF AS-BUILT DRAWINGS ONLY
 -DRAWINGS ISSUED WITHOUT 'RED-LINE' REVISION NOTATION MAY NOT BE CURRENT

Room Finish Schedule											
Level	Name	Area	Floor			Wall		Ceiling		Crown	Comments
			Floor Material	Floor Finish	Base Finish	Wall Material	Wall Finish	Ceiling Material	Ceiling Finish		
Basement Level	BASEMENT HALL	159 SF	Concrete	Sealer	-	Exposed Studs / Sheetrock	- / Painted	Exposed Structure	-	-	
Basement Level	ELEV MACHINE	59 SF	Concrete	Sealer	-	Sheetrock	Painted	Sheetrock	-	-	
Basement Level	ELEV PIT	49 SF	Concrete	Sealer	-	Sheetrock	Painted	Sheetrock	-	-	
Basement Level	MECH	509 SF	Concrete	Sealer	-	Plowwood	Painted	Sheetrock	Painted	-	
Basement Level	STAR 2	165 SF	Concrete	Sealer	Rubber Cove	Sheetrock	Painted	Sheetrock	-	-	
Basement Level	TENANT STORAGE	1193 SF	Concrete	Sealer	-	Exposed Studs / Exposed Insulation	-	Exposed Structure	-	-	
Basement Level 6		2015 SF									
Level 1 - Fresh Floor	ADA WC	46 SF	VCT	Sealer	Rubber Cove	Plowboard	Painted	2 x 2 Dropped Tile	-	-	
Level 1 - Fresh Floor	ADA WC	46 SF	VCT	Sealer	Rubber Cove	Plowboard	Painted	2 x 2 Dropped Tile	-	-	
Level 1 - Fresh Floor	CIRCULATION	559 SF	VCT	Sealer	Rubber Cove	Sheetrock	Painted	2 x 2 Dropped Tile	-	-	
Level 1 - Fresh Floor	CONFERENCE	470 SF	Exposed Sheathing	-	-	Exposed Studs	-	Exposed Structure	-	-	
Level 1 - Fresh Floor	ENTRY / STAIR 1	259 SF	VCT	Sealer	Rubber Cove	Sheetrock	Painted	-	-	-	
Level 1 - Fresh Floor	FOCUS & OFFICE	469 SF	Exposed Sheathing	-	-	Exposed Studs	-	Exposed Structure	-	-	
Level 1 - Fresh Floor	INCUBATOR OFFICE 1	1226 SF	Exposed Sheathing	-	-	Exposed Studs	-	Exposed Structure	-	-	
Level 1 - Fresh Floor	JAN	19 SF	VCT	Sealer	Rubber Cove	Plowboard	Painted	2 x 2 Dropped Tile	-	-	rubber tread
Level 1 - Fresh Floor	KITCHEN	107 SF	VCT	Sealer	Rubber Cove	Plowboard	Painted	2 x 2 Dropped Tile	-	-	
Level 1 - Fresh Floor	MECH	59 SF	Exposed Sheathing	-	-	Plowwood	Painted	Exposed Structure	-	-	rubber tread
Level 1 - Fresh Floor 10		5011 SF									
Level 2 - Fresh Floor	ADA WC	46 SF	Exposed Sheathing	-	-	-	-	Exposed Structure	-	-	
Level 2 - Fresh Floor	ADA WC	46 SF	Exposed Sheathing	-	-	-	-	Exposed Structure	-	-	
Level 2 - Fresh Floor	CIRCULATION	272 SF	Exposed Sheathing	-	-	Exposed Studs	-	Exposed Structure	-	-	
Level 2 - Fresh Floor	MECH	60 SF	Exposed Sheathing	-	-	Plowwood	Painted	Exposed Structure	-	-	
Level 2 - Fresh Floor	RENTED SPACE-EAST	1226 SF	Exposed Sheathing	-	-	Exposed Studs	-	Exposed Structure	-	-	walls finish core side only
Level 2 - Fresh Floor	RENTED SPACE-WEST	999 SF	Exposed Sheathing	-	-	Exposed Studs	-	Exposed Structure	-	-	walls finish core side only
Level 2 - Fresh Floor	STAR 1	259 SF	VCT	Sealer	Rubber Cove	Sheetrock	Painted	-	-	-	rubber tread
Level 2 - Fresh Floor	STAR 2	178 SF	VCT	Sealer	Rubber Cove	Sheetrock	Painted	-	-	-	rubber tread
Level 2 - Fresh Floor 8		5022 SF									
Level 5 - Fresh Floor	ADA WC	46 SF	VCT	Sealer	Rubber Cove	Plowboard	Painted	2 x 2 Dropped Tile	-	-	
Level 5 - Fresh Floor	ADA WC	46 SF	VCT	Sealer	Rubber Cove	Plowboard	Painted	2 x 2 Dropped Tile	-	-	
Level 5 - Fresh Floor	ANCHOR TENANT	2622 SF	Exposed Sheathing	-	-	Exposed Studs	-	Exposed Structure	-	-	
Level 5 - Fresh Floor	MECH	60 SF	Exposed Sheathing	-	-	Plowwood	Painted	Exposed Structure	-	-	
Level 5 - Fresh Floor	STAR 1	259 SF	VCT	Sealer	Rubber Cove	Sheetrock	Painted	Sheetrock	Painted	-	rubber tread
Level 5 - Fresh Floor	STAR 2	77 SF	VCT	Sealer	Rubber Cove	Sheetrock	Painted	Sheetrock	Painted	-	rubber tread
Level 5 - Fresh Floor 6		3106 SF									
Grand total: 50		11894 SF									

Window Schedule																				
Mark	Manufacturer	Model	Operation	Frame Size		Jamb Depth	Head Height	Ext. Material	Exterior			Interior			Glass		Hardware		Comments	Count
				Width	Height				Ext. Color	Ext. Finish	Int. Material	Int. Color	Int. Finish	Glass Type	Divided Lites	Screen	Hardware Type	Hardware Finish		
101	Murvin Interiors	All Utrex	Fixed	5'-0"	5'-6"		8'-0"	Utrex	Brnze	-	Wood	-	Slam	LoE 566	see elevations	none	none	-	sheetrock returns / wood sill	17
102	Murvin Interiors	All Utrex	Fixed	5'-0"	5'-0"		8'-0"	Utrex	Brnze	-	Wood	-	Slam	LoE 566	see elevations	none	none	-	sheetrock returns / wood sill	5
103	Murvin Interiors	All Utrex	Fixed	5'-0"	5'-6"		8'-0"	Utrex	Brnze	-	Wood	-	Slam	LoE 566	see elevations	none	none	-	sheetrock returns / wood sill	1
104	Murvin Interiors	All Utrex	Fixed	5'-0"	4'-6"		7'-0"	Utrex	Brnze	-	Wood	-	Slam	LoE 566	see elevations	none	none	-	sheetrock returns / wood sill	52
105	Murvin Interiors	All Utrex	Fixed	5'-0"	5'-0"		7'-2"	Utrex	Brnze	-	Wood	-	Slam	LoE 566	see elevations	none	none	-	sheetrock returns / wood sill	8
Grand total: 61																				

FOR TENANT SPACE DOORS SEE COBB HILL DRAWING 8-12 A1.0

Door Schedule																					
Mark	Interior / Exterior	Room	Operation	Fire Rating	Egress Hardware Required	Manufacturer	Model	Door Size			Jamb Depth	Frame Material	Exterior			Interior			Hardware		Comments
								Width	Height	Door Size Thickness			Ext. Material	Ext. Color	Ext. Finish	Core	Int. Material	Int. Color	Int. Finish	Hardware Type	
Basement Level																					
001	Interior	Star 2	Single Swing	lfr	Yes			5'-0"	6'-8"	1 3/4"		Metal	Steed Skin		Painted	Honeycomb	Steed Skin		Painted		
002	Interior	Mechanical	Single Swing		No			5'-0"	6'-8"	1 3/4"		Metal	Steed Skin		Painted	Honeycomb	Steed Skin		Painted		
003	Interior	Elevator Machine	Single Swing	lfr	No			5'-0"	6'-8"	1 3/4"		Metal	Steed Skin		Painted	Honeycomb	Steed Skin		Painted		
004	Interior	Tenant Storage	Framed Opening		No			0"	0"												
115	Interior	Elevator Machine	Single Swing	lfr	No			5'-0"	6'-8"	1 3/4"		Metal	Steed Skin		Painted	Honeycomb	Steed Skin		Painted		
Level 1 - Fresh Floor																					
101	Exterior	Star 1	Double Swing		Yes			6'-0"	8'-0"	1 3/4"		Metal									
102	Exterior	Star 2	Single Swing		Yes			5'-0"	7'-0"	1 3/4"		Metal					Honeycomb				
103	Interior	Star 1	Single Swing		Yes			5'-6"	7'-0"	1 3/4"		Metal	Birch		Stained	Honeycomb	Birch		Stained		
104	Interior	Focus & Office	Single Swing		No			5'-6"	7'-0"	1 3/4"		Metal	Birch		Stained	Honeycomb	Birch		Stained		
105	Interior	Conference	Framed Opening		No			0"	0"												
106	Interior	Star 2	Single Swing	lfr	Yes			5'-0"	7'-0"	1 3/4"		Metal	Birch		Stained	Honeycomb	Steed Skin		Painted		
108	Interior	Mechanical	Single Swing		No			5'-0"	7'-0"	1 3/4"		Metal	Birch		Stained	Honeycomb	Birch		Stained		
109	Interior	ADA WC	Single Swing		No			5'-0"	7'-0"	1 3/4"		Metal	Birch		Stained	Honeycomb	Birch		Stained		
110	Interior	ADA WC	Single Swing		No			5'-0"	7'-0"	1 3/4"		Metal	Birch		Stained	Honeycomb	Birch		Stained		
111	Interior	Janitor	Single Swing		No			5'-0"	7'-0"	1 3/4"		Metal	Birch		Stained	Honeycomb	Birch		Stained		
112	Interior	Mechanical	Single Swing		No			5'-0"	7'-0"	1 3/4"		Metal	Birch		Stained	Honeycomb	Birch		Stained		
Level 2 - Fresh Floor																					
201	Interior	Star 1	Single Swing		Yes			5'-0"	7'-0"	1 3/4"		Metal	Birch		Stained	Honeycomb	Birch		Stained		
202	Interior	Rented Space West	Framed Opening		No			0"	0"												
203	Interior	Rented Space West	Framed Opening		No			0"	0"												
204	Interior	Star 2	Single Swing	lfr	Yes			5'-0"	7'-0"	1 3/4"		Metal	Birch		Stained	Honeycomb	Steed Skin		Painted		
Level 5 - Fresh Floor																					
501	Interior	Star 1	Single Swing		Yes			5'-0"	7'-0"	1 3/4"		Metal	Birch		Stained	Honeycomb	Birch		Stained		
502	Interior	Anchor Tenant	Framed Opening		No			0"	0"												
503	Interior	Anchor Tenant	Framed Opening		No			0"	0"												
504	Interior	Star 2	Single Swing	lfr	Yes			5'-0"	7'-0"	1 3/4"		Metal	Birch		Stained	Honeycomb	Steed Skin		Painted		
506	Interior	ADA WC	Single Swing		No			5'-0"	7'-0"	1 3/4"		Metal	Birch		Stained	Honeycomb	Birch		Stained		
507	Interior	ADA WC	Single Swing		No			5'-0"	7'-0"	1 3/4"		Metal	Birch		Stained	Honeycomb	Birch		Stained		
508	Interior	Mechanical	Single Swing		No			5'-0"	7'-0"	1 3/4"		Metal	Birch		Stained	Honeycomb	Steed Skin		Painted		